PLAT OF SURVEY
–OF–


LOT 1 OF CERTIFIED SURVEY MAP NO. 642, RECORDED IN VOLUME 3 OF CERTIFIED SURVEY MAPS, PAGE 122, BEING PART OF THE SOUTHWEST 1/4 OF THE SOUTHEAST 1/4 OF SECTION 17, TOWNSHIP 2 NORTH, RANGE 16 EAST. SAID LAND BEING IN THE CITY OF DELAVAN, COUNTY OF WALWORTH AND STATE OF WISCONSIN.

SURVEY FOR: BOB KUHN
SURVEY LOCATION: 436 S. WRIGHT ST.

SCALE: 1" = 60'

LEGEND
- ● FOUND IRON PIPE
- LIGHT POLE
- ( ) RECORDED AS

MONUMENTATION, EXCEPT AS SHOWN, BY WRITTEN AGREEMENT WITH THE ABOVE NAMED CLIENT HAS BEEN WAIVED IN ACCORDANCE A-E 7.01(2) OF THE WISCONSIN ADMINISTRATIVE CODE.

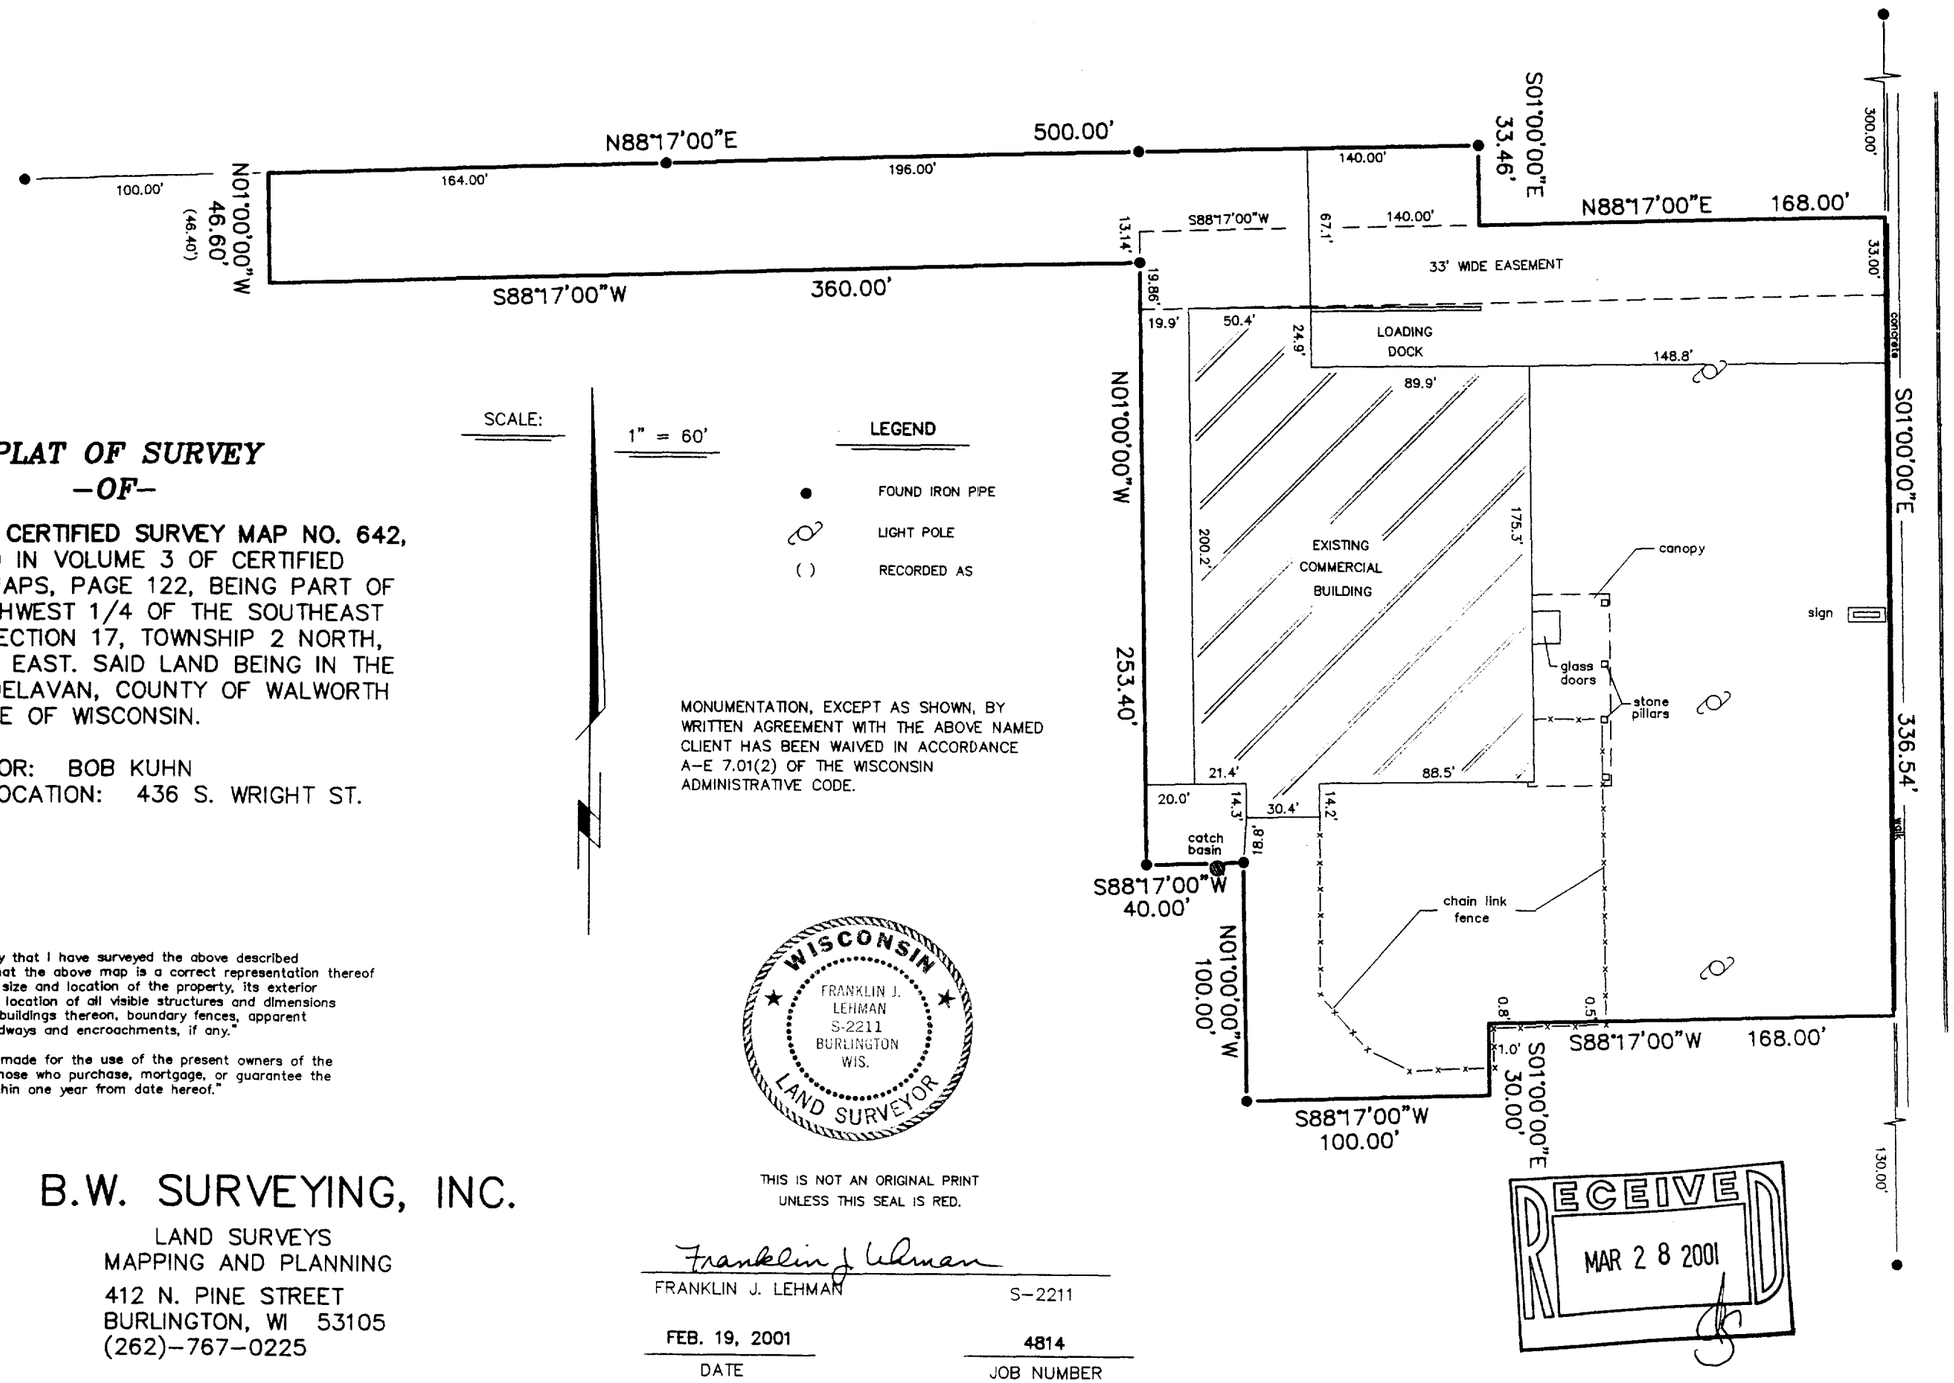

"I hereby certify that I have surveyed the above described property and that the above map is a correct representation thereof and shows the size and location of the property, its exterior boundaries, the location of all visible structures and dimensions of all principal buildings thereon, boundary fences, apparent easements, roadways and encroachments, if any."

"This survey is made for the use of the present owners of the property, and those who purchase, mortgage, or guarantee the title thereto within one year from date hereof."

WISCONSIN
FRANKLIN J. LEHMAN
S-2211
BURLINGTON WIS.
LAND SURVEYOR

THIS IS NOT AN ORIGINAL PRINT UNLESS THIS SEAL IS RED.

B.W. SURVEYING, INC.
LAND SURVEYS
MAPPING AND PLANNING
412 N. PINE STREET
BURLINGTON, WI 53105
(262)–767–0225

Franklin J. Lehman
FRANKLIN J. LEHMAN S-2211

FEB. 19, 2001 — DATE
4814 — JOB NUMBER

RECEIVED
MAR 2 8 2001

XA-642-1 002-1898