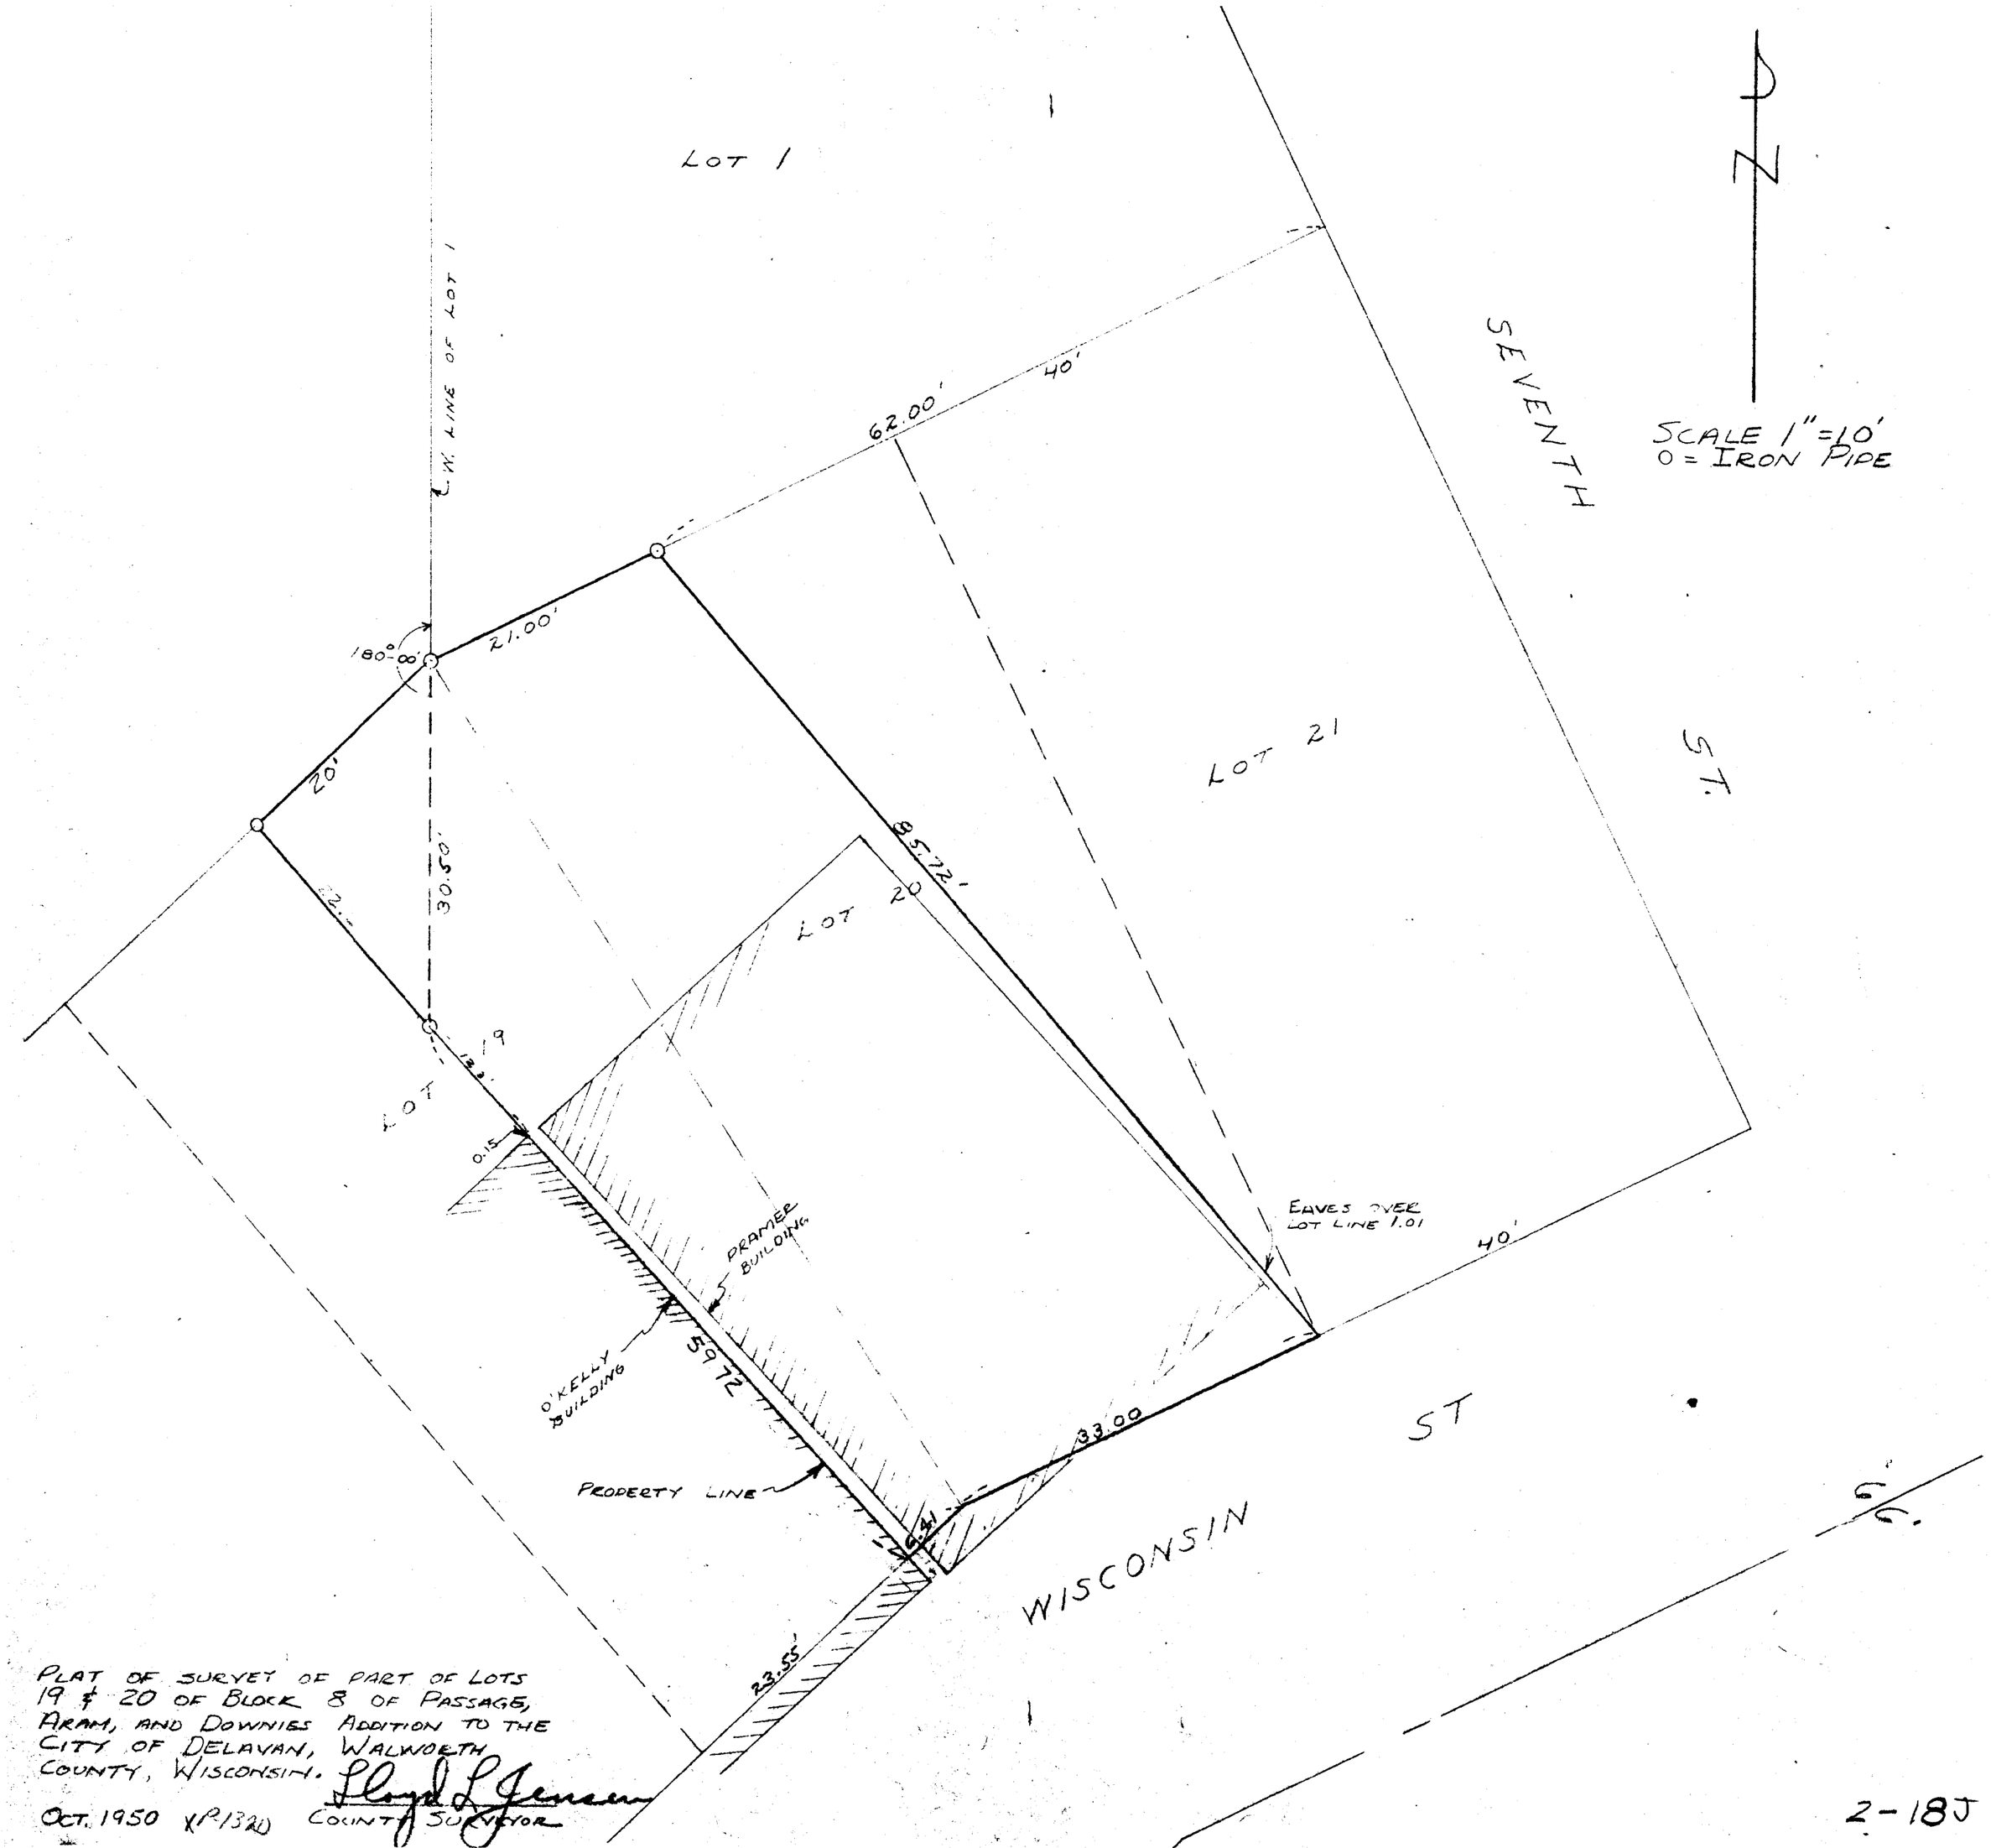

PLAT OF SURVEY OF PART OF LOTS 19 & 20 OF BLOCK 8 OF PASSAGE, ARAM, AND DOWNIES ADDITION TO THE CITY OF DELAVAN, WALWORTH COUNTY, WISCONSIN.

OCT. 1950 X(P/320) Floyd L. Jensen COUNTY SURVEYOR

2-18J