PREPARED FOR:
RAULAND AGENCY INC
118 KENOSHA ST.
P.O. BOX 159
WALWORTH, WI
53184


PLAT OF SURVEY

- OF -

J.K. SURVEYING INC.
N3705 WILLOWBEND LANE
LAKE GENEVA, WI, 53147
262-248-3697

LOT NO. 5 , BLOCK 1 IN SPRINGS PARK SUBDIVISION , A SUBDIVISION OF THE SW 1/4 OF SECTION 18 , T2N , R16E , ACCORDING TO THE RECORDED PLAT THEROF IN VOLUME 13 OF PLATS ON PAGE 50 , IN THE OFFICE OF THE REGISTER OF DEEDS IN AND FOR WALWORTH COUNTY , WISCONSIN . ALSO A PARCEL OF LAND LOCATED IN LOT 4, BLOCK 1 OF SPRINGS PARK SUBDIVSION , DESCRIBED AS FOLLOWS , TO- WIT : BEGINNING AT SE CORNER OF SAID LOT 4 ; THENCE S 79°07' WEST ALONG S'LY LINE OF SAID LOT 4 , 10.02 FEET ; THENCE N 14° 52' WEST PARALLEL WITH THE E'LY LINE OF SAID LOT 4 , 63.12 FEET ; THENCE N 7°25' WEST 77.19 FEET TO THE NE CORNER OF SAID LOT 4 ; THENCE S 14°52' EAST ALONG THE E'LY LINE OF SAID LOT 4 , 140.37 FEET TO THE PLACE OF BEGINNING . SAID LAND BEING IN THE CITY OF DELAVAN .

RECEIVED
2001

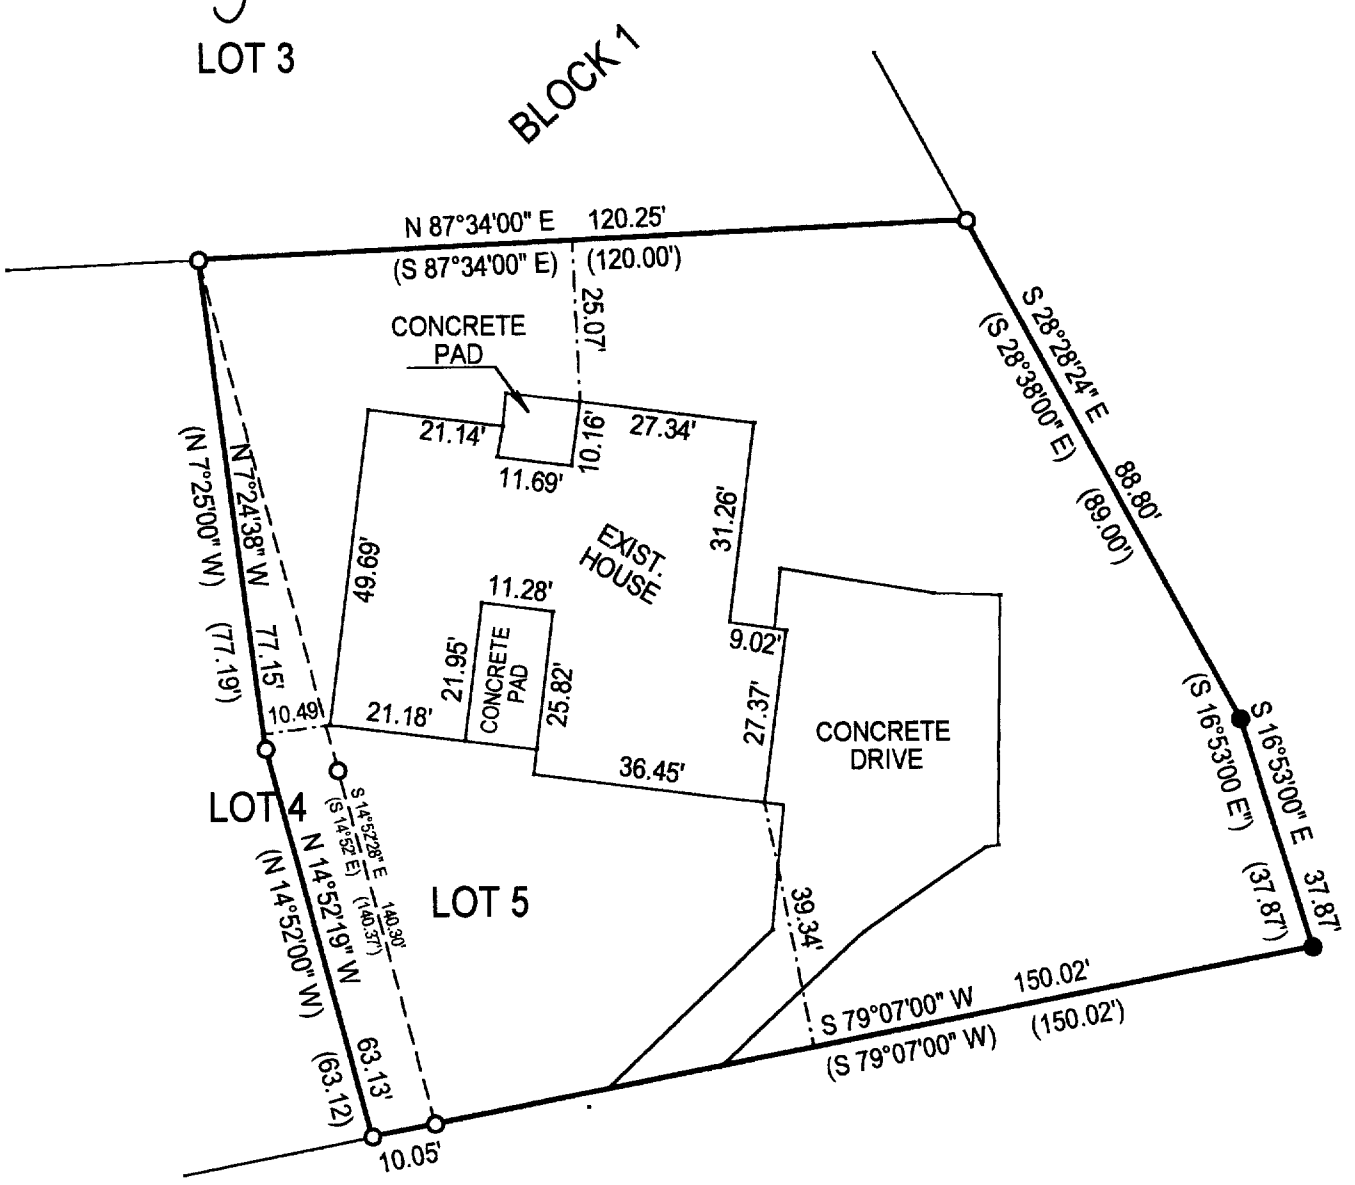

( )= recorded as

□ = found iron bar

○ = found iron pipe

● = set iron pipe

■ = set iron bar

SCALE 1" = 20'

JOB # 01-286

TAX ID # XSPS00005

COMPARE LEGAL DESCRIPTION ABOVE AND DRAWING WITH DEED. FOR BUILDING RESTRICTIONS AND EASEMENTS NOT SHOWN,REFER TO DEED, ABSTRACT SOURCES AND LOCAL MUNICIPAL CODES. NOTIFY THE SURVEYOR IMMEDIATELY OF ANY DISCREPANCY.

"I hereby certify that I have surveyed the above described property and that the above map is a true representation thereof and shows the size and location of all visible structures, apparent easements and encroachments if any."
This survey is made for the present owners of the property, and those who purchase, mortgage, or guarantee the title thereto, within one year from the date hereof.

DATED THIS 13TH, DAY OF AUGUST 2001 .

WISCONSIN
JOHN P. KROTT
S-2258
MUKWONAGO, WIS.
LAND SURVEYOR

JOHN KROTT S - 2258
Wisconsin Registered Land Surveyor
(original if signed in red)

002-1938