
PLAT OF SURVEY
–OF–

LOT 68, WHISPERING PINES SECOND ADDITION, BEING PART OF THE NORTHWEST 1/4 OF THE SOUTHEAST 1/4 OF SECTION 13, TOWN 2 NORTH, RANGE 15 EAST, IN THE CITY OF DELAVAN, COUNTY OF WALWORTH, STATE OF WISCONSIN.

SURVEY FOR: SOUTHEASTERN WISCONSIN HOUSING CORP.

PROPOSED ADDRESS: _____ WHISPERING PINES DRIVE

RECEIVED
DEC 2 0 2001

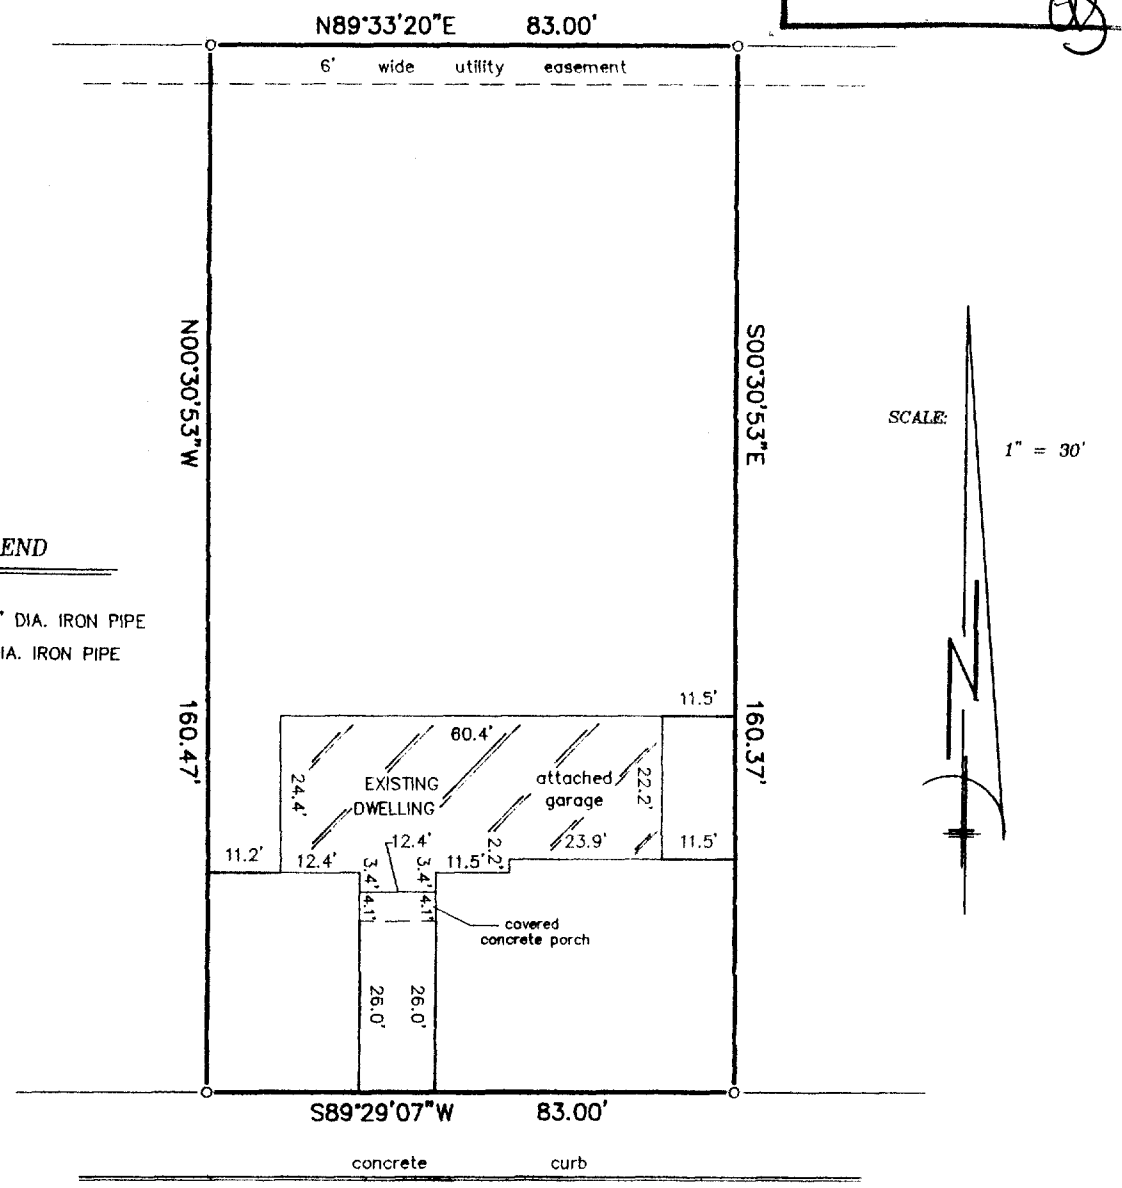

WHISPERING (66' WIDE) *PINES DRIVE*

LEGEND

o FOUND 1" DIA. IRON PIPE

● SET 1" DIA. IRON PIPE

"I hereby certify that I have surveyed the above described property and that the above map is a correct representation thereof and shows the size and location of the property, its exterior boundaries, the location of all visible structures and dimensions of all principal buildings thereon, boundary fences, apparent easements, roadways and encroachments, if any."

"This survey is made for the use of the present owners of the property, and those who purchase, mortgage, or guarantee the title thereto within one year from date hereof."

WISCONSIN
ROBERT J. WETZEL
S-1778
BURLINGTON WIS.
LAND SURVEYOR

THIS IS NOT AN ORIGINAL PRINT UNLESS THIS SEAL IS RED.



B.W. SURVEYING
412 N. PINE STREET
BURLINGTON, WI 53105
(414)–767–0225

Robert J. Wetzel
ROBERT J. WETZEL S–1778

OCTOBER 24, 2001 — DATE

4772 — JOB NUMBER

XWP2-15

2-1942