
3. The land referred to in this policy is situated in the County of Walworth, State of: Wisconsin, and is described as follows:
All that part of Outlot Two (2) in the ORIGINAL PLAT OF THE VILLAGE (NOW CITY) OF DELAVAN, being a part of Section Eighteen (18) Township Two (2) North, Range Sixteen (16) East, in the City of Delavan, bounded and described as follows, to-wit: Beginning at an iron stake 31.6 feet North of the South line of said Section 18 and 247 feet West of the West line of South Second Street in said City of Delavan; thence East 247 feet to an iron stake on the West line of South Second Street; thence North along the West line of South Second Street 142 feet to an iron stake; thence West at right angles with the West line of South Second Street 243.5 feet to the Southerly line of the right of way of Chicago, Milwaukee, and St. Paul Railway Company; thence Southwesterly along the Southerly line of said right of way 28 feet to an iron stake; thence Southeasterly 127.5 feet to the place of beginning.

BOUNDARY & TOPOGRAPHIC SURVEY

PART OF OUTLOT 2 IN THE ORIGINAL PLAT OF THE VILLAGE (NOW CITY) OF DELAVAN WALWORTH COUNTY, WISCONSIN

LEGEND
- O = FOUND IRON PIPE STAKE
- ● = SET IRON REBAR STAKE
- ◪ = SET NAIL IN PAVEMENT
- (XXX) = RECORDED AS

AREA SURVEYED = 35,815 S.F. (0.82 AC.)

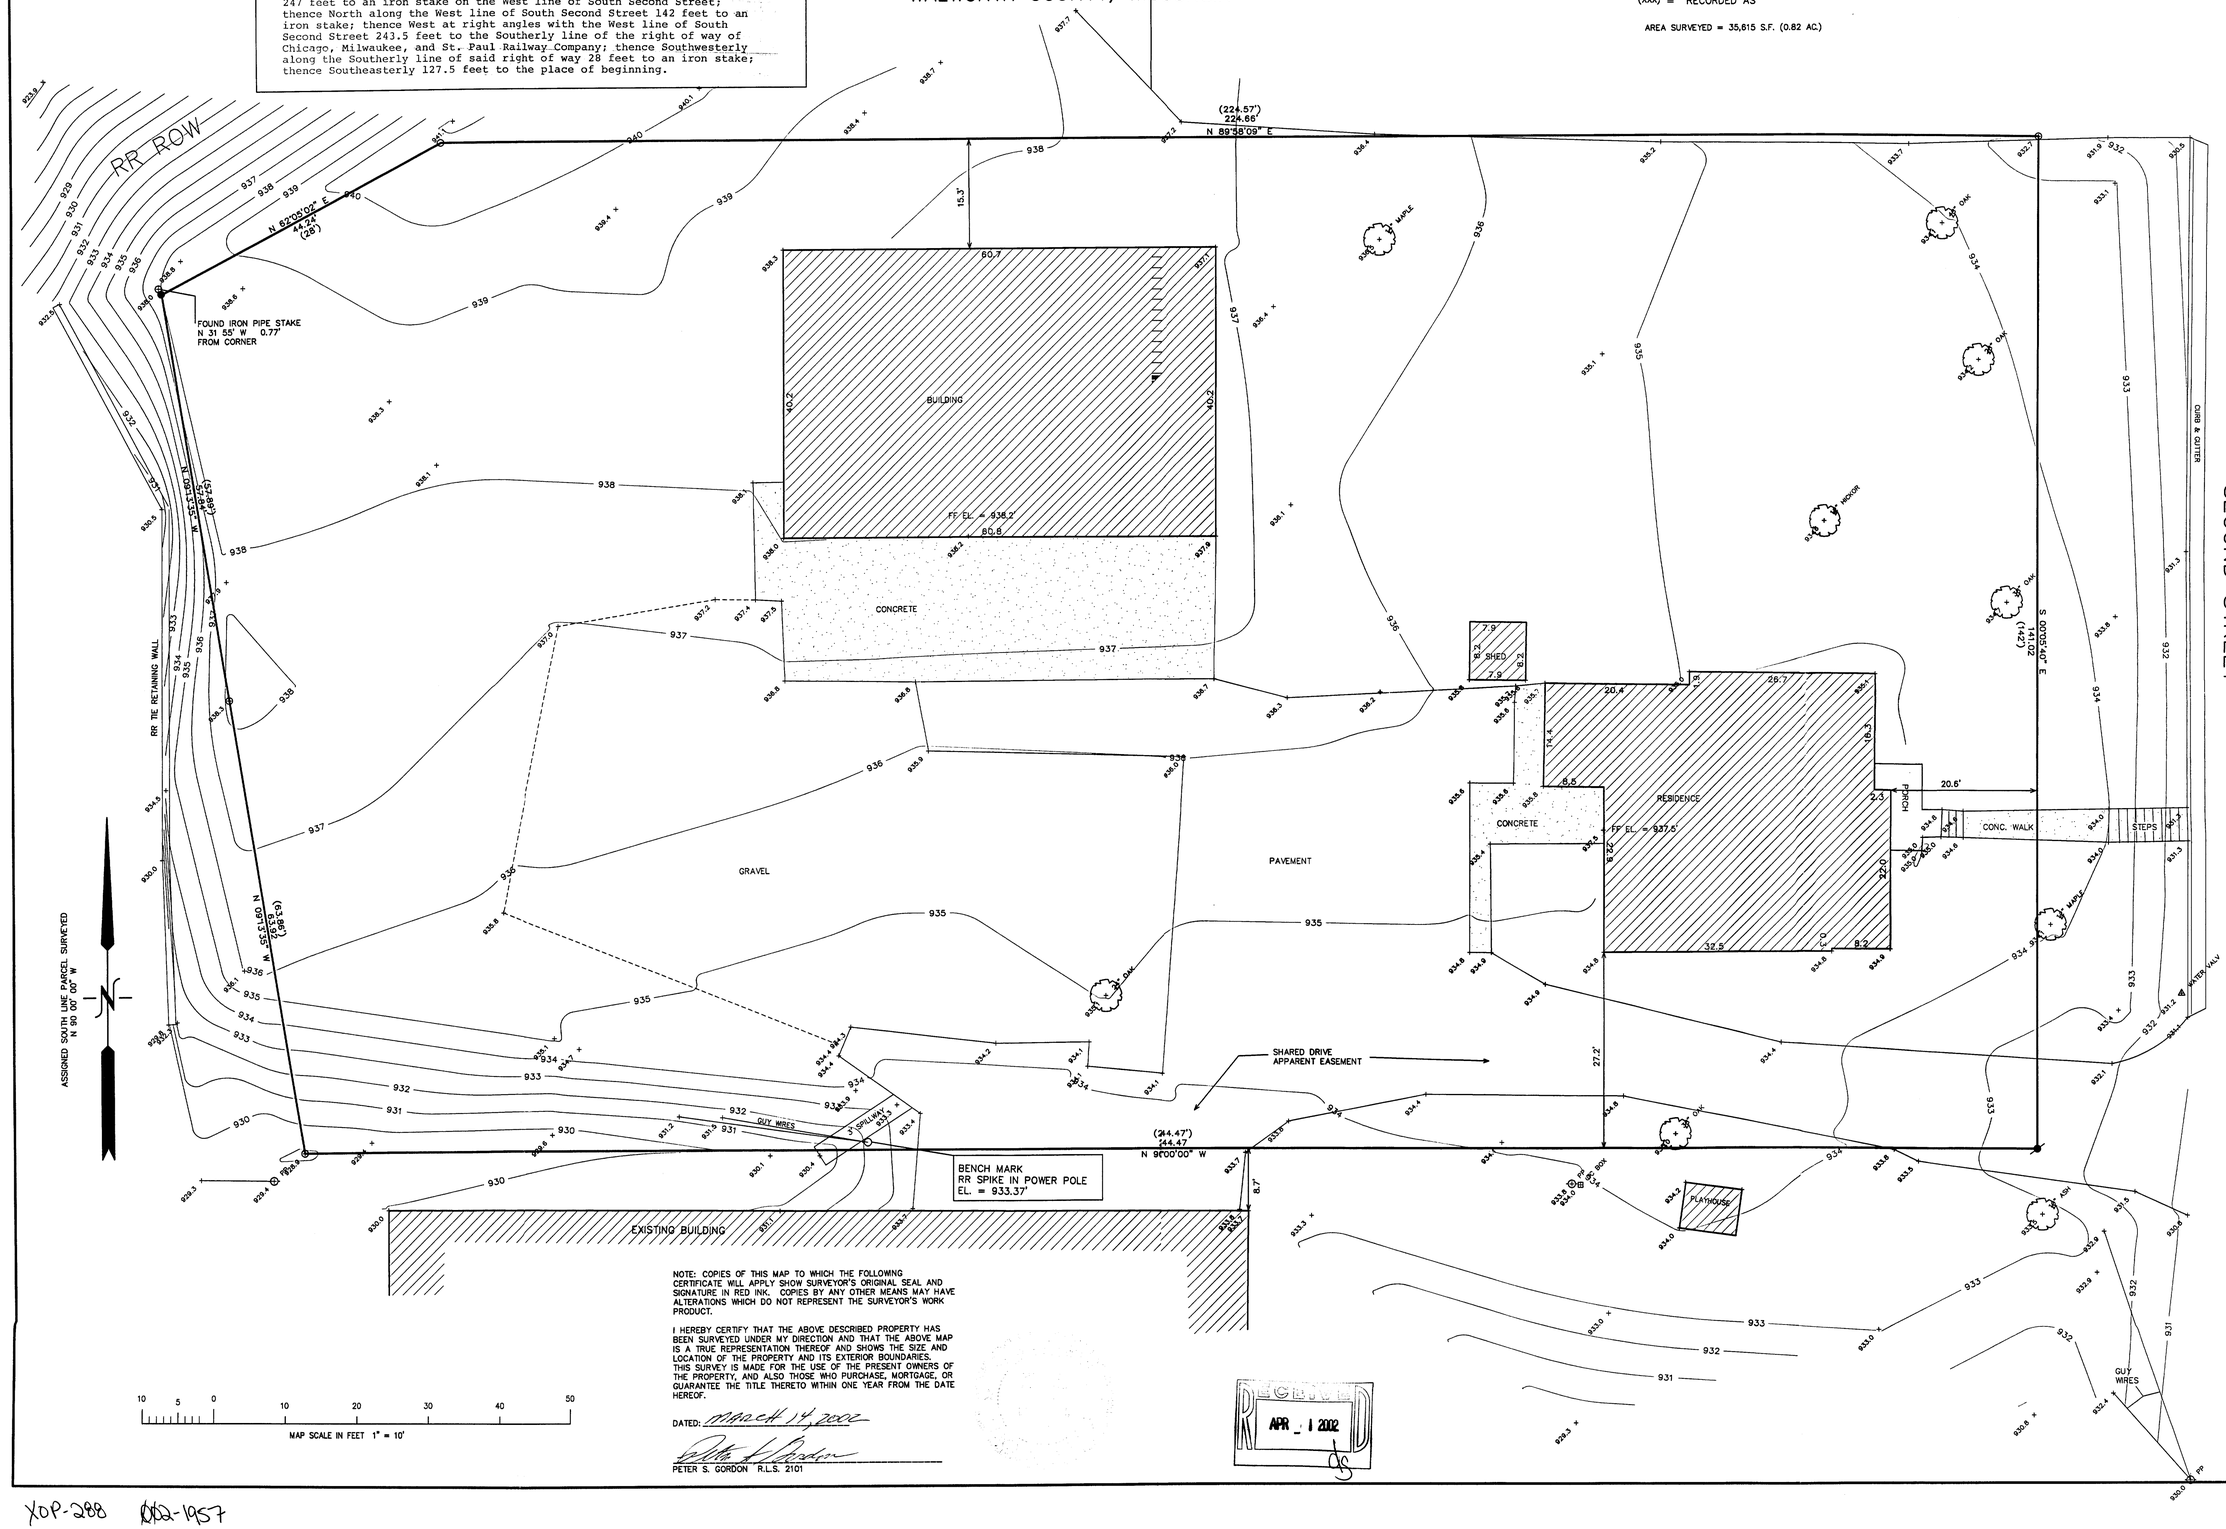

NOTE: COPIES OF THIS MAP TO WHICH THE FOLLOWING CERTIFICATE WILL APPLY SHOW SURVEYOR'S ORIGINAL SEAL AND SIGNATURE IN RED INK. COPIES BY ANY OTHER MEANS MAY HAVE ALTERATIONS WHICH DO NOT REPRESENT THE SURVEYOR'S WORK PRODUCT.

I HEREBY CERTIFY THAT THE ABOVE DESCRIBED PROPERTY HAS BEEN SURVEYED UNDER MY DIRECTION AND THAT THE ABOVE MAP IS A TRUE REPRESENTATION THEREOF AND SHOWS THE SIZE AND LOCATION OF THE PROPERTY AND ITS EXTERIOR BOUNDARIES. THIS SURVEY IS MADE FOR THE USE OF THE PRESENT OWNERS OF THE PROPERTY, AND ALSO THOSE WHO PURCHASE, MORTGAGE, OR GUARANTEE THE TITLE THERETO WITHIN ONE YEAR FROM THE DATE HEREOF.

DATED: March 14, 2002

PETER S. GORDON R.L.S. 2101

10 5 0 10 20 30 40 50
MAP SCALE IN FEET 1" = 10'

RECEIVED
APR - 1 2002

MAR 14 2002

XOP-288 XX2-1957

SECOND STREET

WORK ORDERED BY:
BURDICK TRUCKING
369 SUNSHINE AVE
DELAVAN, WI. 53115

FARRIS, HANSEN & ASSOCIATES, INC.
ENGINEERING – ARCHITECTURE – SURVEYING
7 RIDGWAY COURT P.O. BOX 437
ELKHORN, WISCONSIN 53121
OFFICE: (262) 723-2098 FAX: (262) 723-5886

REVISIONS

PROJECT NO. 5987
DATE 03-12-02
SHEET NO. 1 OF 1