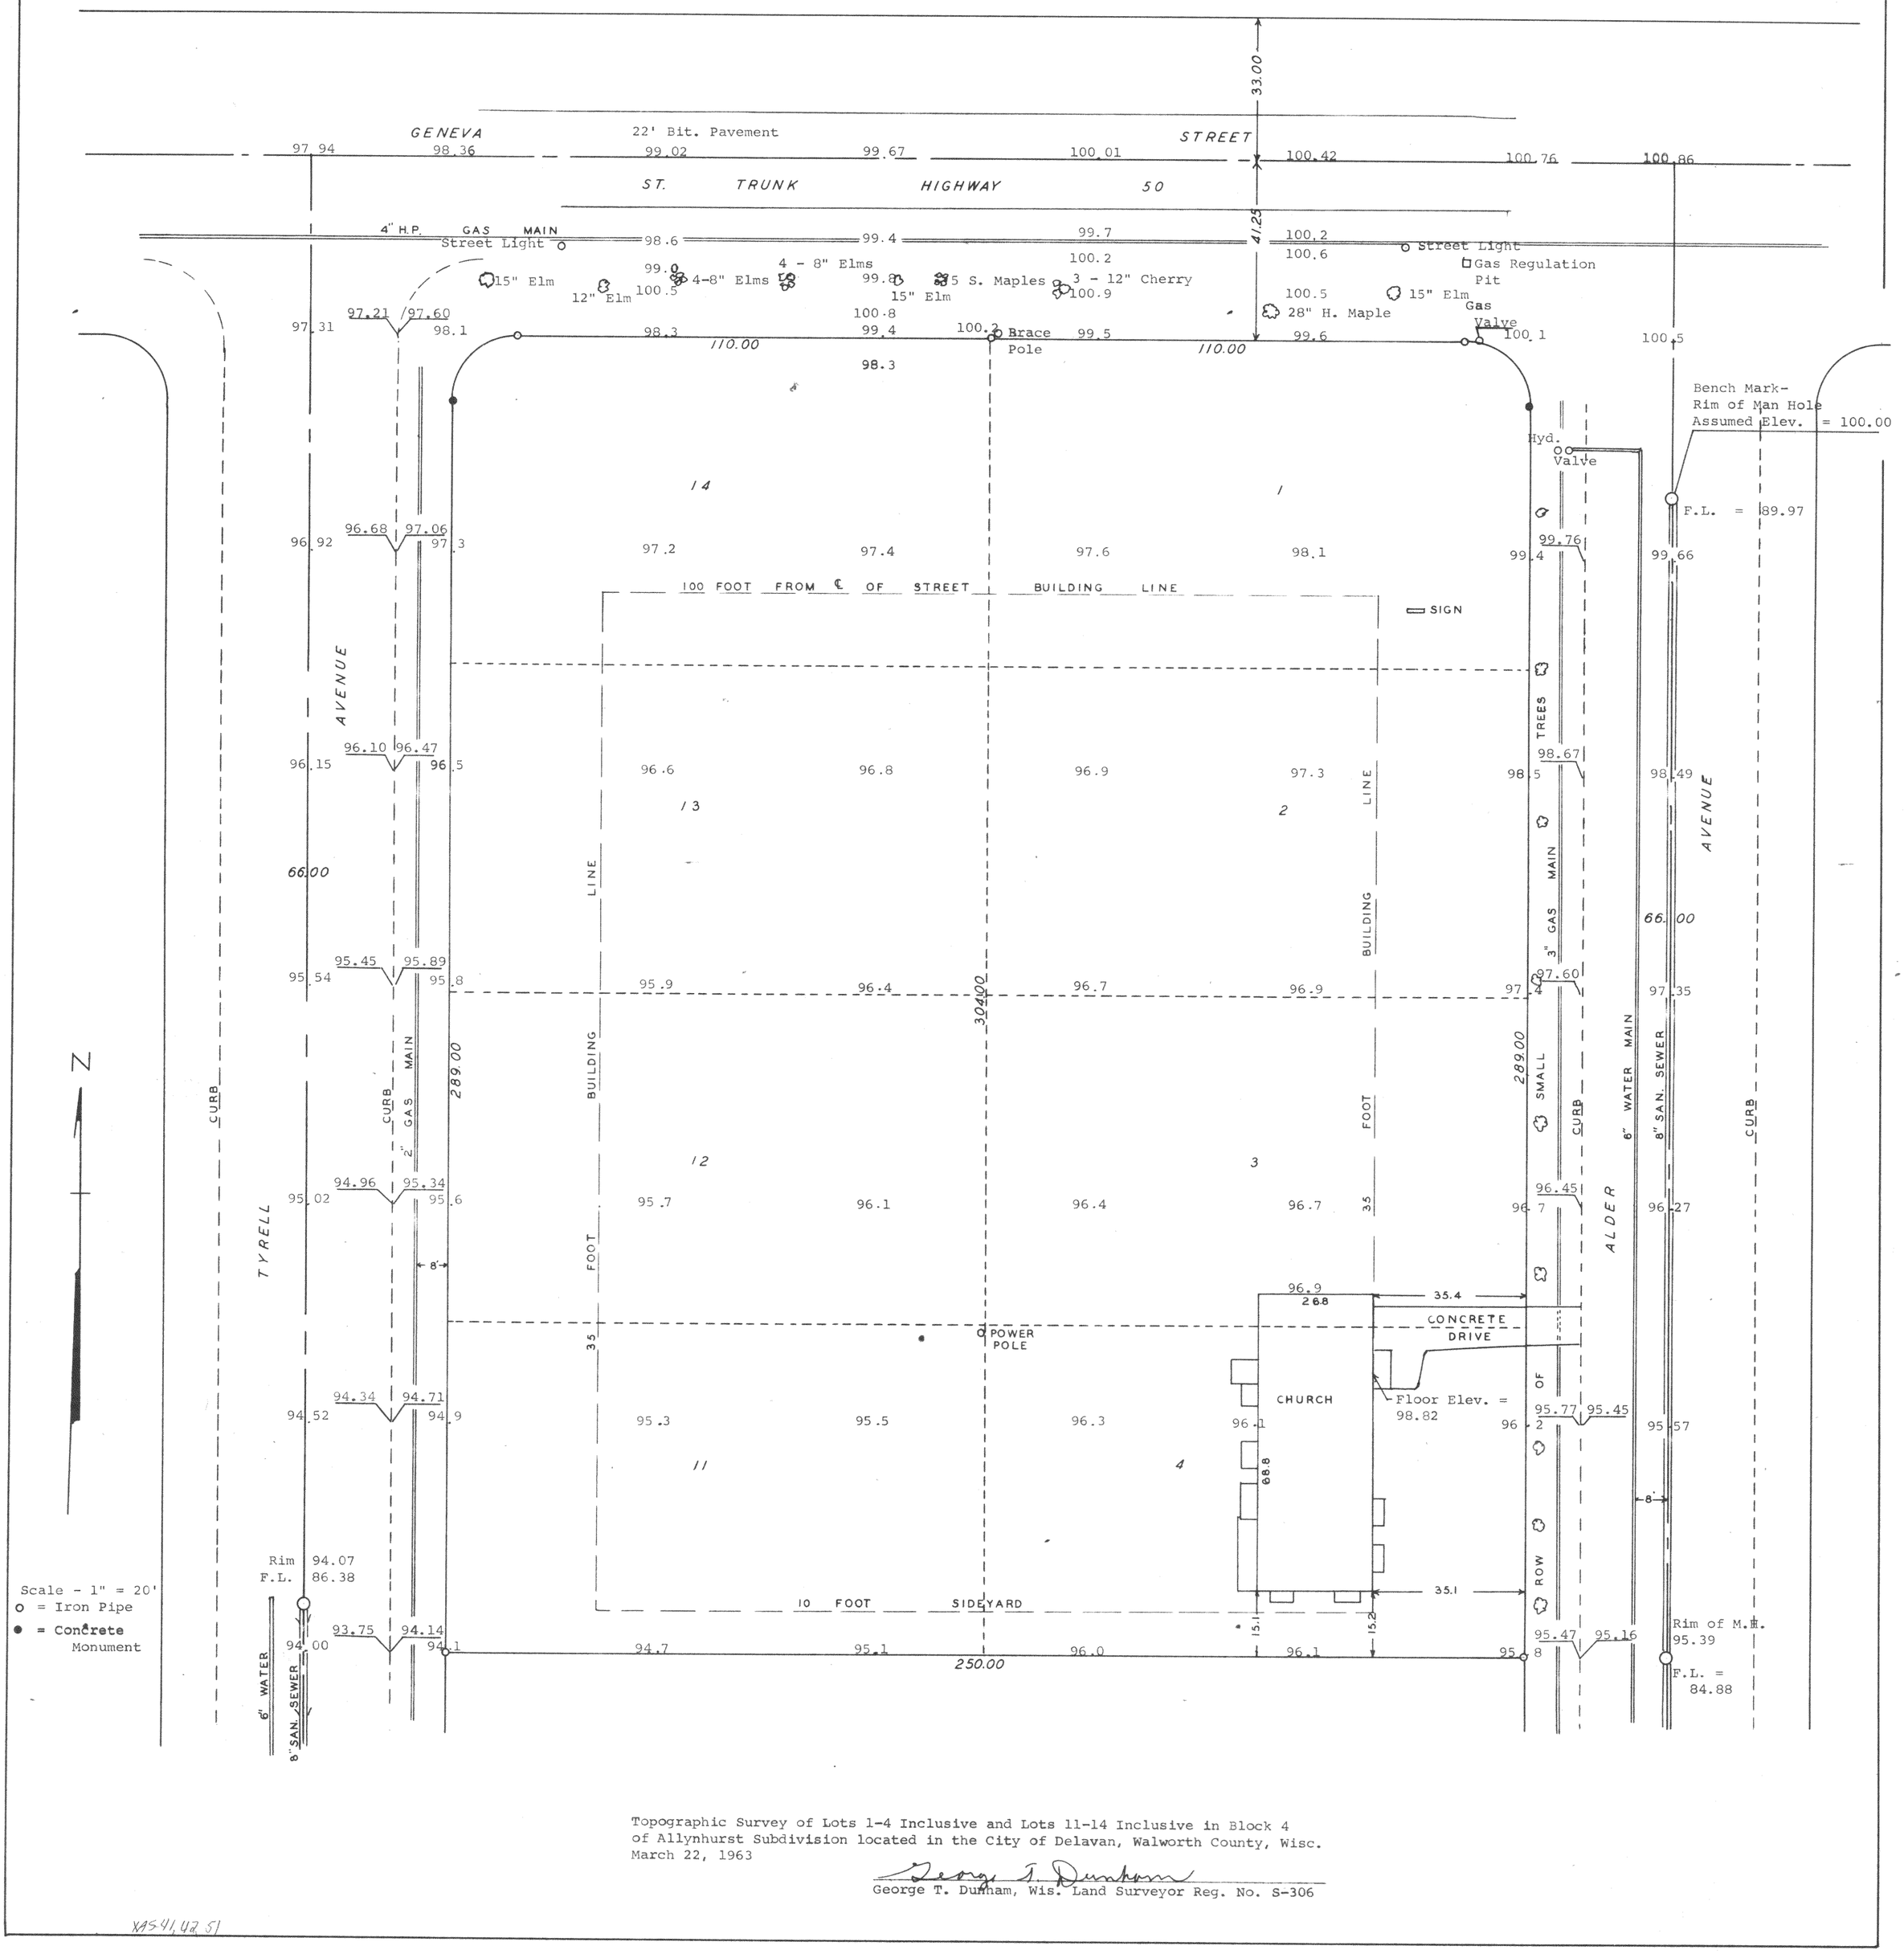


Topographic Survey of Lots 1-4 Inclusive and Lots 11-14 Inclusive in Block 4 of Allynhurst Subdivision located in the City of Delavan, Walworth County, Wisc.
March 22, 1963

George T. Dunham

George T. Dunham, Wis. Land Surveyor Reg. No. S-306

XAS-41, 42, 51

XAS-41, +XAS-51 (Topo Map)

2-207D