PLAT OF SURVEY


OWNER: MILLENNIUM DEVELOPMENT PARTNERS II, LLC.

BUILDER: QUANTUM ENTERPRISES, LLC
N47 W27 585 LYNNDALE RD
PEWAUKEE, WISCONSIN 53072

BUILDING 5 OF THE FIELDS OF DELAVAN, BEING A REDIVISION OF LOT 1 OF CERTIFIED SURVEY MAP NO. 2577, BEING PART OF THE SOUTHWEST QUARTER (SW 1/4) OF SECTION 13, TOWN 2 NORTH, RANGE 15 EAST CITY OF DELAVAN, WALWORTH COUNTY, WISCONSIN.

EXISTING TOP OF FOUNDATION: 949.04

REFERENCE BEARING: ALL BEARINGS ARE REFERENCED TO GRID NORTH OF THE WISCONSIN STATE PLANE COORDINATE SYSTEM SOUTH ZONE.

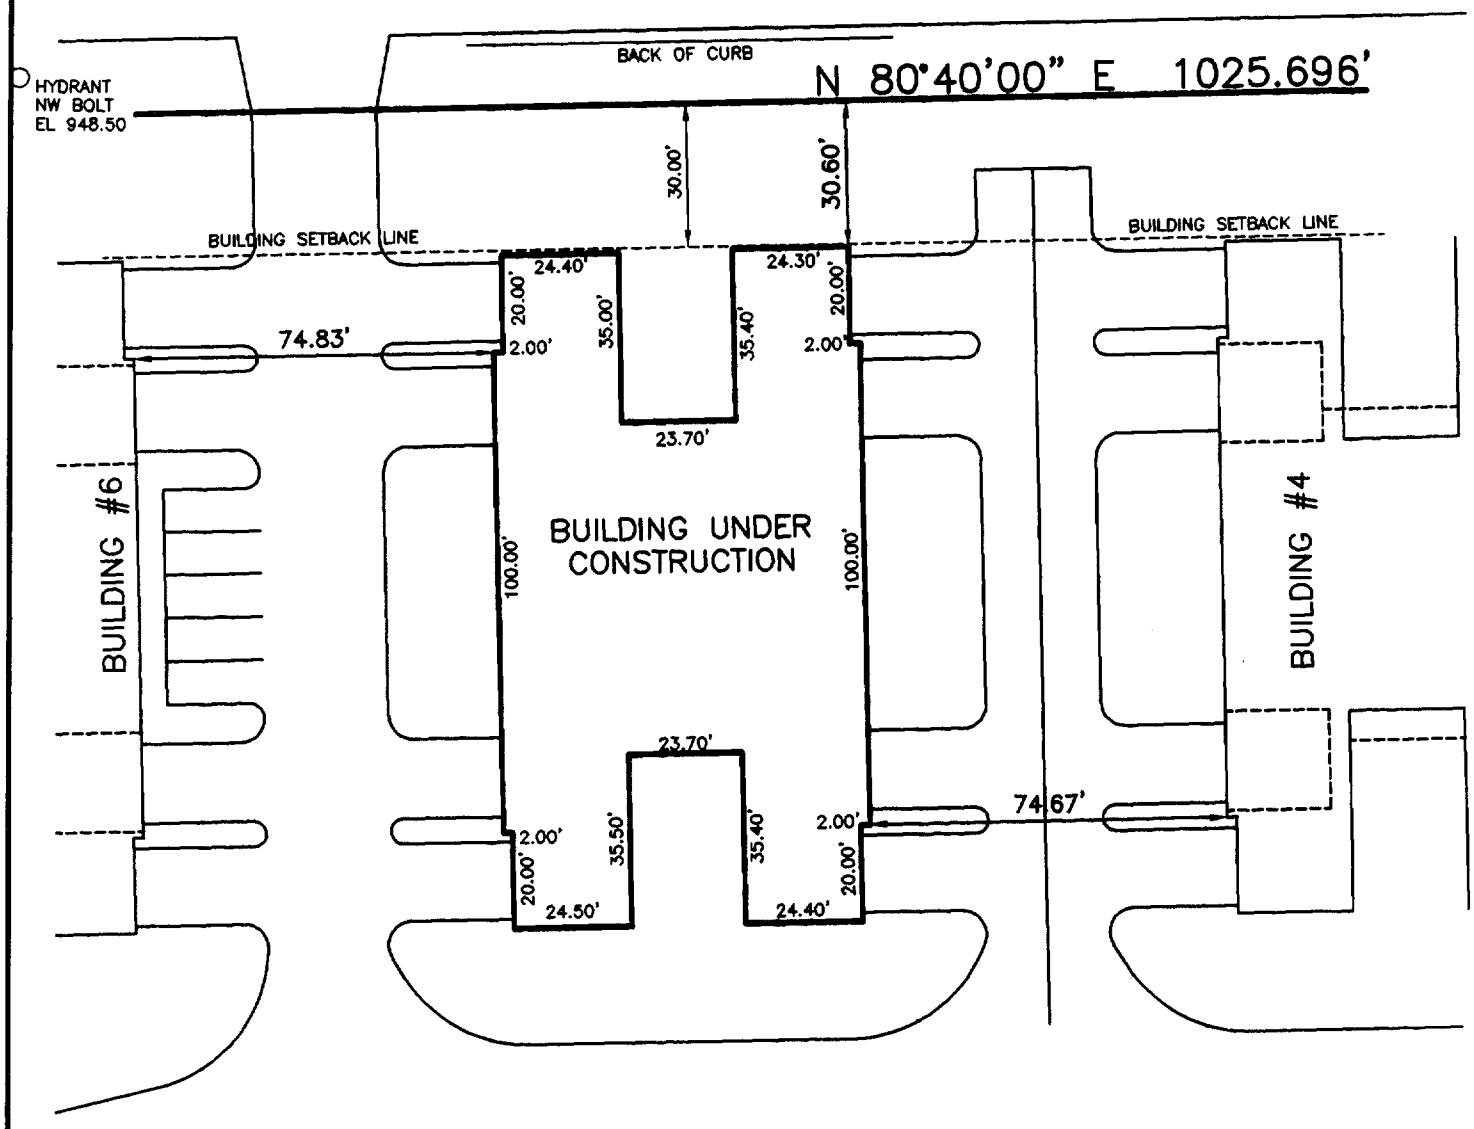

RECEIVED
MAY 23 2003

PLAN DATED: DECEMBER 18, 2000
FILE NO.: D:\0000\00079
PLAN SCALE: 1" = 40'

STATE OF WISCONSIN
COUNTY OF JEFFERSON } SS.

WISCONSIN
KALVIN K. KLIMECK
S-2209
JOHNSON CREEK, WISCONSIN
12/18/00
REGISTERED LAND SURVEYOR

WE, PIONEER ENGINEERING & SURVEYING, DO HEREBY CERTIFY THAT WE HAVE MADE THIS SURVEY AND THAT THE INFORMATION AS SHOWN ON THE ABOVE PLAT OF SURVEY IS TRUE AND CORRECT REPRESENTATION THEREOF.

PIONEER ENGINEERING AND SURVEYING, LLC.
CONSULTANTS IN SUBDIVISIONS AND COMMERCIAL DEVELOPMENTS
3902 C.T.H. "B"
JOHNSON CREEK, WI. 53038
(920) 699 - 3330 FAX: 699 - 3332

XFIE-5

002-2118