
PLAT OF SURVEY

-OF-

LOT 18, BLOCK 4, PASSAGE & DOWNIE ADDITION TO THE CITY OF DELAVAN, WALWORTH COUNTY, WISCONSIN.

PREPARED FOR: ALLISON OLSTEN
C-21 SKANDIA
822 E GENEVA
DELAVAN, WI, 53115

J.K. SURVEYING INC.
N3705 WILLOWBEND LANE
LAKE GENEVA, WI, 53147
262-248-3697

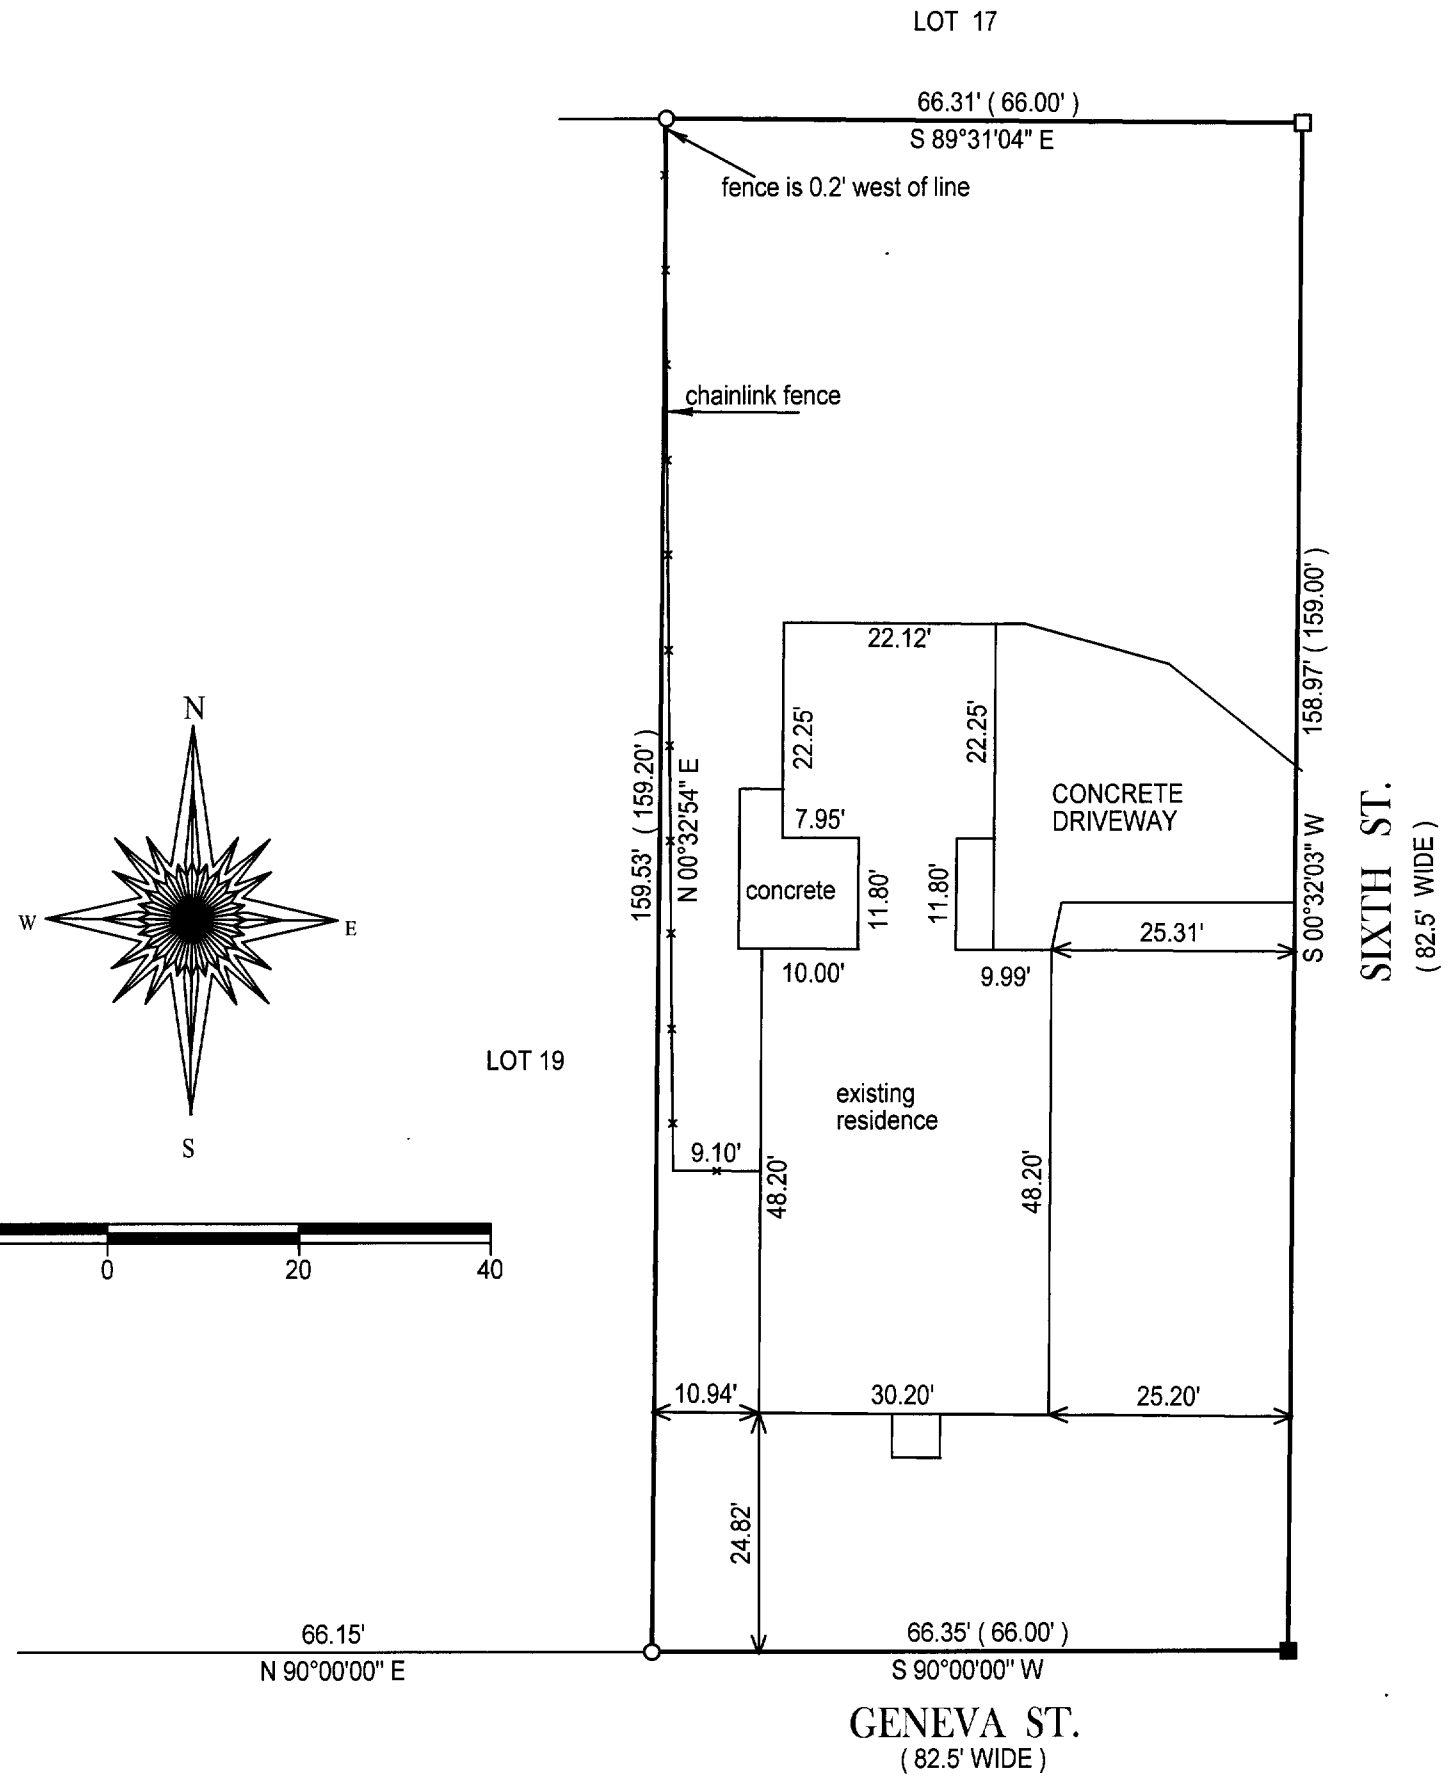

RECEIVED
AUG 13 2004

( ) = *RECORDED AS*

□ = *FOUND IRON BAR*

○ = *FOUND IRON PIPE*

● = *SET IRON PIPE*

■ = *SET IRON BAR*

SCALE: 1" = 20'

JOB #: 04-411

TAX ID #:XP 00064

COMPARE LEGAL DESCRIPTION ABOVE AND DRAWING WITH DEED. FOR BUILDING RESTRICTIONS AND EASEMENTS NOT SHOWN,REFER TO DEED, ABSTRACT SOURCES AND LOCAL MUNICIPAL CODES. NOTIFY THE SURVEYOR IMMEDIATELY OF ANY DISCREPANCY.

"I hereby certify that the above described property was surveyed under my supervision and that the above map, to the best of my knowledge and belief, is a true representation thereof and shows the size and location of all visible structures, apparent easements and encroachments if any."
This survey is made for the present owners of the property, and those who purchase, mortgage, or guarentee the title thereto, within one year from the date hereof.

WISCONSIN
JEFFREY L. KIMPS
2436
LAKE GENEVA. WIS.
LAND SURVEYOR

JEFFREY L KIMPS S-2436
Wisconsin Registered Land Surveyor
(original if signed in red)

DATED THE 28 TH, DAY OF JULY 2004.

002-2234