
ABELL
SURVEYING & MAPPING

1140 SEQUOIA STREET · DELAVAN, WISCONSIN 53115
262-728-6737

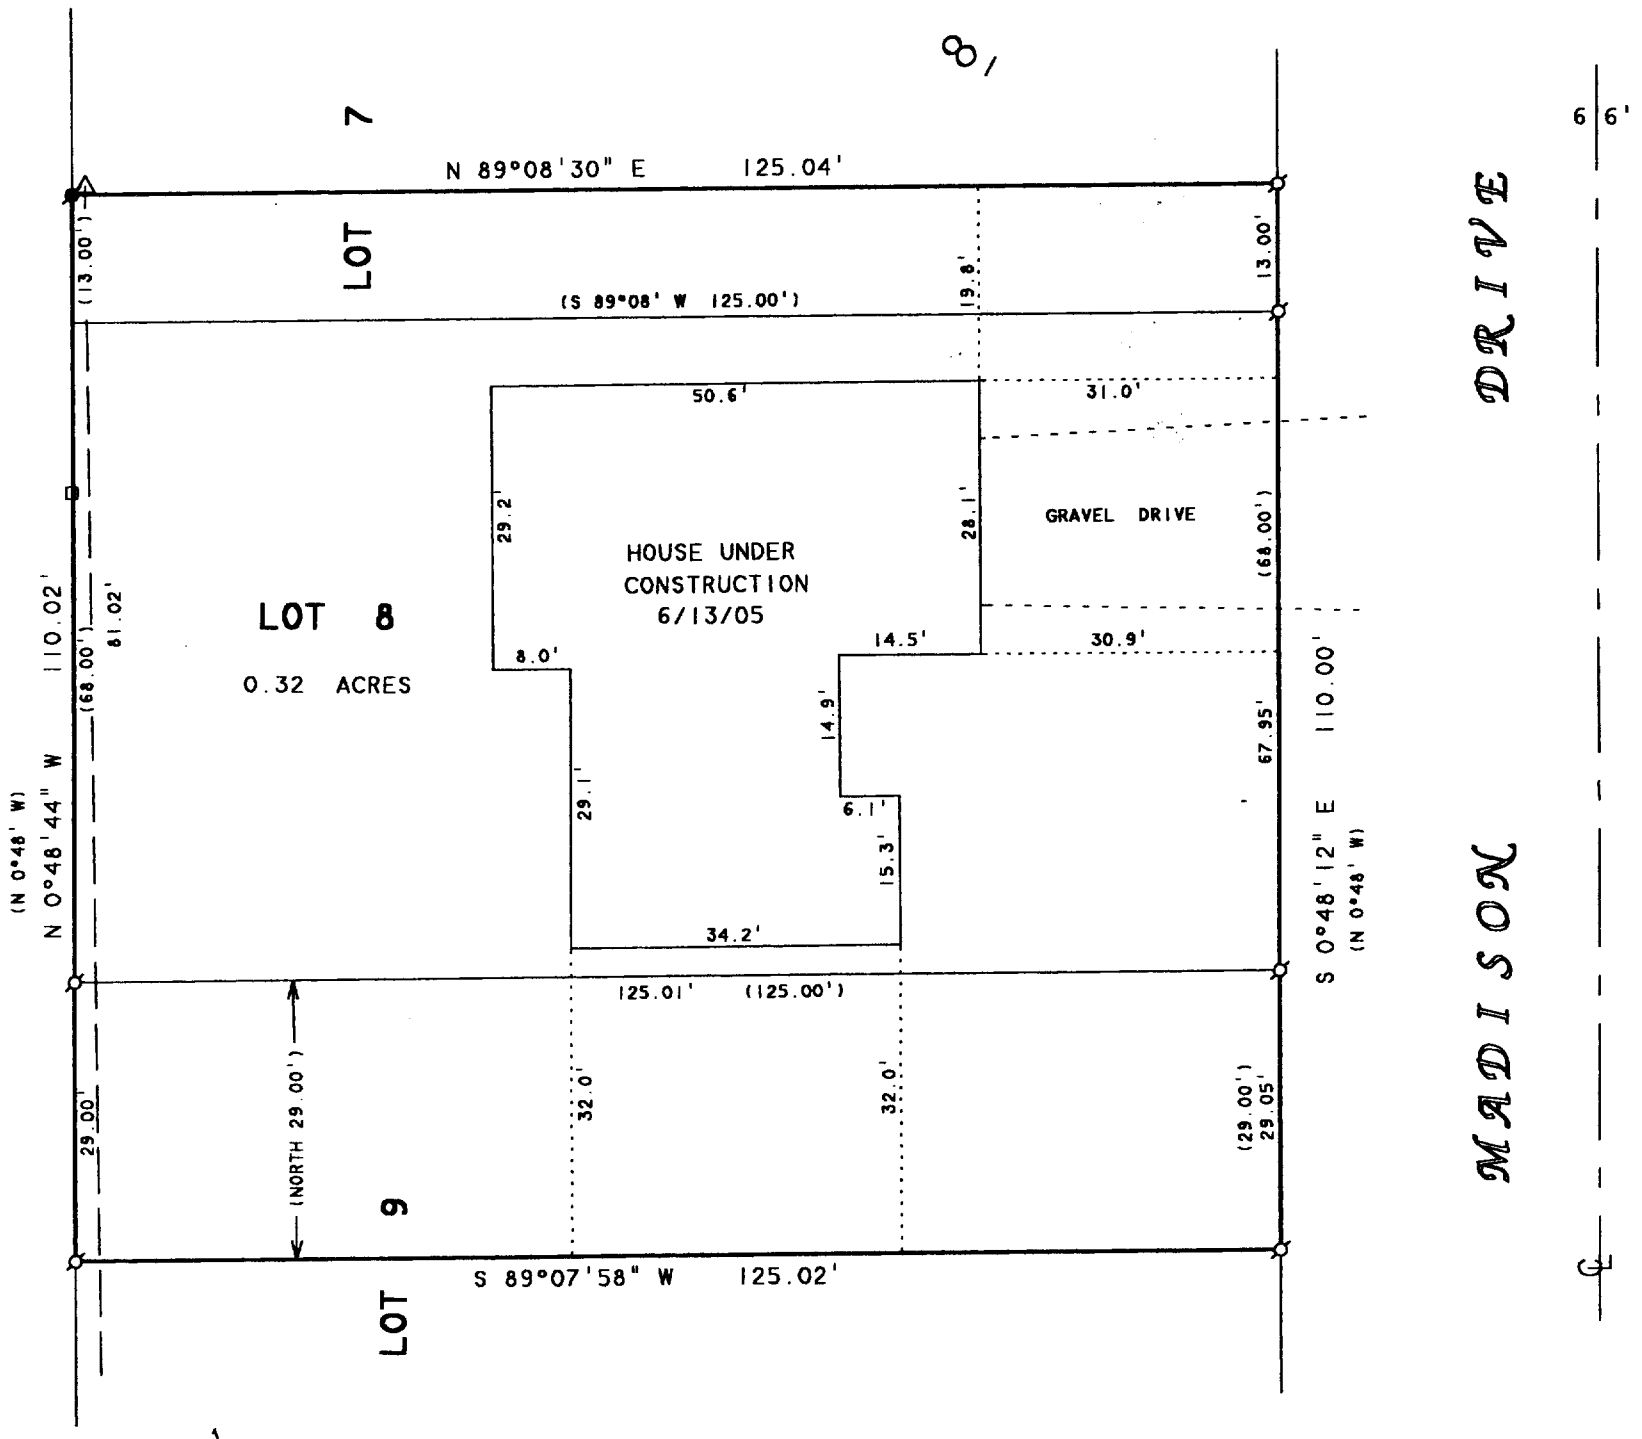

PLAT OF SURVEY OF

THE NORTH 29.00 FEET OF LOT 9, ALL OF LOT 8 AND THE SOUTH 13.00 FEET OF LOT 7, ALL IN BLOCK 8 OF ALLYHURST SUBDIVISION, CITY OF DELAVAN, WALWORTH COUNTY, WISCONSIN.

ORDERED BY: KATIE KLADE
2808 BORG ROAD
DELAVAN, WI 53115

NOTE: BEARINGS ARE REFERENCED TO EXISTING SURVEY RECORDS.

N

SCALE 1"=20'

LEGEND

- ⌀ - IRON PIPE FOUND
- ◙ - IRON ROD FOUND
- □ - UTILITY PED
- — — — — - OVERHEAD UTILITY LINES
- △ - UTILITY POLE
- ( ) - RECORDED AS

I HEREBY CERTIFY THAT I HAVE SURVEYED THE ABOVE DESCRIBED PROPERTY AND THAT THE ABOVE MAP IS A TRUE REPRESENTATION THEREOF AND SHOWS THE SIZE AND LOCATION OF THE PROPERTY, ITS EXTERIOR BOUNDARIES, THE LOCATION OF ALL VISIBLE STRUCTURES AND DIMENSIONS OF ALL PRINCIPAL BUILDINGS THEREON, BOUNDARY FENCES, APPARENT EASEMENTS, ROADWAYS AND VISIBLE ENCROACHMENTS, IF ANY, TO THE BEST OF MY KNOWLEDGE AND BELIEF.

THIS SURVEY IS MADE FOR THE USE OF THE PRESENT OWNERS OF THE PROPERTY, AND ALSO THOSE WHO PURCHASE, MORTGAGE, OR GUARANTEE THE TITLE THERETO WITHIN ONE (1) YEAR FROM DATE HEREON.

David F. Abell

DAVID F. ABELL
WISCONSIN REGISTERED LAND SURVEYOR, S-1596

June 15, 2005

DATE JOB NUMBER - 05069

NOTE: THIS IS NOT A CERTIFIED COPY UNLESS SEALED.

XAS 00091

002-23K6