
ABELL
SURVEYING & MAPPING

1140 SEQUOIA STREET • DELAVAN, WISCONSIN 53115
262-728-6737

PLAT OF SURVEY OF

WARRANTY DEED
VOL. 497, PAGE 909, DOC. NO. 199739

BEGINNING AT A POINT 4 RODS NORTH OF THE SOUTHEAST CORNER OF BLOCK 1 OF THE ORIGINAL PLAT OF THE VILLAGE (NOW CITY) OF DELAVAN, SAID BLOCK 1 BEING COMMONLY KNOWN AS THE "OLD CEMETERY BLOCK", RUNNING NORTH 4 RODS: THENCE EAST 10 RODS: THENCE SOUTH 4 RODS: THENCE WEST 10 RODS TO THE PLACE OF BEGINNING.

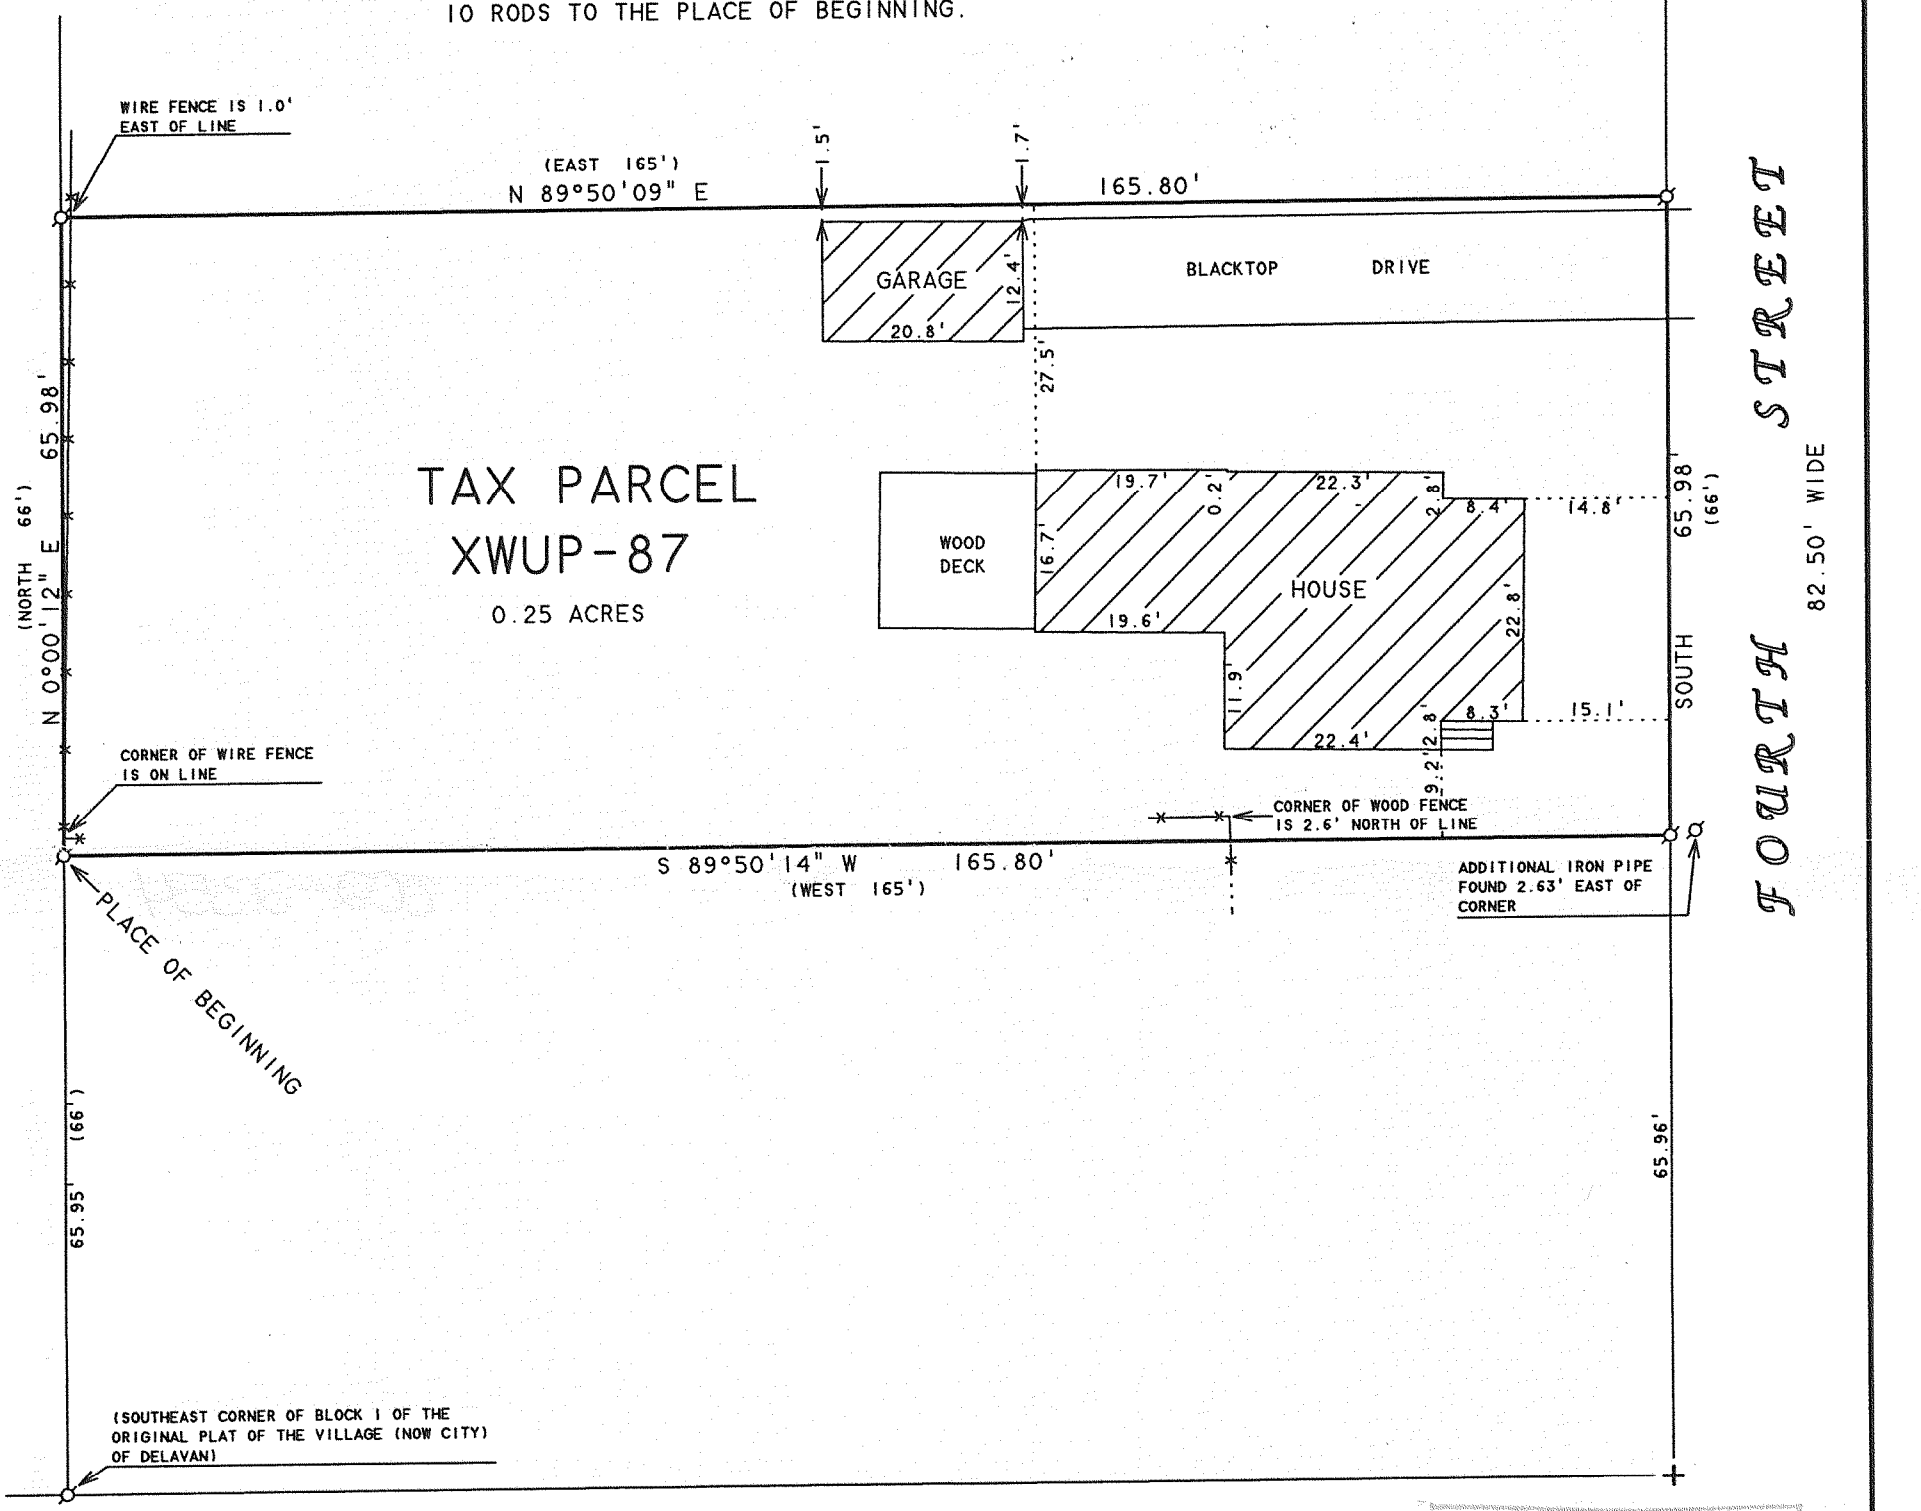

RECEIVED
JUN - 8 2006

NOTE: BEARINGS ARE REFERENCED TO EXISTING SURVEY RECORDS.

N

SCALE 1"=20'

LEGEND

- ○ - IRON PIPE FOUND
- + - CUTCROSS IN CONCRETE SIDEWALK FOUND
- ◉ - CONCRETE MONUMENT FOUND
- -x-x- - WIRE AND WOOD FENCE
- ( ) - RECORDED AS

ORDERED BY: MIKE ARENZ
206 N. FOURTH STREET
DELAVAN, WI 53115

I HEREBY CERTIFY THAT I HAVE SURVEYED THE ABOVE DESCRIBED PROPERTY AND THAT THE ABOVE MAP IS A TRUE REPRESENTATION THEREOF AND SHOWS THE SIZE AND LOCATION OF THE PROPERTY, ITS EXTERIOR BOUNDARIES, THE LOCATION OF ALL VISIBLE STRUCTURES AND DIMENSIONS OF ALL PRINCIPAL BUILDINGS THEREON, BOUNDARY FENCES, APPARENT EASEMENTS, ROADWAYS AND VISIBLE ENCROACHMENTS, IF ANY, TO THE BEST OF MY KNOWLEDGE AND BELIEF.

THIS SURVEY IS MADE FOR THE USE OF THE PRESENT OWNERS OF THE PROPERTY, AND ALSO THOSE WHO PURCHASE, MORTGAGE, OR GUARANTEE THE TITLE THERETO WITHIN ONE (1) YEAR FROM DATE HEREON.

David F. Abell

DAVID F. ABELL
WISCONSIN REGISTERED LAND SURVEYOR, S-1596

April 3, 2006
DATE

JOB NUMBER - 06026

NOTE: THIS IS NOT A CERTIFIED COPY UNLESS SEALED.

XWUP-87

002-2334