
Plat of Survey

of

Lot 9 of Block 2 of J.B. Devendorf's Addition to the Village (now City) of Delavan,

located in the Northwest 1/4 of Section 17, Town 2 North, Range 16 East, City of Delavan, Walworth County, Wisconsin.


Surveyed for: **Naser & Cara Tahiri**
206 North 8th Street
Delavan, Wisconsin. 53115

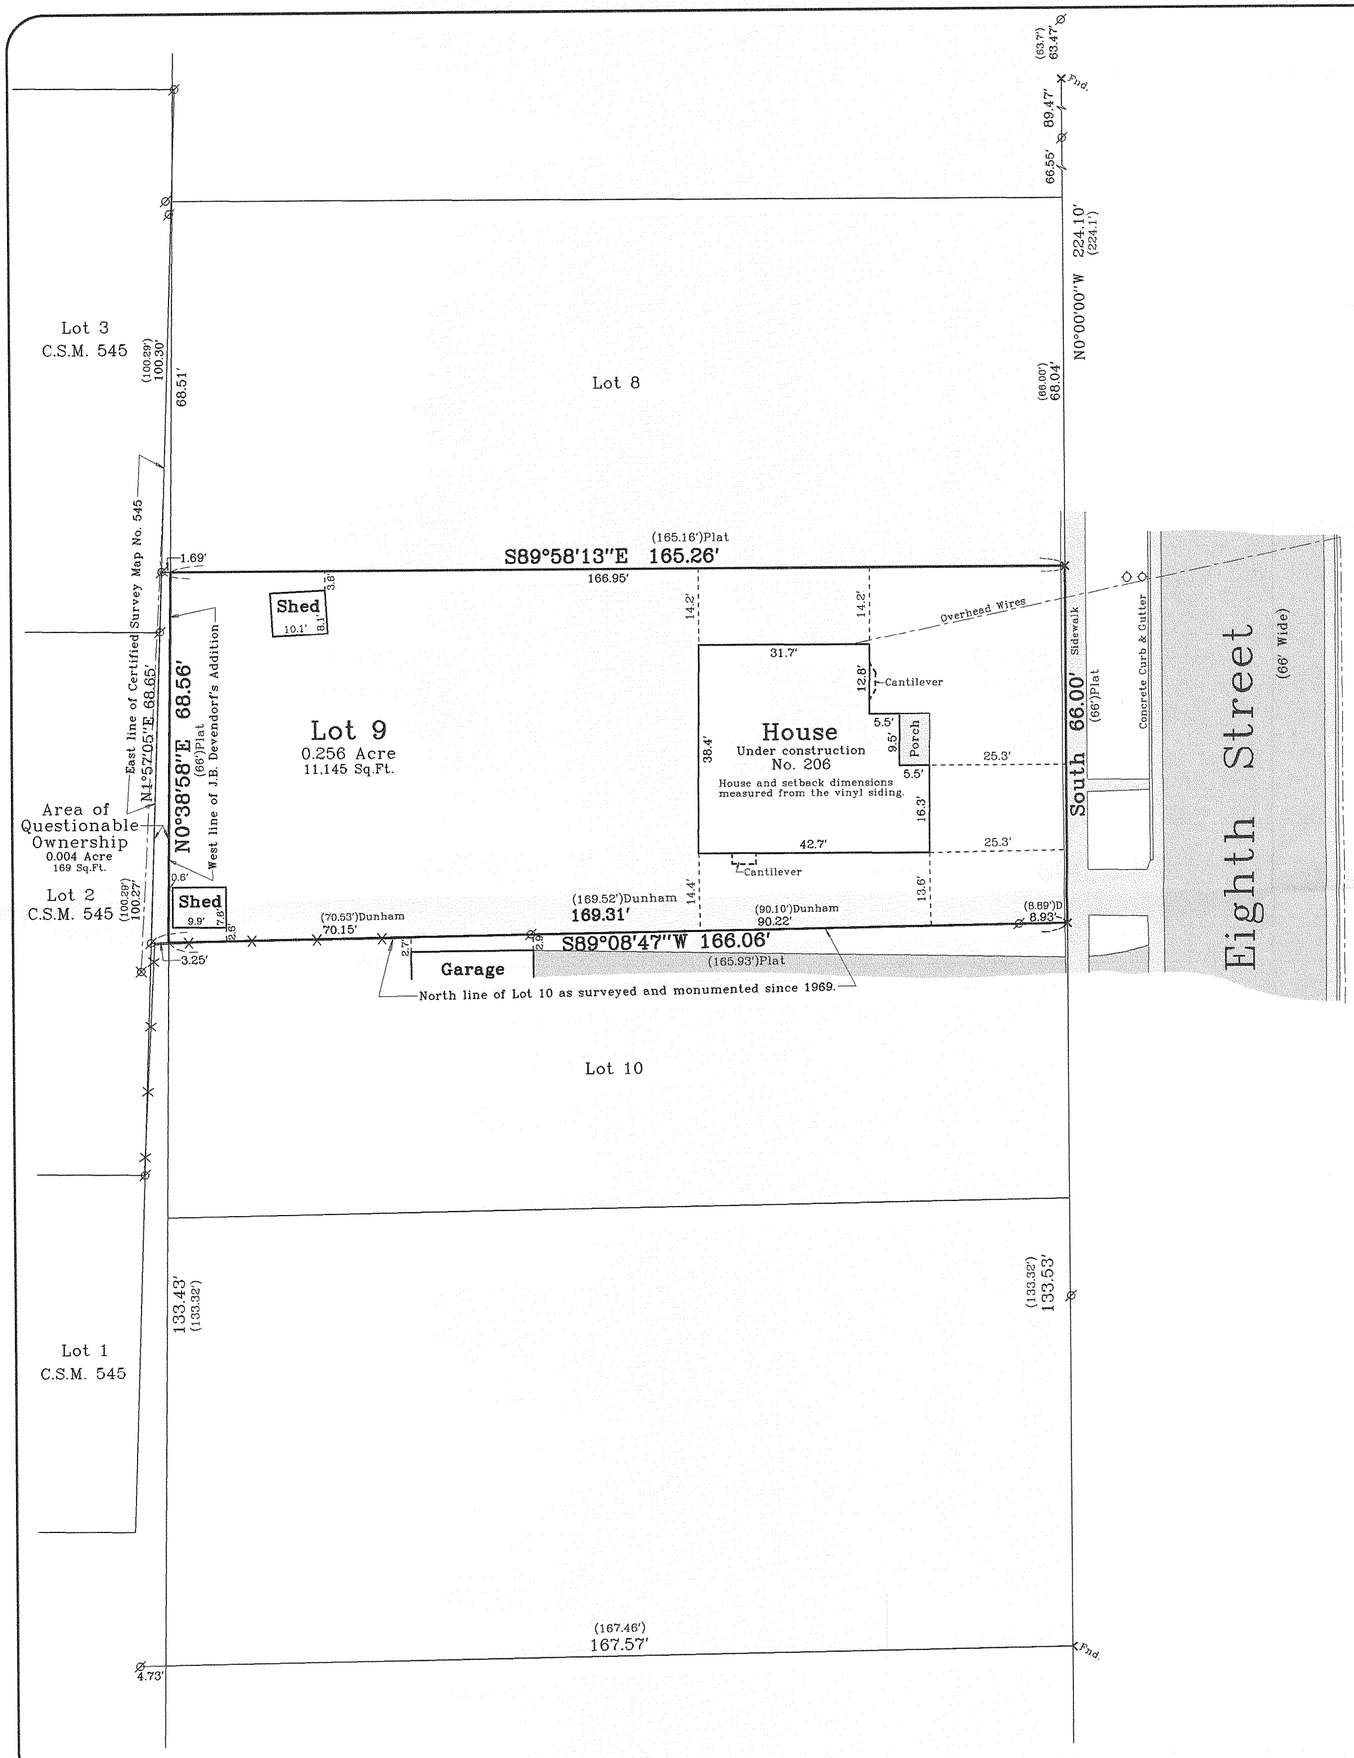

RECEIVED
AUG - 1 2007

WISCONSIN
DOUGLAS G. OLSON
S-2093
ELKHORN, WI
LAND SURVEYOR
Not Certified Unless Stamped in Red.

Subdivision Detail
1"=100'

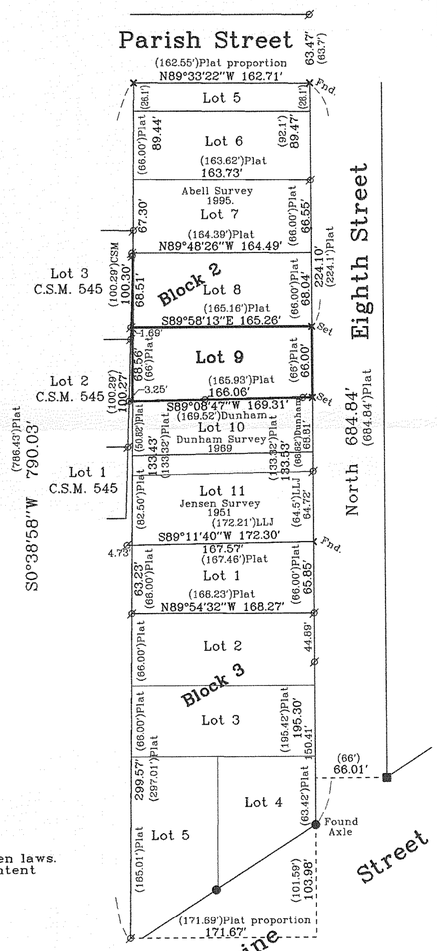

Bearings are assumed.

Notes: 1) This survey plat is not certified unless signed and sealed in red ink.

2) This survey is subject to Wisconsin lien laws. This Plat of Survey is the notice of intent to file lien. Lien waiver required.

Copyright c 2006 by Jensen & Olson Land Surveying, LLC.

All rights reserved. No part of this survey plat may be reproduced or transmitted in any form by any means - graphic, electronic, or mechanical, including photocopying, tracing, or information storage and retrieval systems - without permission in writing from Douglas G. Olson, Jensen & Olson Land Surveying, LLC.

I, Douglas G. Olson, Wisconsin Registered Land Surveyor, do hereby certify that this survey was performed by me or under my direction in full compliance with the owner's/agent's instructions and Chapter A-E 7 of the Wisconsin Administrative Code "Minimum Standards for Property Surveys", and that this map is an accurate representation thereof to the best of my knowledge and belief.

Douglas G. Olson
Wisconsin Registered Land Surveyor - 2093

Survey Date: August 11, 2006.
Revisions: No. 1 - Proposed House
No. 2 - House As-built

Scale in Feet
1" = 20'
0' 10' 20' 40'

Jensen & Olson Land Surveying, LLC
45 South Wisconsin Street P.O. Box 322
Elkhorn, Wisconsin. 53121
Telephone (262) 723-3434
Facsimile (262) 723-8044

Legend
- Found Concrete Monument
- Found Iron Pipe
- Found Iron Rod
- Cross Cut as noted
- ( ) Recorded Information
- Utility Pole
- Asphalt Surface
- Concrete
- 5/8 Proposed Dimension

Sheet 1 of 1 Sheets

Job Reference Number 2006.095

2006.095

XDE-18

002-2394