STATE OF WISCONSIN
COUNTY OF RACINE

I HEREBY CERTIFY THAT I HAVE SURVEYED THE ABOVE DESCRIBED PROPERTY AND THE ABOVE MAP IS A TRUE REPRESENTATION THEREOF AND SHOWS THE SIZE AND LOCATION OF THE PROPERTY, ITS EXTERIOR BOUNDARIES, THE LOCATION OF ALL VISIBLE STRUCTURE AND DIMENSIONS OF ALL PRINCIPLE BUILDINGS THEREON, BOUNDARY FENCES, APPARENT EASEMENTS, ROADWAYS AND VISIBLE ENCROACHMENTS, IF ANY.

THIS SURVEY IS MADE FOR THE PRESENT OWNERS OF THE PROPERTY, AND ALSO THOSE WHO PURCHASE, MORTGAGE, OR GUARANTEE THE TITLE THEREOF WITHIN ONE (1) YEAR FROM THE DATE THEREOF.

DATED AT: NORTH CAPE, THIS 16TH DAY OF JANUARY, 2008.

Pete L Bailey

AMERICAN SURVEYING COMPANY, INC.
PETE L. BAILEY, RLS NO. 1398
RECERIFIED this _____day of _____, 2008.

NORTH

SCALE
0 40 80
FEET

LEGAL DESCRIPTION:

BUILDINGS NUMBERS 6 AND 8 OF "FIELDS OF DELIVAN CONDOMINIUM" BEING A PART OF THE SOUTHWEST ¼ OF THE SOUTHWEST ¼ OF SECTION 13, TOWN 2 NORTH, RANGE 15 EAST, IN THE CITY OF DELIVAN, COUNTY OF WALWORTH, STATE OF WISCONSIN. ACCORDING TO THE RECORDED PLAT THEREOF.

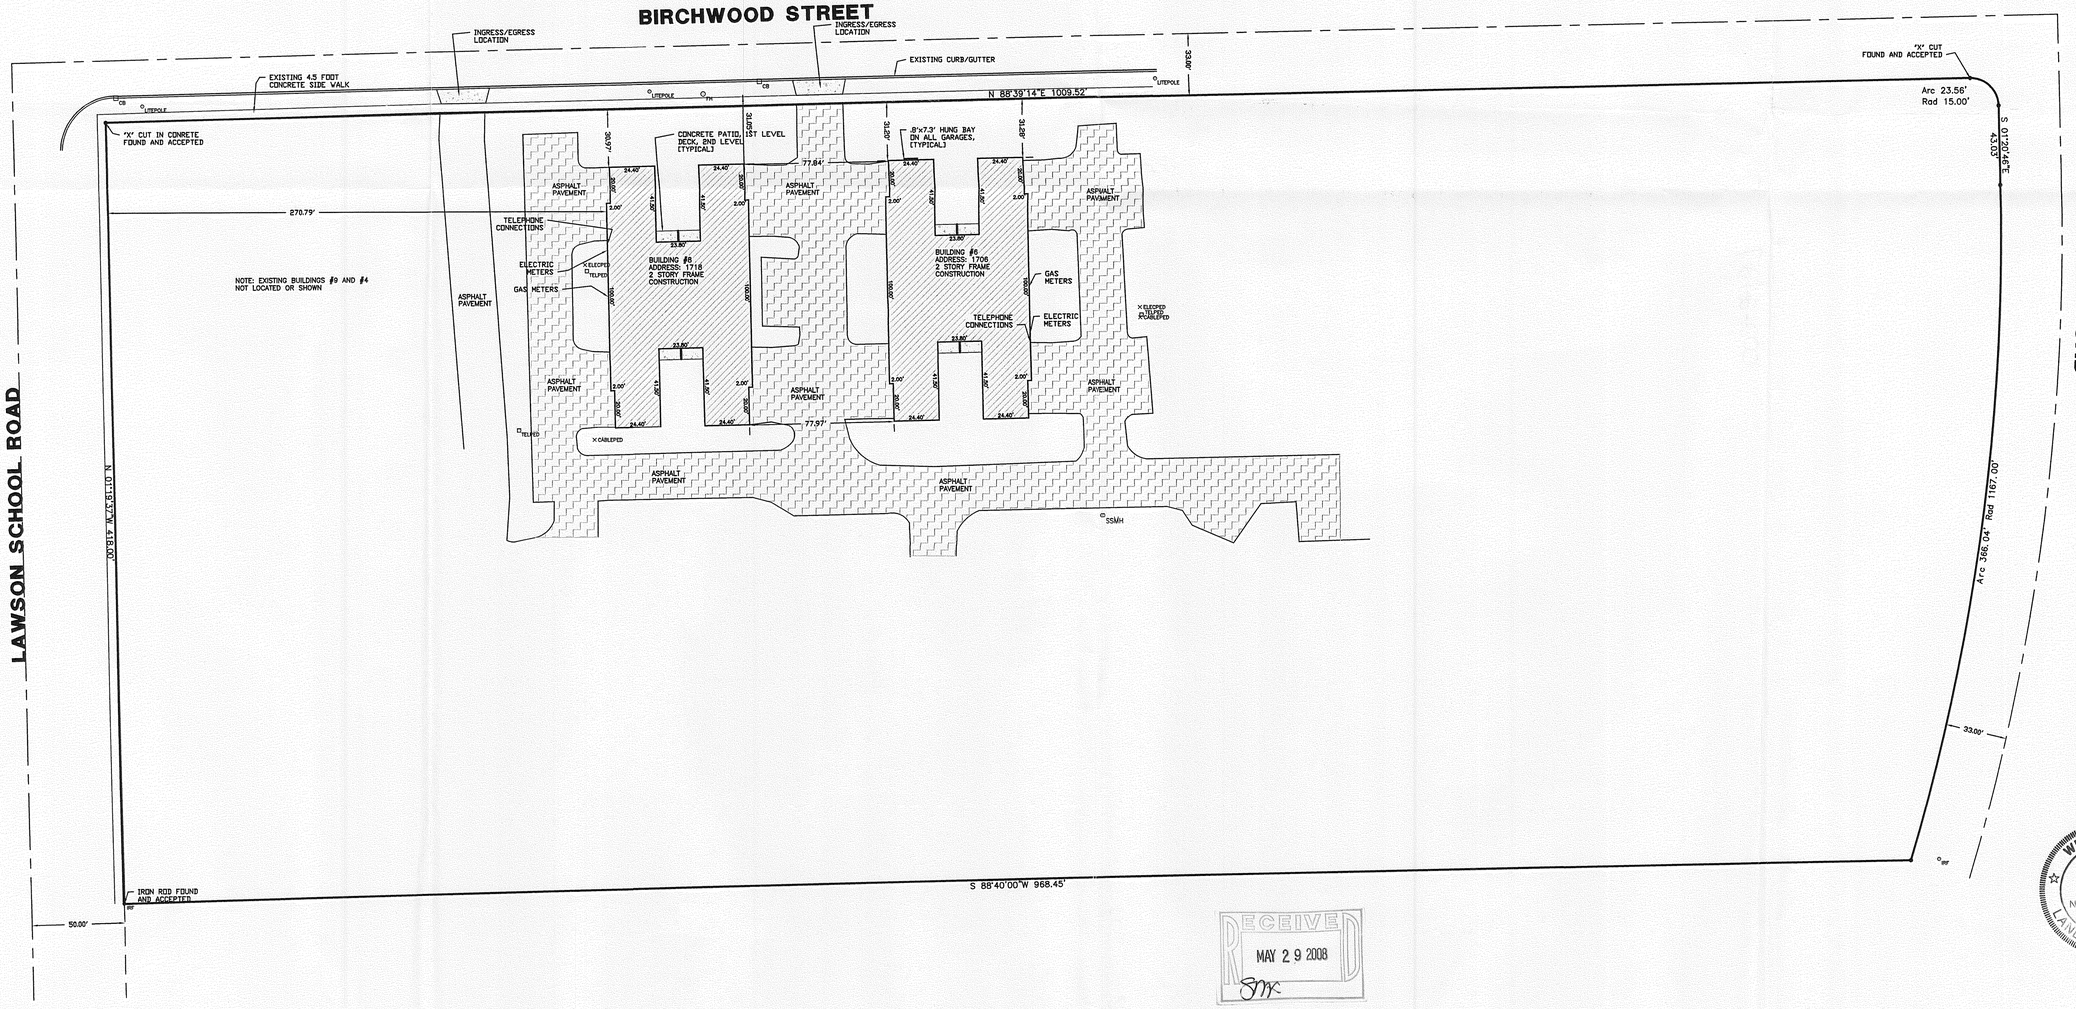

RECEIVED
MAY 29 2008

WISCONSIN
PETE L. BAILEY
S-1398
NORTH CAPE
LAND SURVEYOR

AMERICAN SURVEYING COMPANY, INC.
12207 C.T.H. "K" FRANKSVILLE, WISCONSIN 53126
TEL. (262) 835-4774 FAX: (262) 835-2379
beaufordbailey@hotmail.com

DRAWN BY:	PLB
CHECKED BY:	PLB
PLOT SCALE:	1 = 40
DATE:	01/16/2008
JOB NO.:	2008004
DWG. FILE:	JN208009
REVISIONS:	DATE
CLIENT NO.	03733

CITY OF DELIVAN

PROJECT:
PLAT OF SURVEY/ BOUNDARY SURVEY
PREPARED FOR: IMPERIAL INVESTMENTS, INC

Sheet 1 of 1

XFIE-6 XFIE-8

002-2427