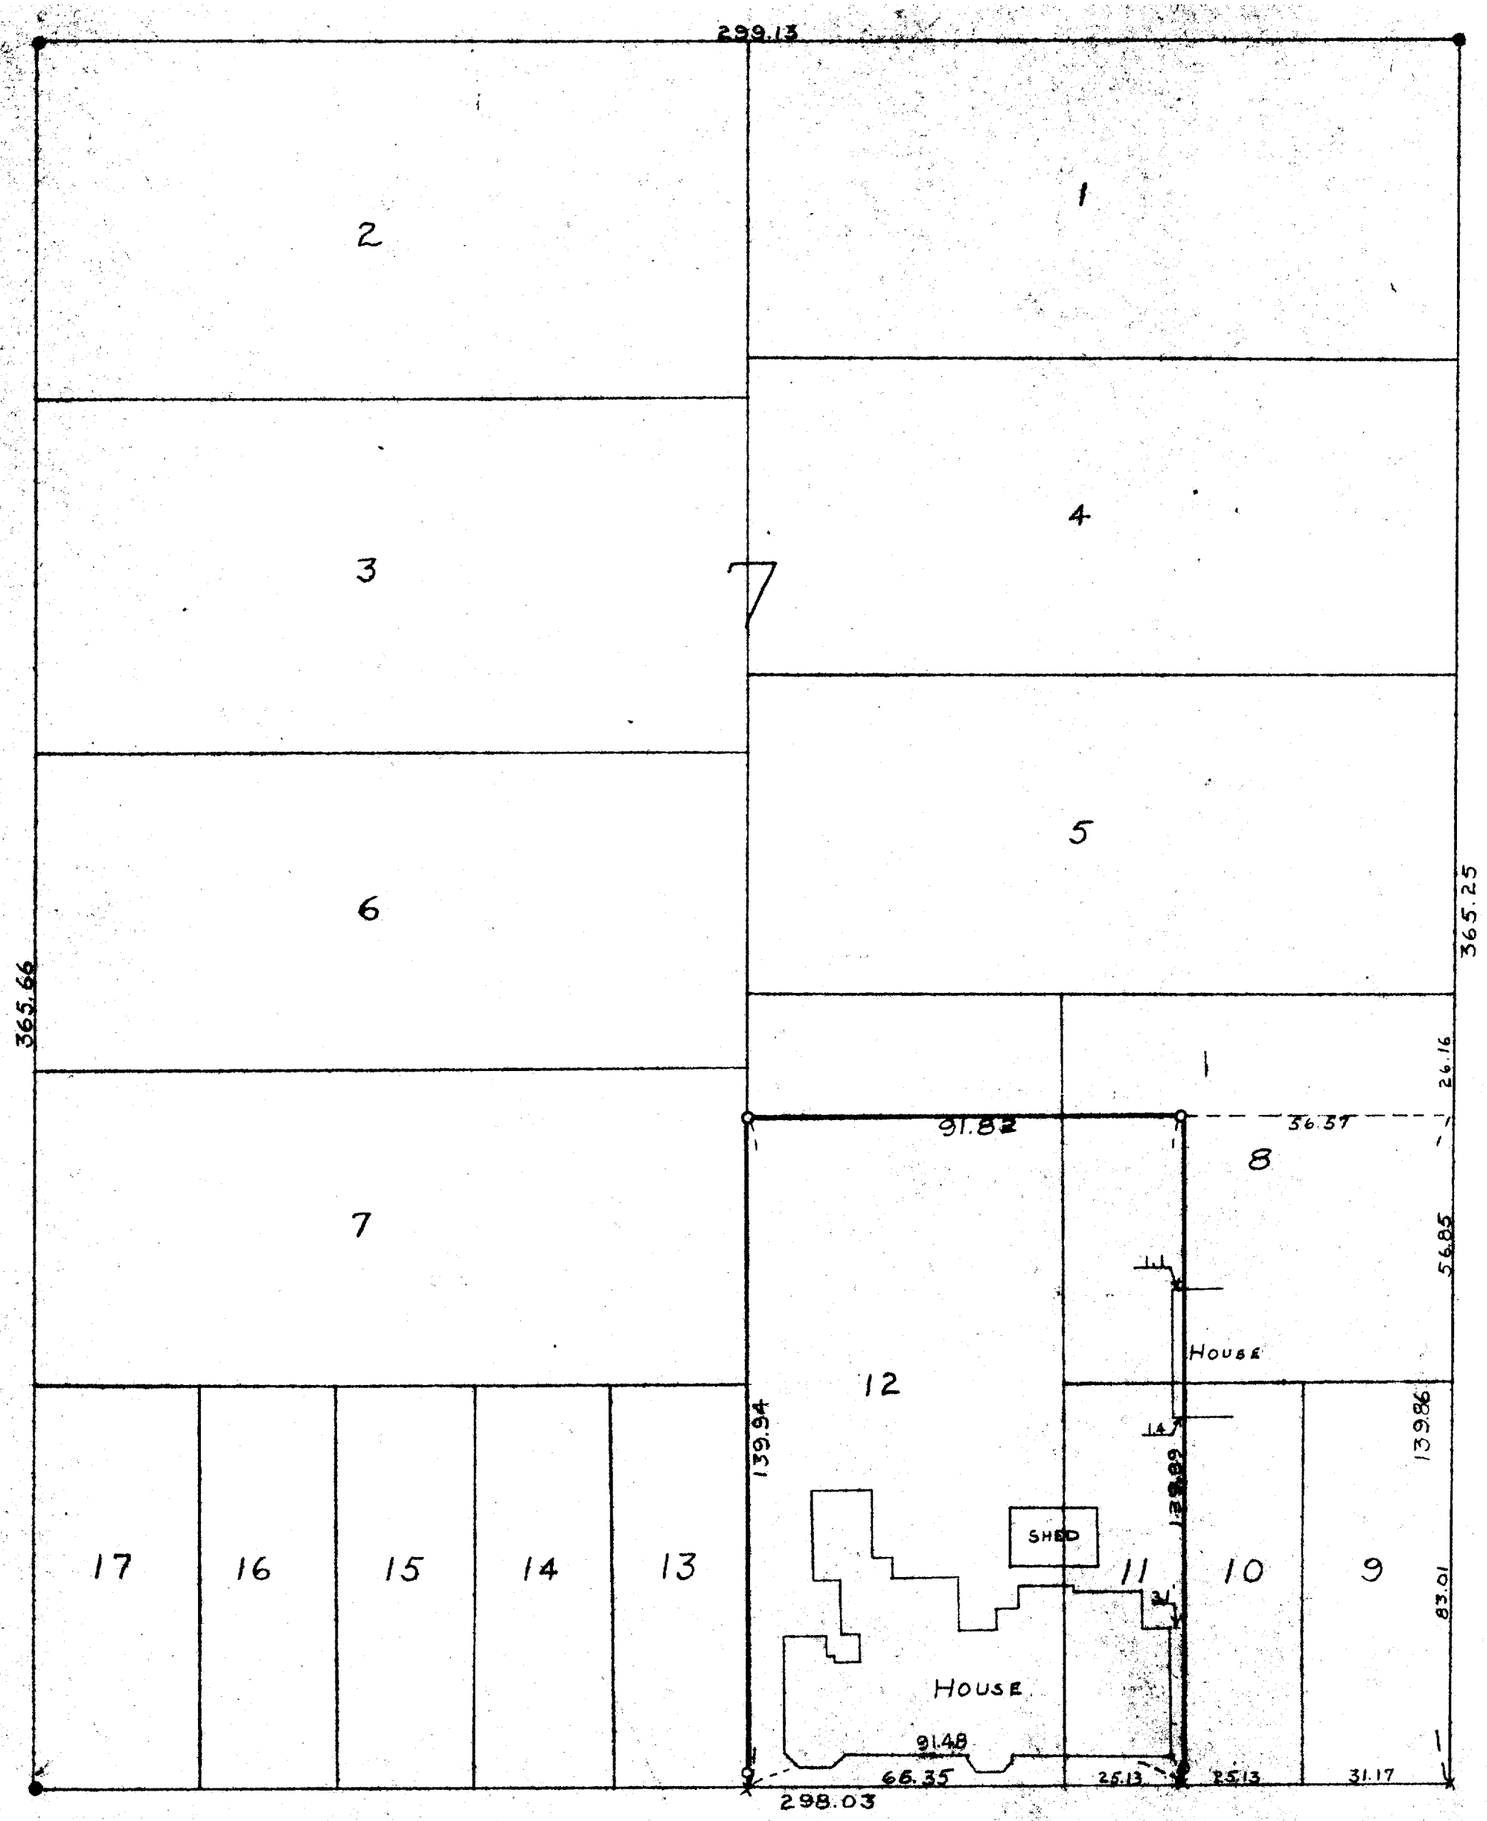

Block Corners as established by the City of Delavan

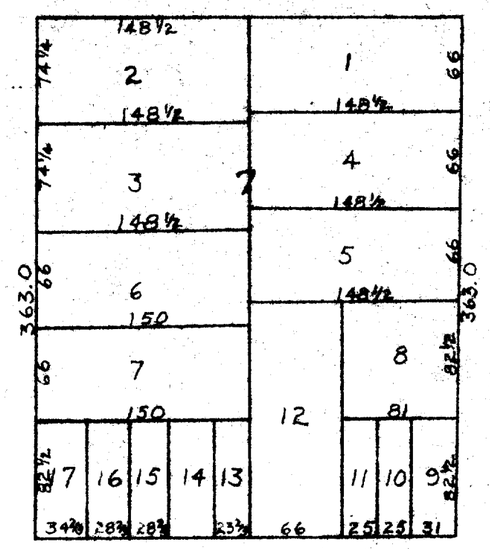

Copy of Recorded Plat on file in the Register of Deeds Office, Elkhorn Wisc.

N

Scale - 1" = 100'

N

Scale - 1" = 30'
● = Conc. Monu.
o = Iron Pipe
x = Cross in Conc.

Plat of survey of Lot 11, the West 25 feet of the South 56½ feet of Lot 8 and Lot 12 except the North 26 feet, thereof, in Block 7 of the Original Plat of the Village, now City of Delavan, Walworth County Wisconsin
Nov. 1951

Floyd L. Jensen
County Surveyor

XOP-37

2-24 J