PREPARED FOR
SARAH WARREN
211 S. THIRD ST.
DELAVAN WI. 53115


PLAT OF SURVEY

-OF-

THE SOUTH 6 FEET OF LOT 2 AND ALL OF LOT 3, BLOCK 18,
OF THE ORIGINAL PLAT OF THE VILLAGE (NOW CITY)
OF DELAVAN, WALWORTH COUNTY, WISCONSIN.

KROTT SURVEYING INC.
N3705 WILLOW BEND LANE
LAKE GENEVA WI. 53147
PHONE # (262)248-3697
FAX # (262)249-0639

RECEIVED
APR 18 2012
By

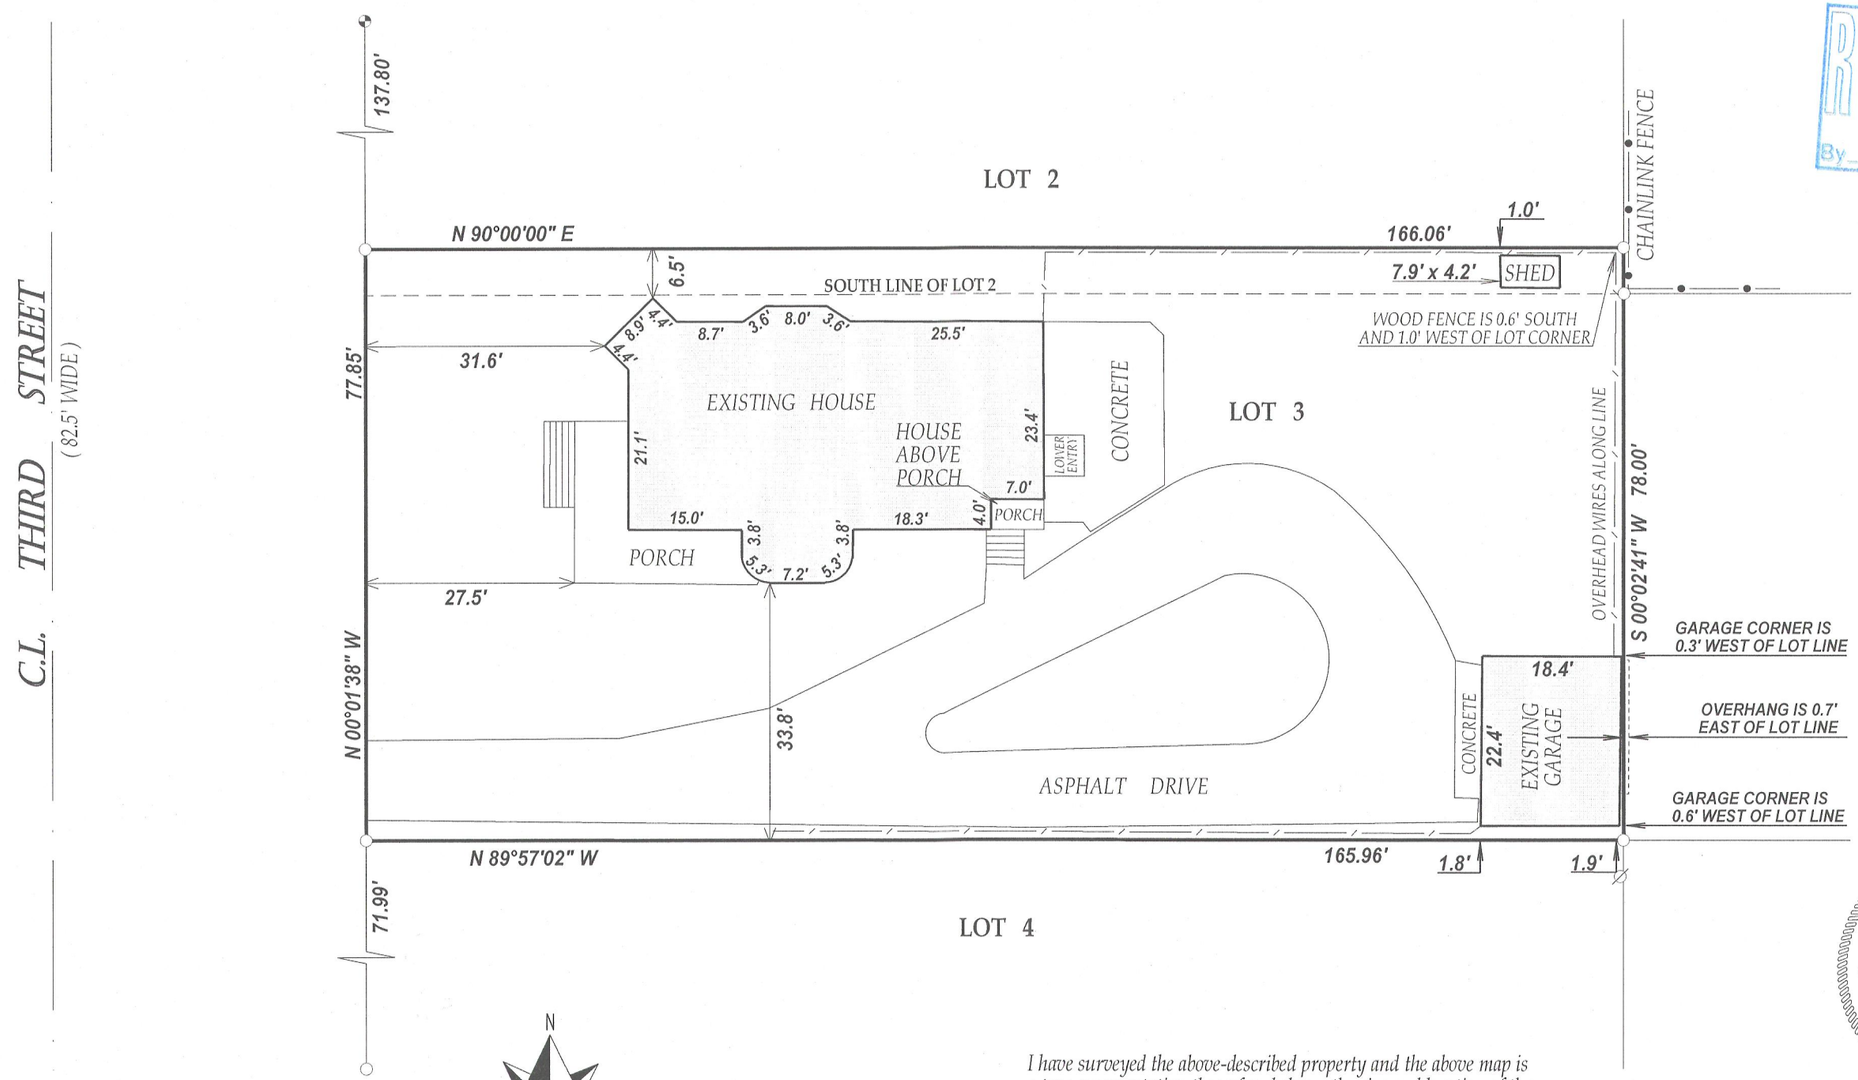


LEGEND

- ○ FOUND IRON PIPE
- ◔ FOUND CONCRETE MONUMENT
- ∅ UTILITY POLE
- (XX) RECORDED AS

TAX ID # XOP00194

JOB # 12-024

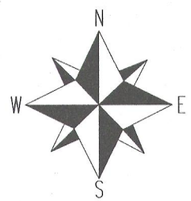

SCALE 1" = 20'

0 20 40 60 80

I have surveyed the above-described property and the above map is a true representation thereof and shows the size and location of the property, its exterior boundaries, the location and dimensions of all structures thereon, fences apparent easements and roadways and visible encroachments. if any.

This survey is made for the exclusive use of the present owners of the property, and also those who puchase, mortgage,or insure the title therto within one (1) year from date hereof; and as to them I warrant the accuracy of said survey map.

WISCONSIN
JOHN P.
KROTT
S-2258
LAKE GENEVA
WIS.
LAND SURVEYOR

DATED THIS 15th DAY OF MARCH 2012

JOHN KROTT S - 2258
Wisconsin Registered Land Surveyor
(original if signed in red)

002-2516