
PREPARED FOR
FRANCISCO BACA
119 N. MAIN ST.
DELAVAN WI. 53115

PLAT OF SURVEY

-OF-

LOT 2 AND THE NORTH 50 FEET OF LOT 3 BLOCK 8 OF THE ORIGINAL PLAT OF THE CITY OF DELAVAN, WALWORTH COUNTY, WISCONSIN.

KROTT SURVEYING INC.
N3705 WILLOW BEND LANE
LAKE GENEVA WI. 53147
PHONE # (262)248-3697
FAX # (262)249-0639

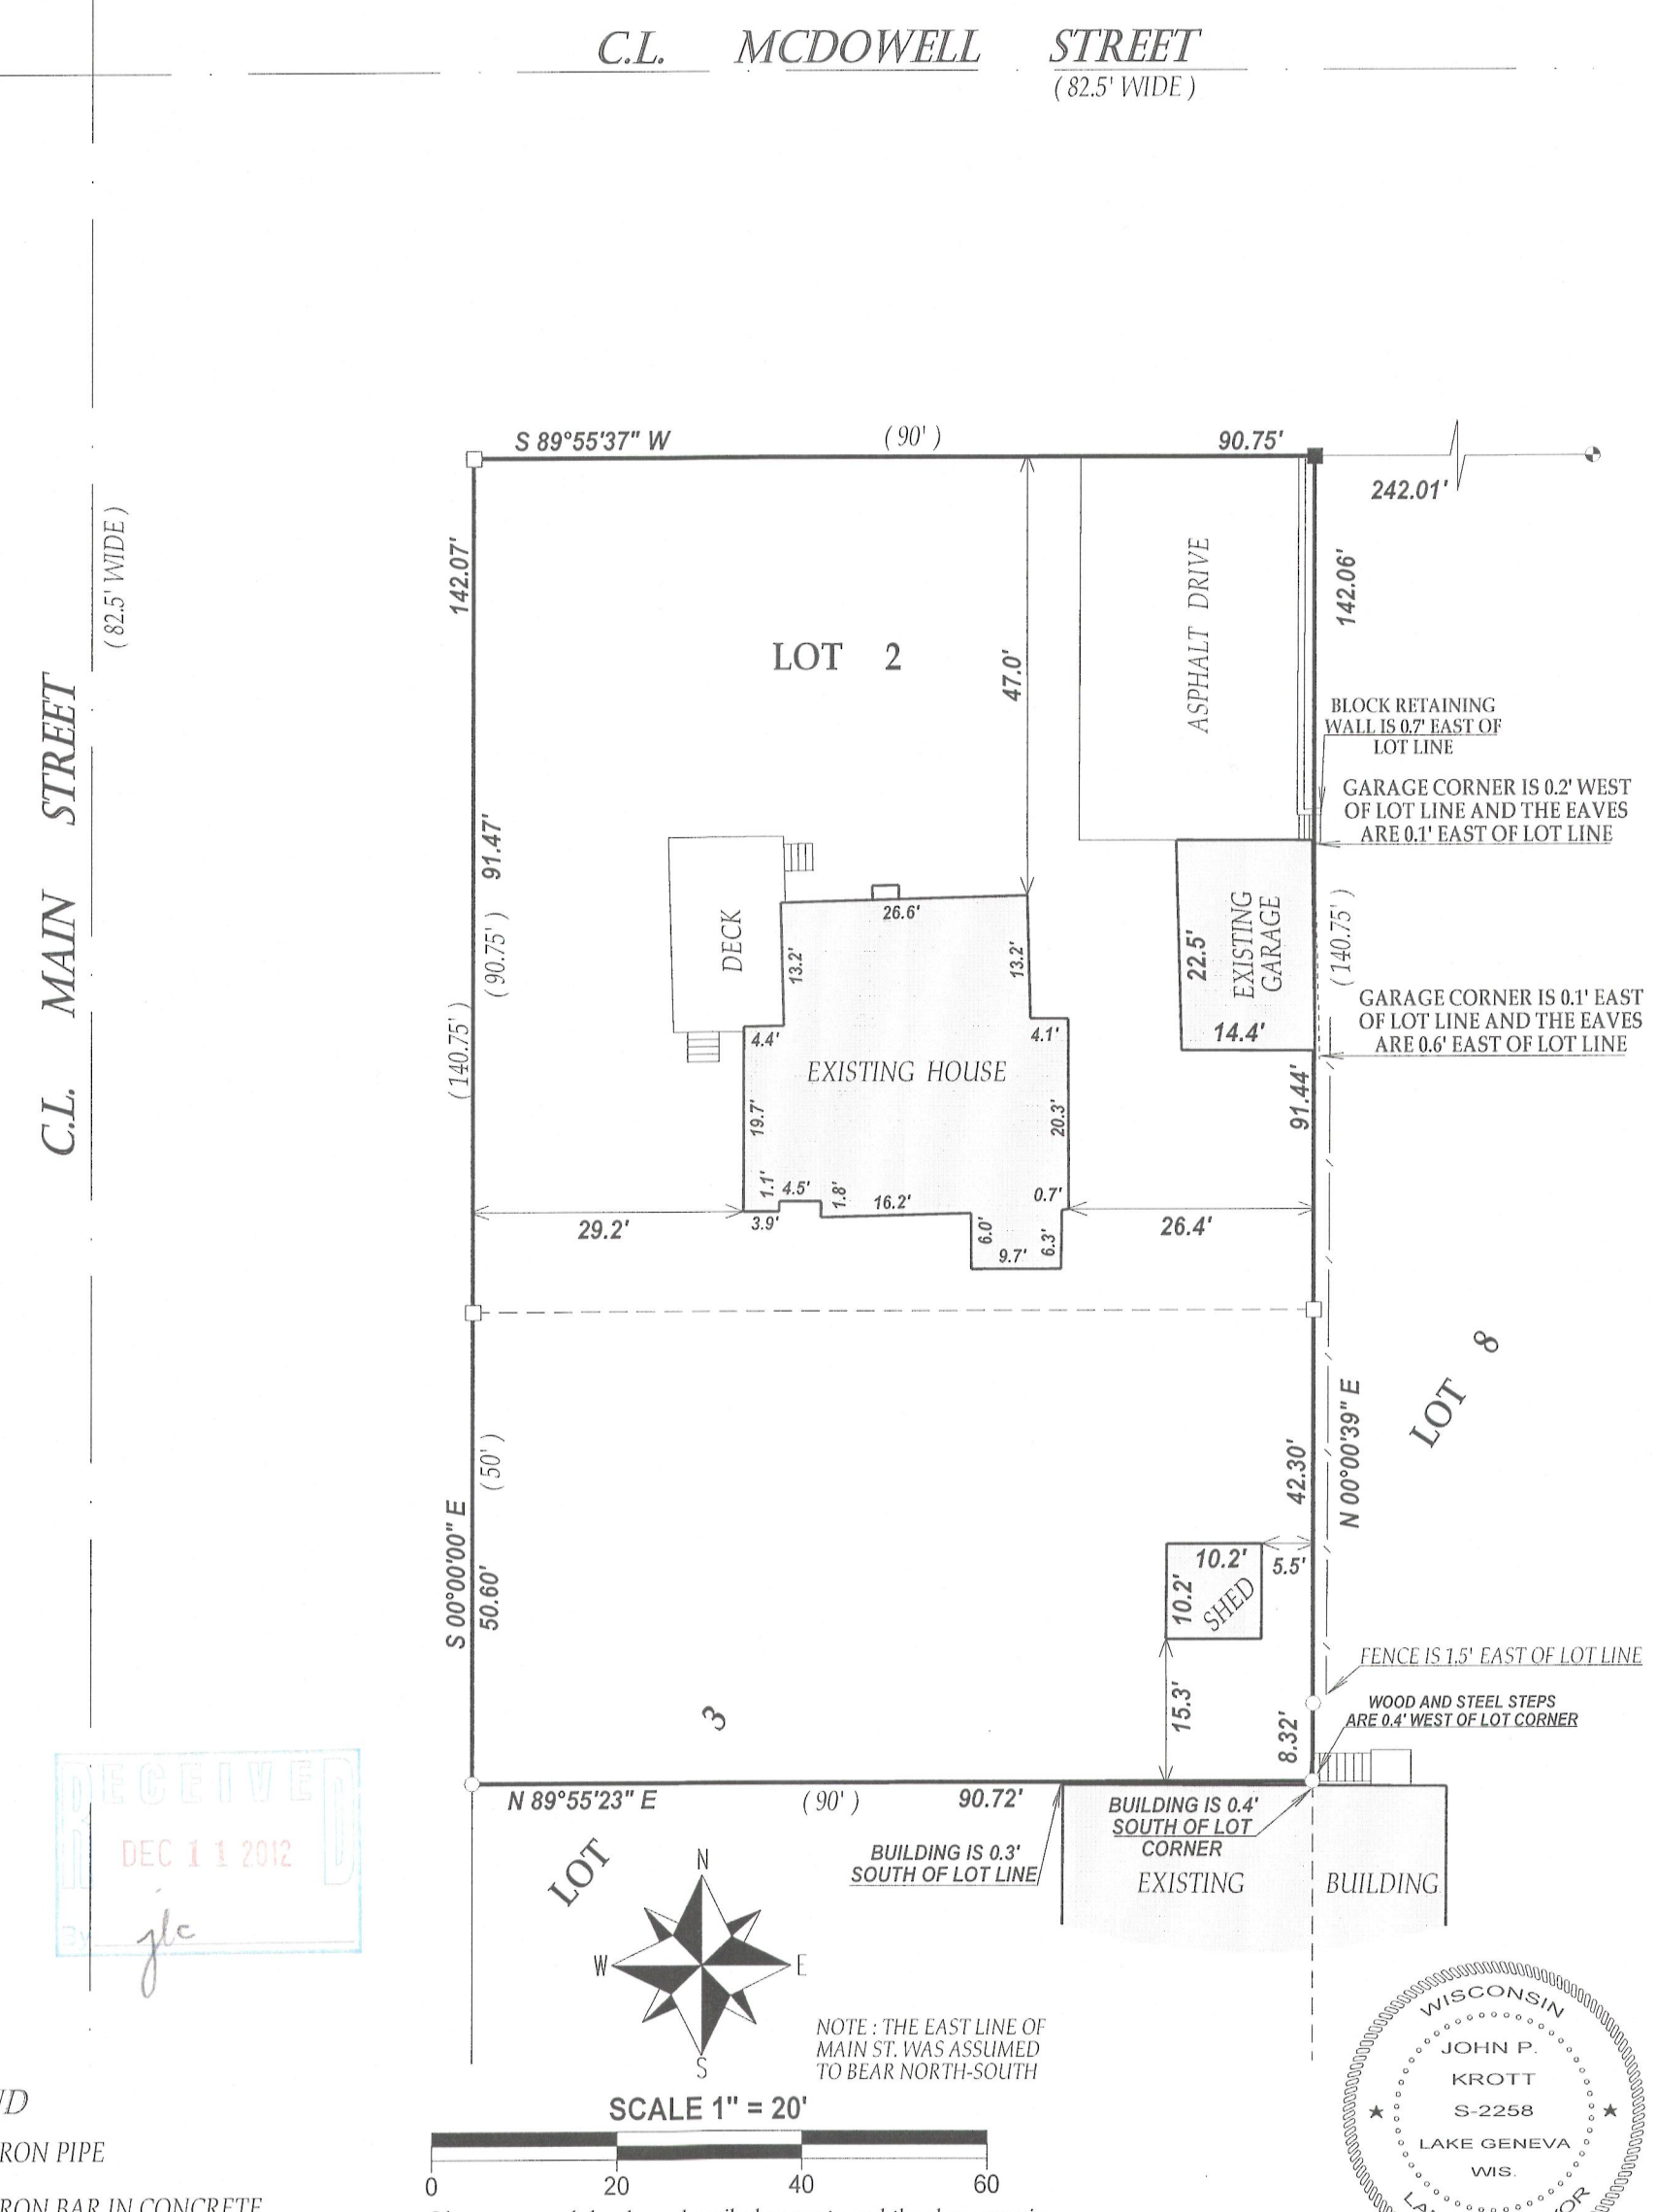

RECEIVED
DEC 11 2012
BY jlc

LEGEND

- ○ FOUND IRON PIPE
- □ FOUND IRON BAR IN CONCRETE
- ◒ FOUND CONCRETE MONUMENT
- ■ SET IRON BAR
- (XX) RECORDED AS

TAX ID # XOP00043

JOB # 12-149

I have surveyed the above-described property and the above map is a true representation thereof and shows the size and location of the property, its exterior boundaries, the location and dimensions of all structures thereon, fences apparent easements and roadways and visible encroachments. if any.

This survey is made for the exclusive use of the present owners of the property, and also those who puchase, mortgage,or insure the title therto within one (1) year from date hereof; and as to them I warrant the accuracy of said survey map.

WISCONSIN
JOHN P.
KROTT
S-2258
LAKE GENEVA
WIS.
LAND SURVEYOR

DATED THIS 13th DAY OF NOVEMBER 2012.

JOHN KROTT S - 2258
Wisconsin Registered Land Surveyor
(original if signed in red)

002-2526