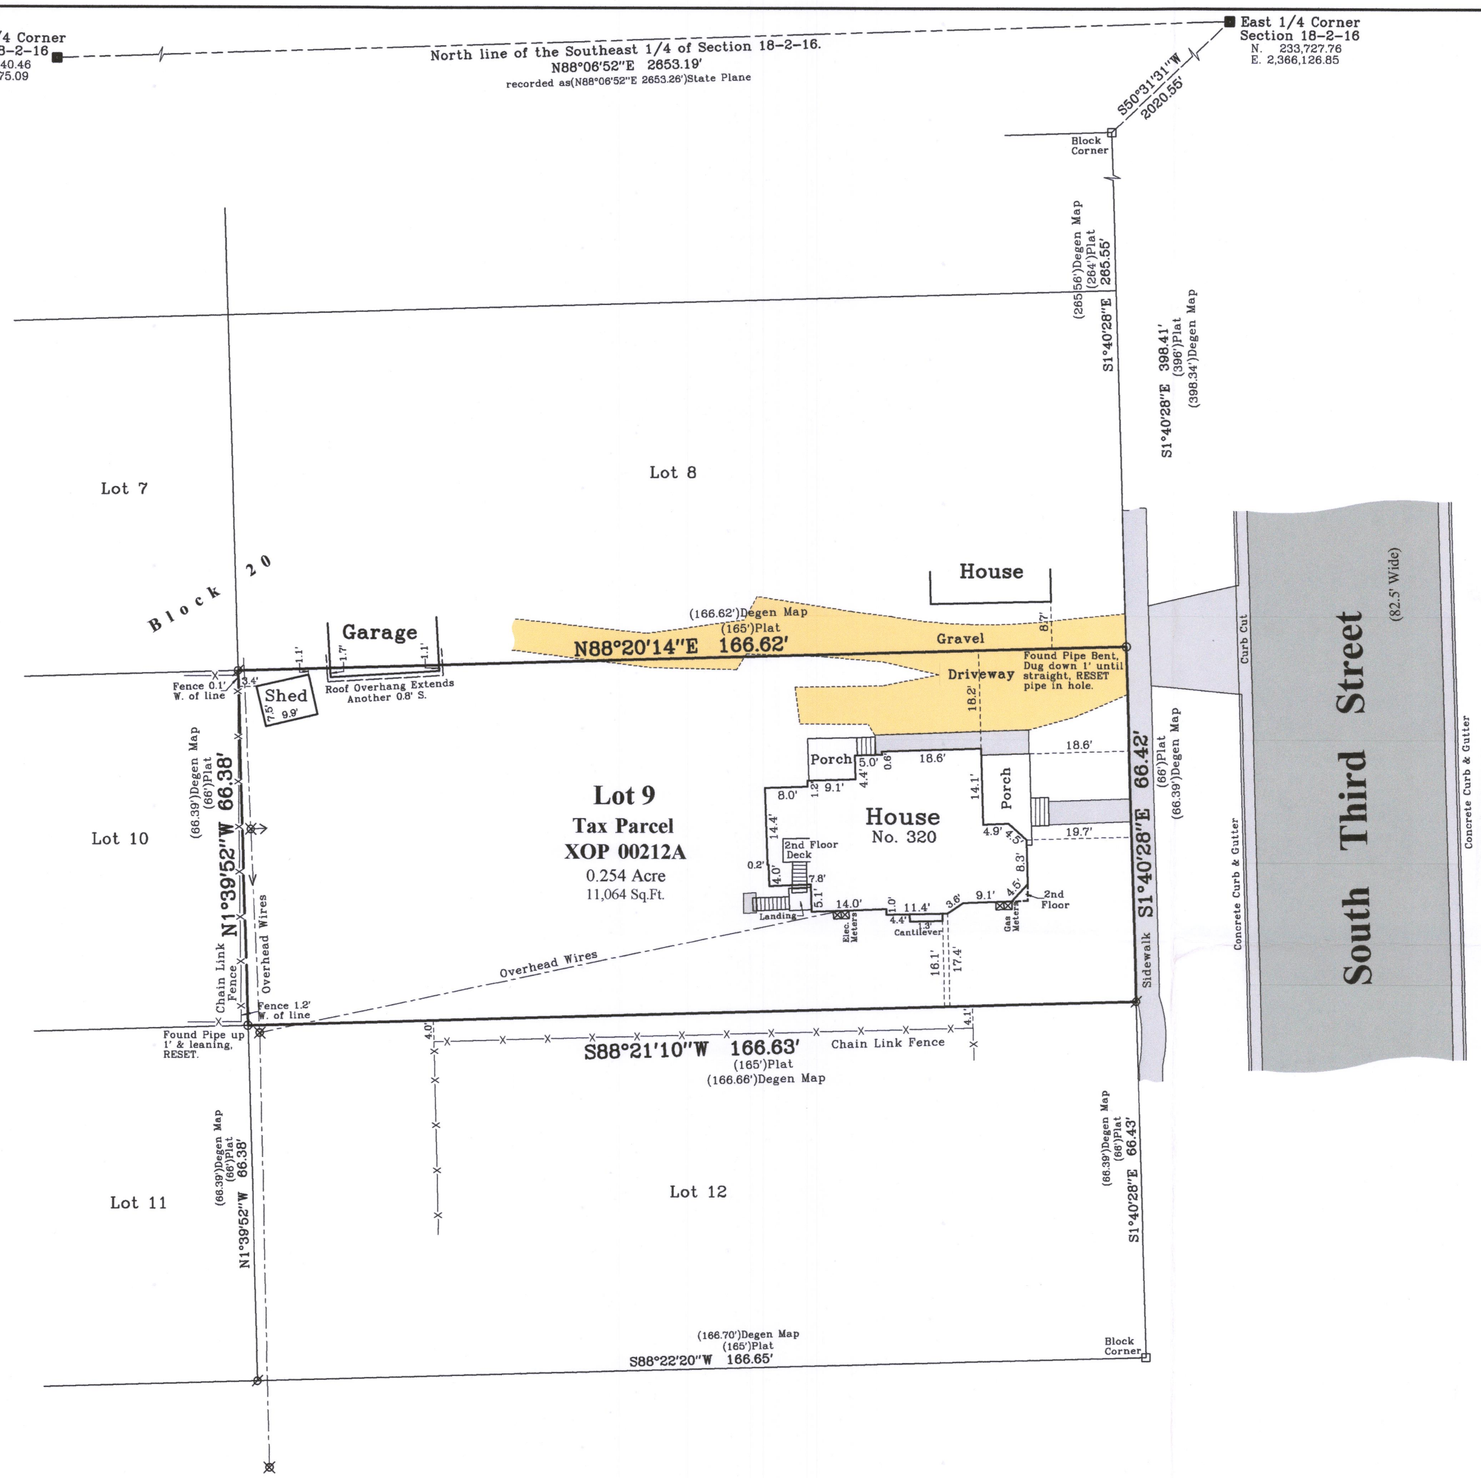


Plat of Survey

of

Lot 9 in Block 20 of the Original Plat of the Village of Delavan,

located in the Southwest 1/4 of the Southeast 1/4 of Section 18, Town 2 North, Range 16 East, City of Delavan, Walworth County, Wisconsin.

Surveyed for: **@properties**
880 West Main Street
Lake Geneva, Wisconsin. 53147



Bearings referenced to the North line of the Southeast 1/4 of Section 18-2-16, recorded as N88°06'52"E in the Wisconsin State Plane Coordinate System, South Zone, (NAD-27).

WISCONSIN
DOUGLAS OLSON S-2093 ELKHORN, WI
LAND SURVEYOR

Not Certified Unless Stamped in Red.

Notes:

1) This Plat of Survey is not certified unless signed and sealed in red ink.
2) This survey is subject to Wisconsin lien laws. This Plat of Survey is the notice of intent to file lien. Lien waiver required.
3) The Survey Date shown on this Plat of Survey is the completion date of the field work.

Copyright ©2018 by Olson Land Surveying, LLC.

All rights reserved. No part of this survey plat may be reproduced or transmitted in any form by any means - graphic, electronic, or mechanical, including photocopying, tracing, or information storage and retrieval systems - without permission in writing from Douglas G. Olson, Olson Land Surveying, LLC.

RECEIVED
NOV 19 2018
By Jan

I hereby certify that I have surveyed the above described property in compliance with Chapter A-E 7 of the Wisconsin Administrative Code and that the map hereon is correct to the best of my professional knowledge and belief and shows the size and location of the property, its exterior boundaries, the location and dimensions of all visible structures thereon, boundary fences, apparent easements and roadways and visible encroachments, if any.

This survey is made for the exclusive use of the present owners of the property, and also those who purchase, mortgage or guarantee title thereto, within one year from the date hereof.

Douglas G. Olson
Wisconsin Professional Land Surveyor - 2093

XOP-212A 002-2659

Survey Date: July 23, 2018.
Revisions:

Scale in Feet
1" = 20'
0' 10' 20' 40' 60'

45 South Wisconsin Street | P.O. Box 322
Elkhorn, Wisconsin 53121
Telephone: (262) 723-3434
Facsimile: (262) 723-8044
Email: doug@olsonsurveying.com
Website: www.olsonsurveying.com

OLSON
LAND SURVEYING, LLC
Rural | Residential | Commercial

Legend of Symbols & Abbreviations

- Found County Section Corner
- Found Concrete Monument
- Found Iron Pipe
- Set Iron Pipe, 1" dia.
- Recorded As Information
- Utility Pole
- Utility Pedestal
- Asphalt Surface
- Concrete Surface
- Gravel Surface

N North, S South, E East, W West
In Bearings: Degrees °, Minutes ', Seconds "
In Distances: Feet ', Inches "

Sheet 1 of 1 Sheets

Drawing Name:

Job Reference Number
2018.094

2018.094