
PLAT OF SURVEY

OF LOT 30, BLOCK 3, FIRST ADDITION TO CHESTNUT RIDGE SUBDIVISION WEST, BEING PART OF THE NE 1/4 AND SE 1/4 OF THE SW 1/4 OF SECTION 13, T. 2 N., R. 15 E., OF THE 4TH P.M., CITY OF DELAVAN, WALWORTH COUNTY, WISCONSIN.

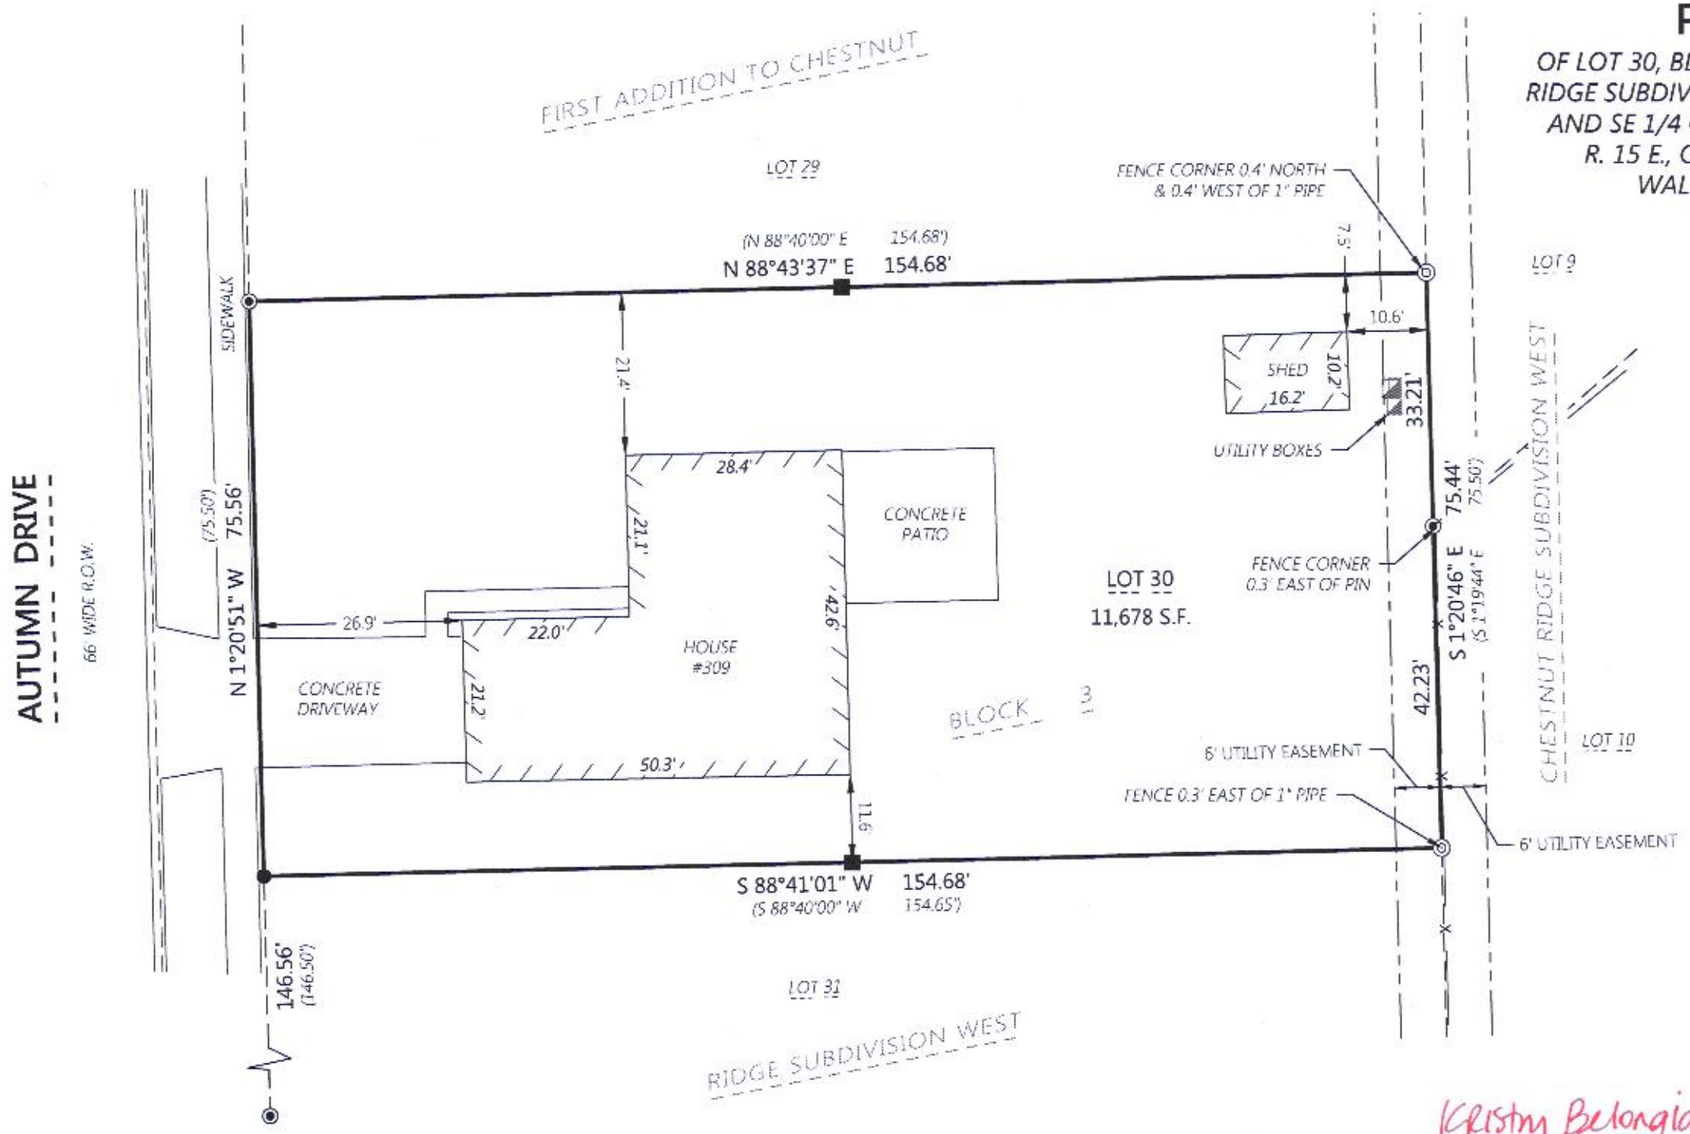

Scale: 1" = 20'

0 10 20 40

BEARINGS BASED ON THE EAST LINE OF AUTUMN DRIVE RECORDED AS BEARING N 1°20'51" W

RECEIVED
AUG 20 2019
By

MONUMENT KEY

- ● Iron Rebar Set 3/4" x 24"(1.5 Lbs./Ft.)
- ◉ 3/4" Iron Rebar Found
- ◎ Iron Pipe Found
- ■ Set Lath
- (XXX.XX) Record Information

WISCONSIN
KRISTIN J. BELONGIA S-2943 ELKHORN WIS.
LAND SURVEYOR

Kristin Belongia

Kristin J. Belongia, P.L.S.
Wisconsin Professional Land Surveyor S-2943

State of Wisconsin } ss
County of Rock }

If the surveyor's signature is not red in color, the plan is a copy that should be assumed to contain unauthorized alterations.
The certification contained on this document shall not apply to any copies.

I hereby certify that I have supervised the survey of the property described above and to the best my knowledge and belief, the plat drawn hereon complies with Chapter A-E 7 of the State of Wisconsin Administrative Code, Minimum Standards for Property Surveys and correctly represents said survey and its location.
Given under my hand and seal this 16th day of May, 2019 at Beloit, Wisconsin.
Last day of field work May 1st, 2019

Batterman engineers surveyors planners
2857 Barrells Drive Beloit, Wisconsin 53511
608.365.4464 www.rhbatterman.com

PLAT OF SURVEY

FOR THE EXCLUSIVE USE OF:
FRANCISCA REYNA
PO BOX 941
DELAVAN, WI 53115

ORDER NO: 33296
ROCK: SEE FILE
FIELD CREW: DGW
DRAWN BY: KJB

File Name: I:\ST\WW\33296\dwg\33296 - Autumn Drive, DELAVAN BOUNDARY SURVEY.dwg

XCRW1 -28 002-2678