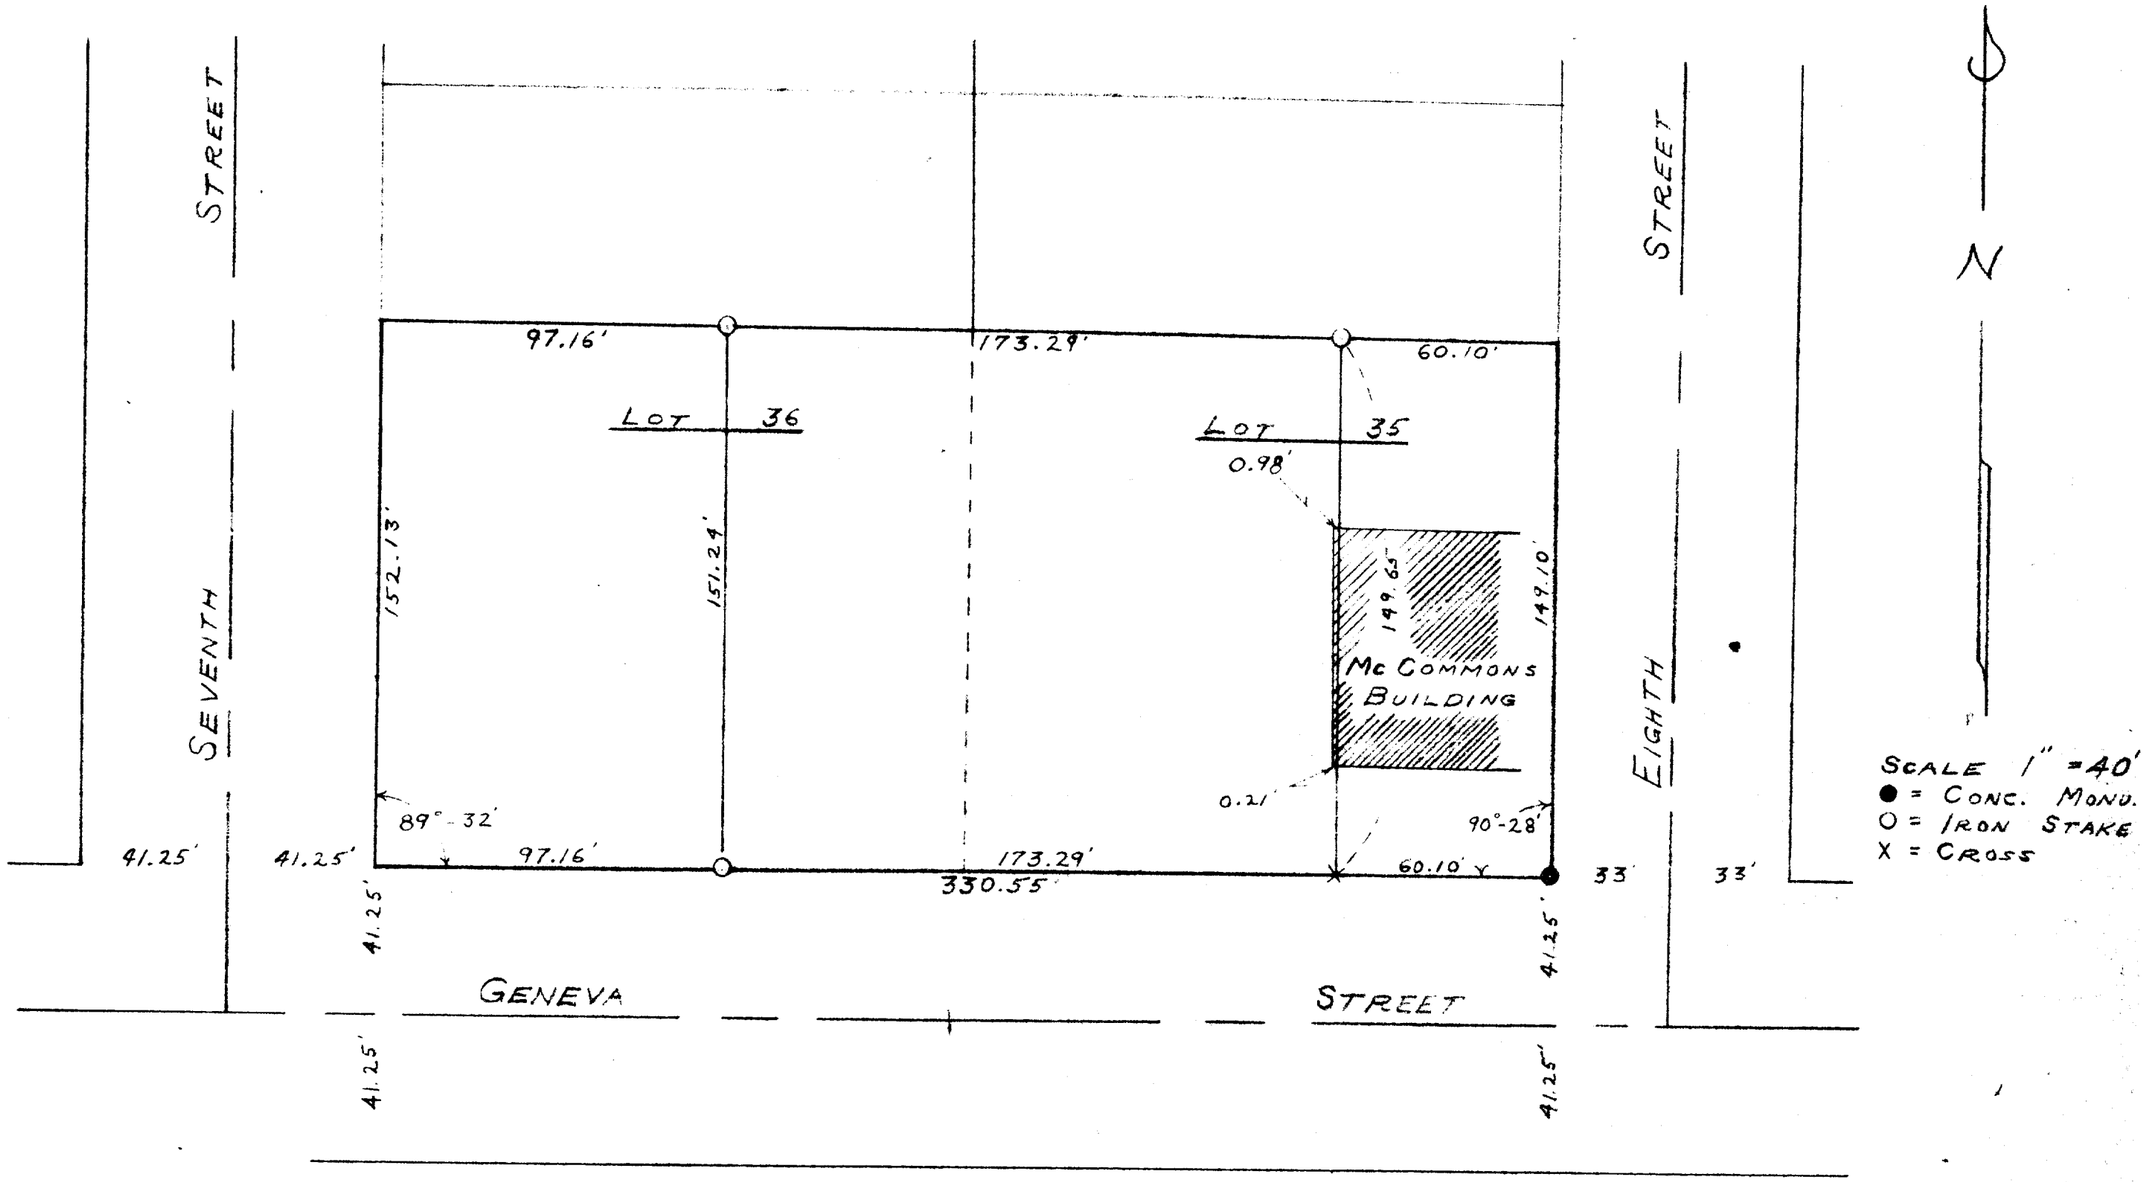

PLAT OF SURVEY OF PART OF LOTS 35 AND 36 BLOCK 13 PASSAGE, ARAM AND DOWNIE ADDITION LYING IN THE CITY OF DELAVAN WALWORTH COUNTY, WISCONSIN
APRIL 9, 1952

Floyd L. Jensen
COUNTY SURVEYOR

XP-179-180-181-182

2-26 J