
LAKELAND SURVEYORS LLC
P O BOX 188
DELAVAN, WI 53115
262-475-9567
email: lakelandsurveyors@outlook.com

PLAT OF SURVEY

OF

LOT 3, CERTIFIED SURVEY MAP NO. 33, LOCATED IN THE CITY OF DELAVAN, WALWORTH COUNTY, WISCONSIN.

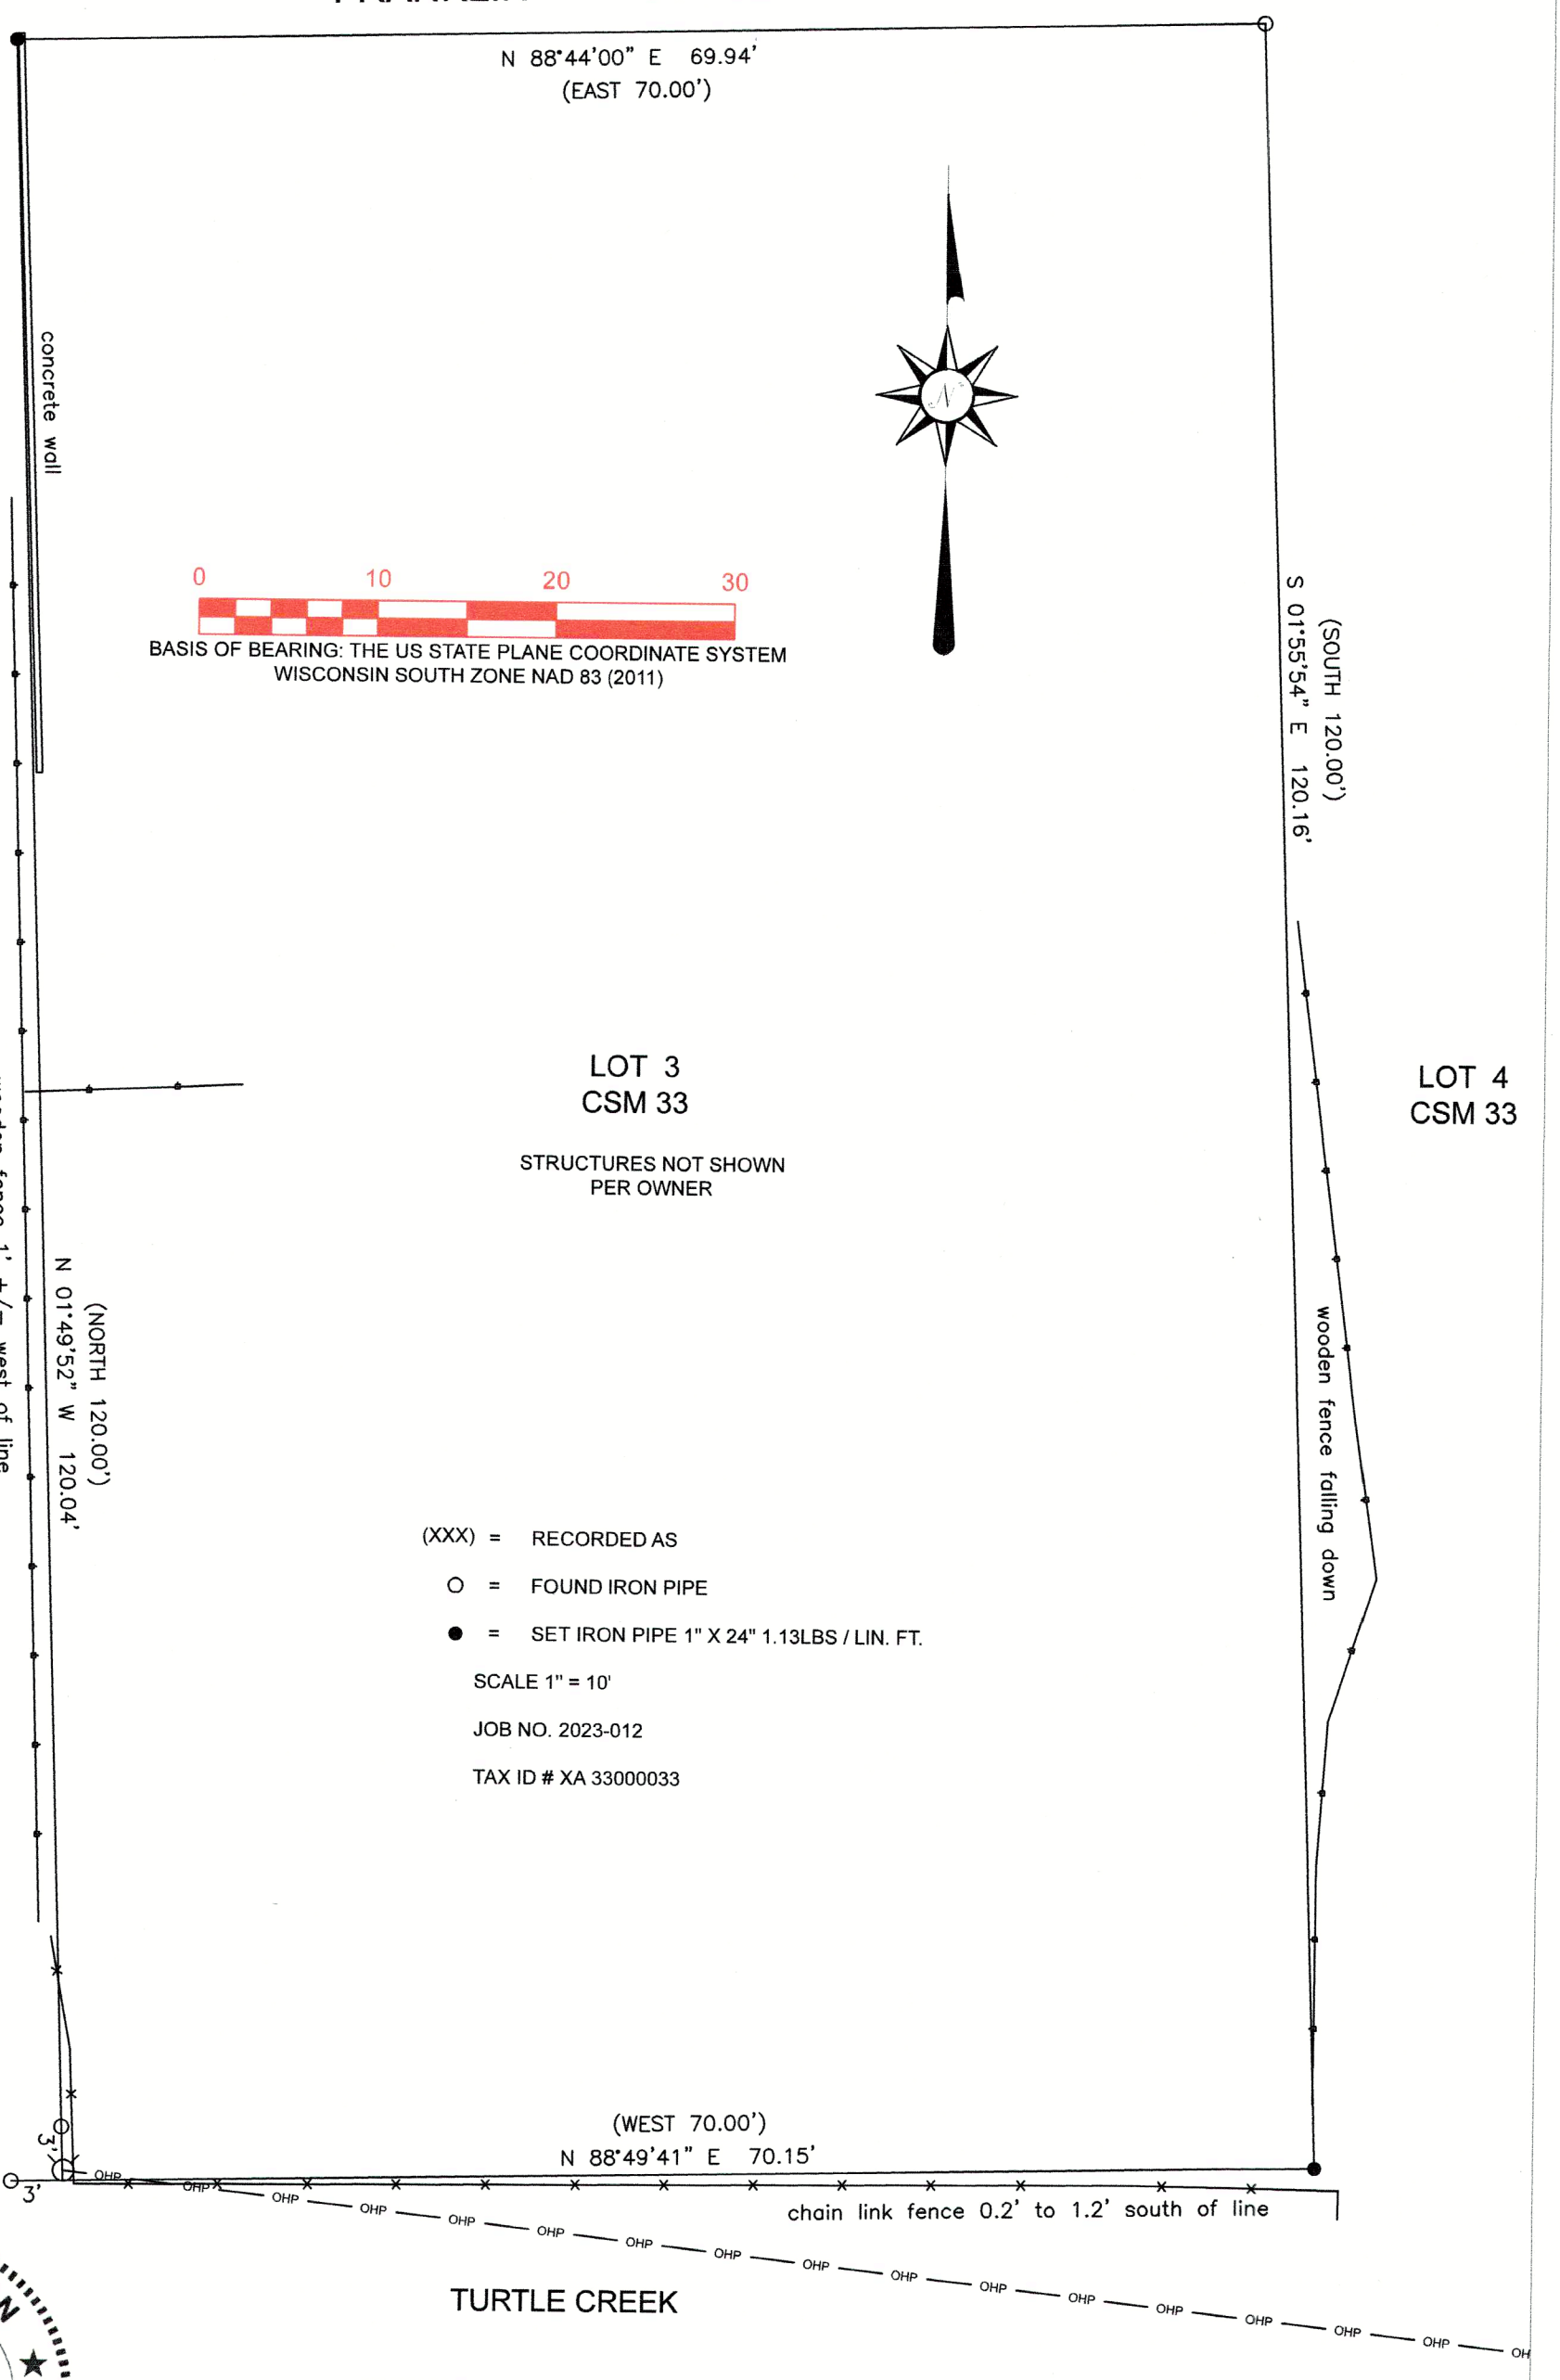

RECEIVED
MAY 23 2023
By SMF

WISCONSIN
STEVEN L. SCHMIDT
S-2813
ELKHORN
WI
LAND SURVEYOR

Steve Schmidt

STEVEN L SCHMIDT S - 2813
Wisconsin Professional Land Surveyor

PREPARED FOR:
DEANNE FURSETH

I HEREBY CERTIFY THAT I HAVE SURVEYED THE ABOVE DESCRIBED PROPERTY AND THE ABOVE MAP IS A TRUE REPRESENTATION THEREOF AND SHOWS THE SIZE AND LOCATION OF THE PROPERTY, ITS EXTERIOR BOUNDARIES, THE LOCATION AND DIMENSIONS OF ALL STRUCTURES THEREON, FENCES, APPARENT EASEMENTS, ROADWAYS, AND VISIBLE ENCROACHMENTS, IF ANY.

THIS SURVEY IS MADE FOR THE PRESENT OWNERS OF THE PROPERTY AND THOSE WHO PURCHASE, MORTGAGE, OR GUARANTEE THE TITLE THERETO WITHIN ONE YEAR FROM THIS DATE HEREOF.

DATED THIS 4TH DAY OF MAY 2023

XA 33000033

002-2772