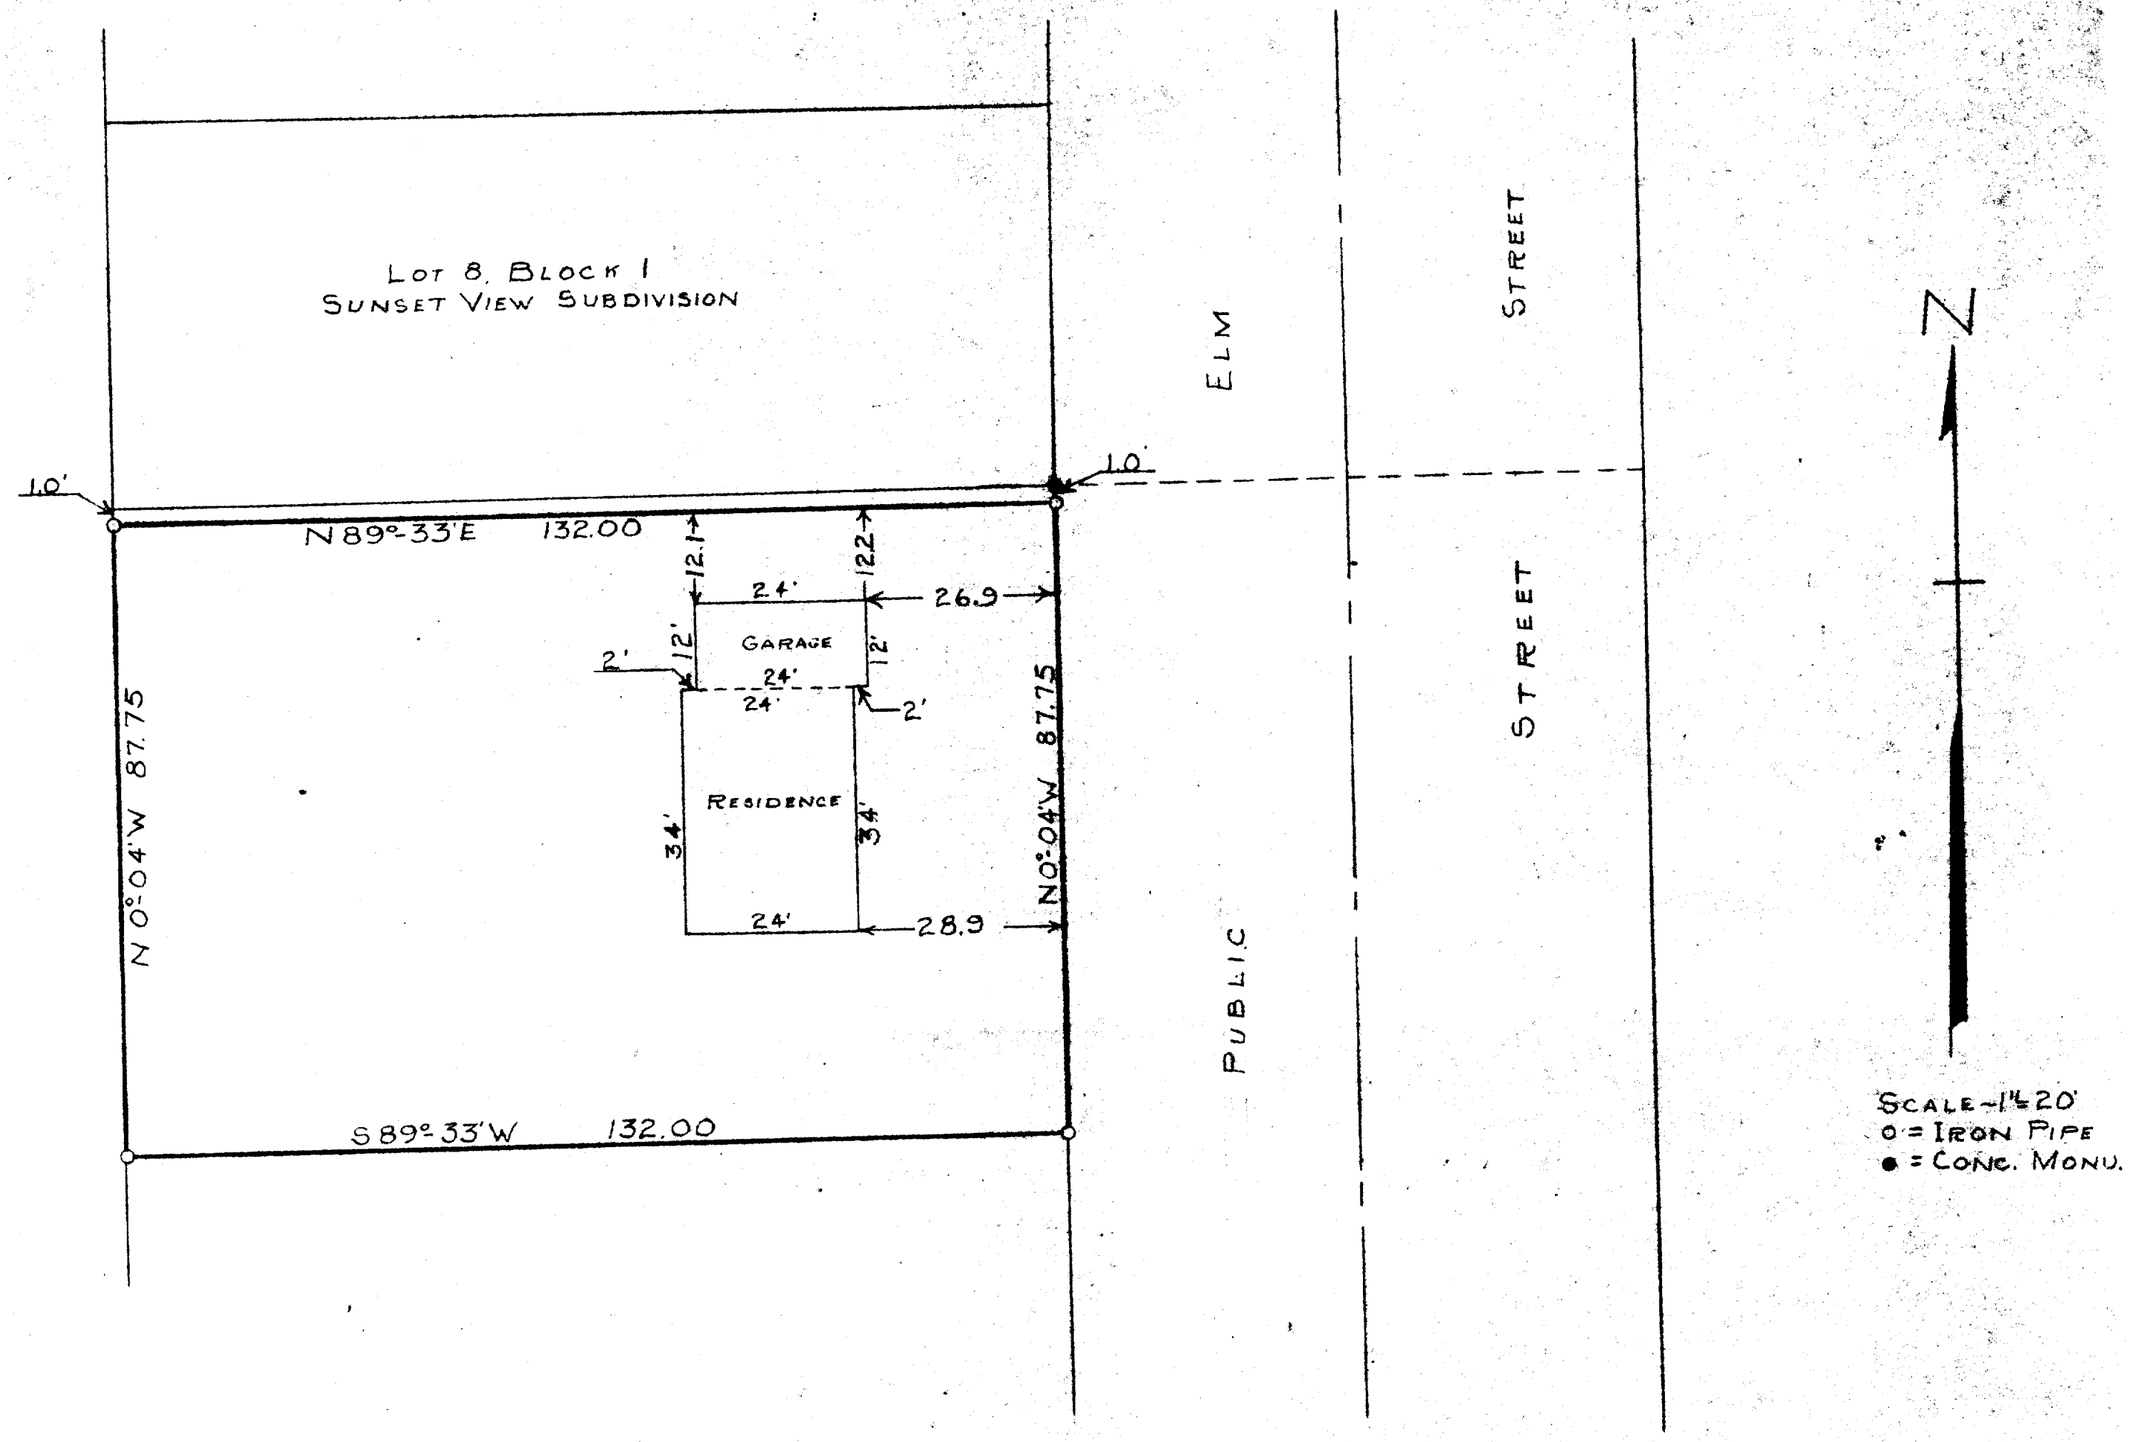

STATE OF WISCONSIN) SS
COUNTY OF WALWORTH)

I, GEORGE T. DUNHAM, DO HEREBY CERTIFY THAT I HAVE SURVEYED THE PROPERTY DESCRIBED AS FOLLOWS:

COMMENCING AT A CONCRETE MONUMENT LOCATED AT THE S.E. CORNER OF LOT 8, BLOCK 1, SUNSET VIEW SUBDIVISION; THENCE S 0°-04'E ON THE WEST LINE OF ELM STREET PRODUCED SOUTH 1.0 FEET TO THE PLACE OF BEGINNING; THENCE CONTINUE S 0°-04'E 87.75 FEET TO A POINT; THENCE S 89°-33'W 132.00 FEET TO A POINT; THENCE N 0°-04'W 87.75 FEET TO A POINT 1.0 FEET SOUTH OF THE S.W. CORNER OF SAID LOT 8; THENCE N 89°-33'E 132.00 FEET TO THE PLACE OF BEGINNING; SAID PARCEL OF LAND IS LOCATED IN THE SW 1/4 OF SECTION 18 T2NR16E, CITY OF DELAVAN, WALWORTH COUNTY, WISCONSIN.

87.75

AND THAT THE PLAT SHOWN ABOVE IS A CORRECT REPRESENTATION OF THE PROPERTY LINES

JUNE 27, 1953

George T. Dunham
GEORGE T. DUNHAM
DELAVAN, WISCONSIN
SURVEYOR

XUP-120A

7-28