


CURVE TABLE				
CURVE NO.	DELTA	RADIUS	ARC	CHORD BEARING
C-1	38°39'50"	508.75'	343.31'	S 76°51'48" W
C-2	5°46'01"	508.75'	51.21'	N 80°55'17" W

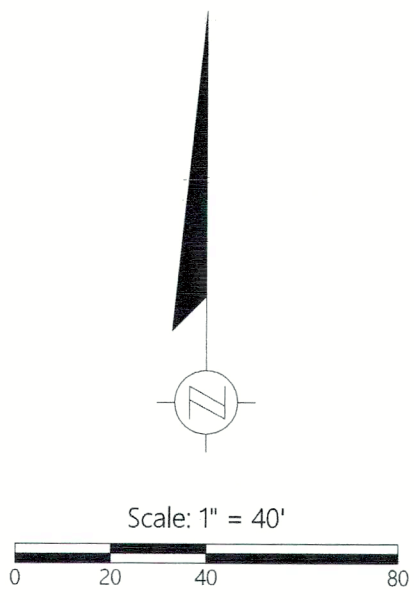


DISTANCE UNITS BASED ON THE UNITED STATES SURVEY FOOT
BEARINGS BASED ON THE WISCONSIN COORDINATE REFERENCE SYSTEM, WALWORTH ZONE.
VERTICAL DATUM BASED ON NAVD-88 (2012)
GEOID 18 WISCONSIN
STARTING BENCHMARK: NGS DP9657

- MONUMENT KEY**
- Iron Rebar Set
3/4" x 24" (1.5 Lbs./Ft.)
 - Mag Nail Set
 - ⊙ 3/4" Iron Rebar Found

- LEGEND**
- Existing Boundary Line
 - - - Existing Right-of-Way
 - - - Existing Adjacent Property
 - - - Existing Centerline
 - - - Existing Easement Line
 - - - Existing Section Line
 - X - Existing Fence
 - Wetland
 - G - Existing Gas Main
 - Curve Chord/Radius Line
 - E - Existing Electric
 - T - Existing Telephone
 - Existing Telephone Pedestal
 - Existing Utility Vault
 - Existing Light Pole
 - Existing Manhole
 - W - Existing Watermain
 - Existing Water Valve
 - Existing Fire Hydrant
 - ST - Existing Storm Sewer
 - Existing Curb Inlet
 - Existing Storm Manhole
 - Existing Sanitary Manhole
 - Existing Sanitary Sewer
 - Soil Boring
 - Existing Sign
 - Benchmark

PLAT OF SURVEY
LOTS 3 & 4 OF CERTIFIED SURVEY MAP NO. 4891, BEING PART OF
THE SW 1/4 OF THE SE 1/4 OF SECTION 9, T. 2 N., R. 16 E., OF THE
4TH P.M., CITY OF DELAVAN, WALWORTH COUNTY, WISCONSIN

SURVEYOR'S NOTE:
LOCATION OF UTILITIES ON OR SERVING THE SURVEYED PARCEL HAVE BEEN DETERMINED BY OBSERVED EVIDENCE, AND MARKINGS REQUESTED BY THE SURVEYOR BY A DIGGERS HOTLINE REQUEST, TICKET NUMBER 20233419727, 20233419729 WITH A START DATE OF AUGUST 29, 2023, AND RELOCATE TICKETS 20233518547, 20233518580 WITH A START DATE OF AUGUST 31, 2023. LACKING EXCAVATION, THE EXACT LOCATION OF UNDERGROUND FACILITIES CANNOT BE ACCURATELY, COMPLETELY, AND RELIABLY DEPICTED. IN ADDITION, UTILITY LOCATED REQUESTS FROM SURVEYORS MAY BE IGNORED OR RESULT IN AN INCOMPLETE RESPONSE. MEMBERS NOTIFIED WITH DIGGERS HOTLINE REQUEST ARE ALLIANT ENERGY, CITY OF DELAVAN, EDGE BROADBAND, AT&T DISTRIBUTION, AND WE ENERGIES-WE GAS.

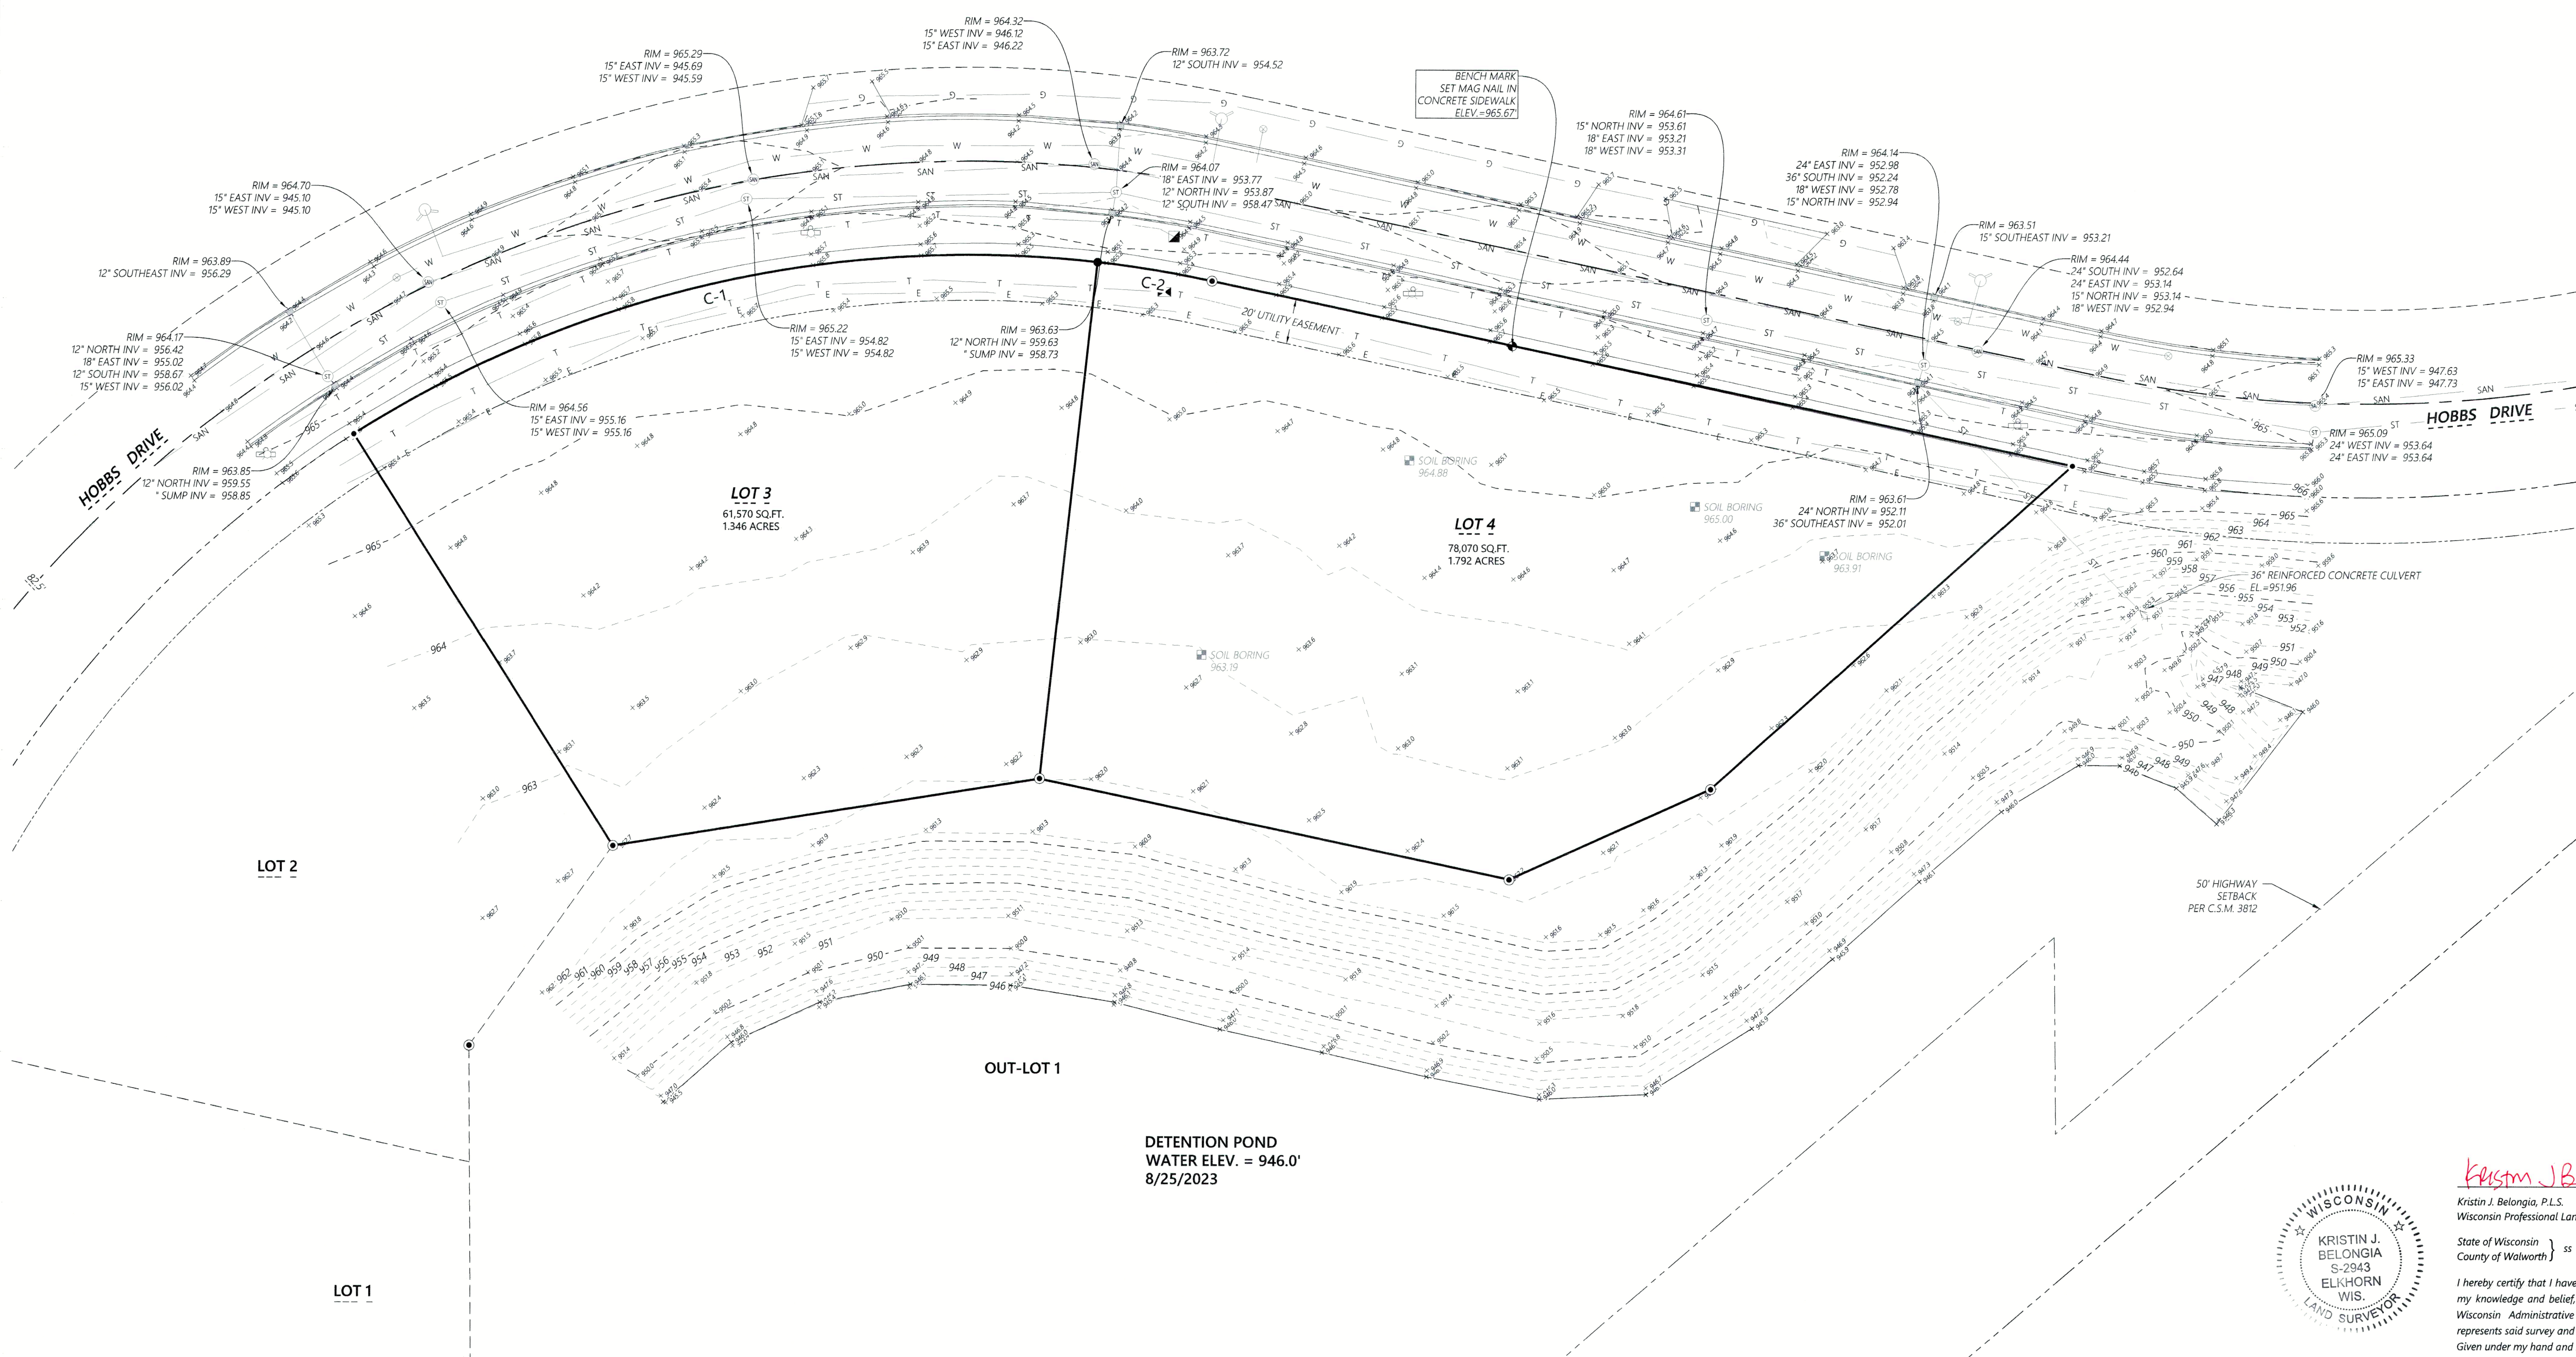

Kristin J. Belongia
Kristin J. Belongia, P.L.S.
Wisconsin Professional Land Surveyor S-2943

State of Wisconsin ss
County of Walworth

I hereby certify that I have supervised the survey of the property described above and to the best of my knowledge and belief, the plat drawn hereon complies with Chapter A-E 7 of the State of Wisconsin Administrative Code, Minimum Standards for Property Surveys and correctly represents said survey and its location.
Given under my hand and seal this 5th day of September, 2023 at Beloit, Wisconsin.
Last day of field work: August 31, 2023.