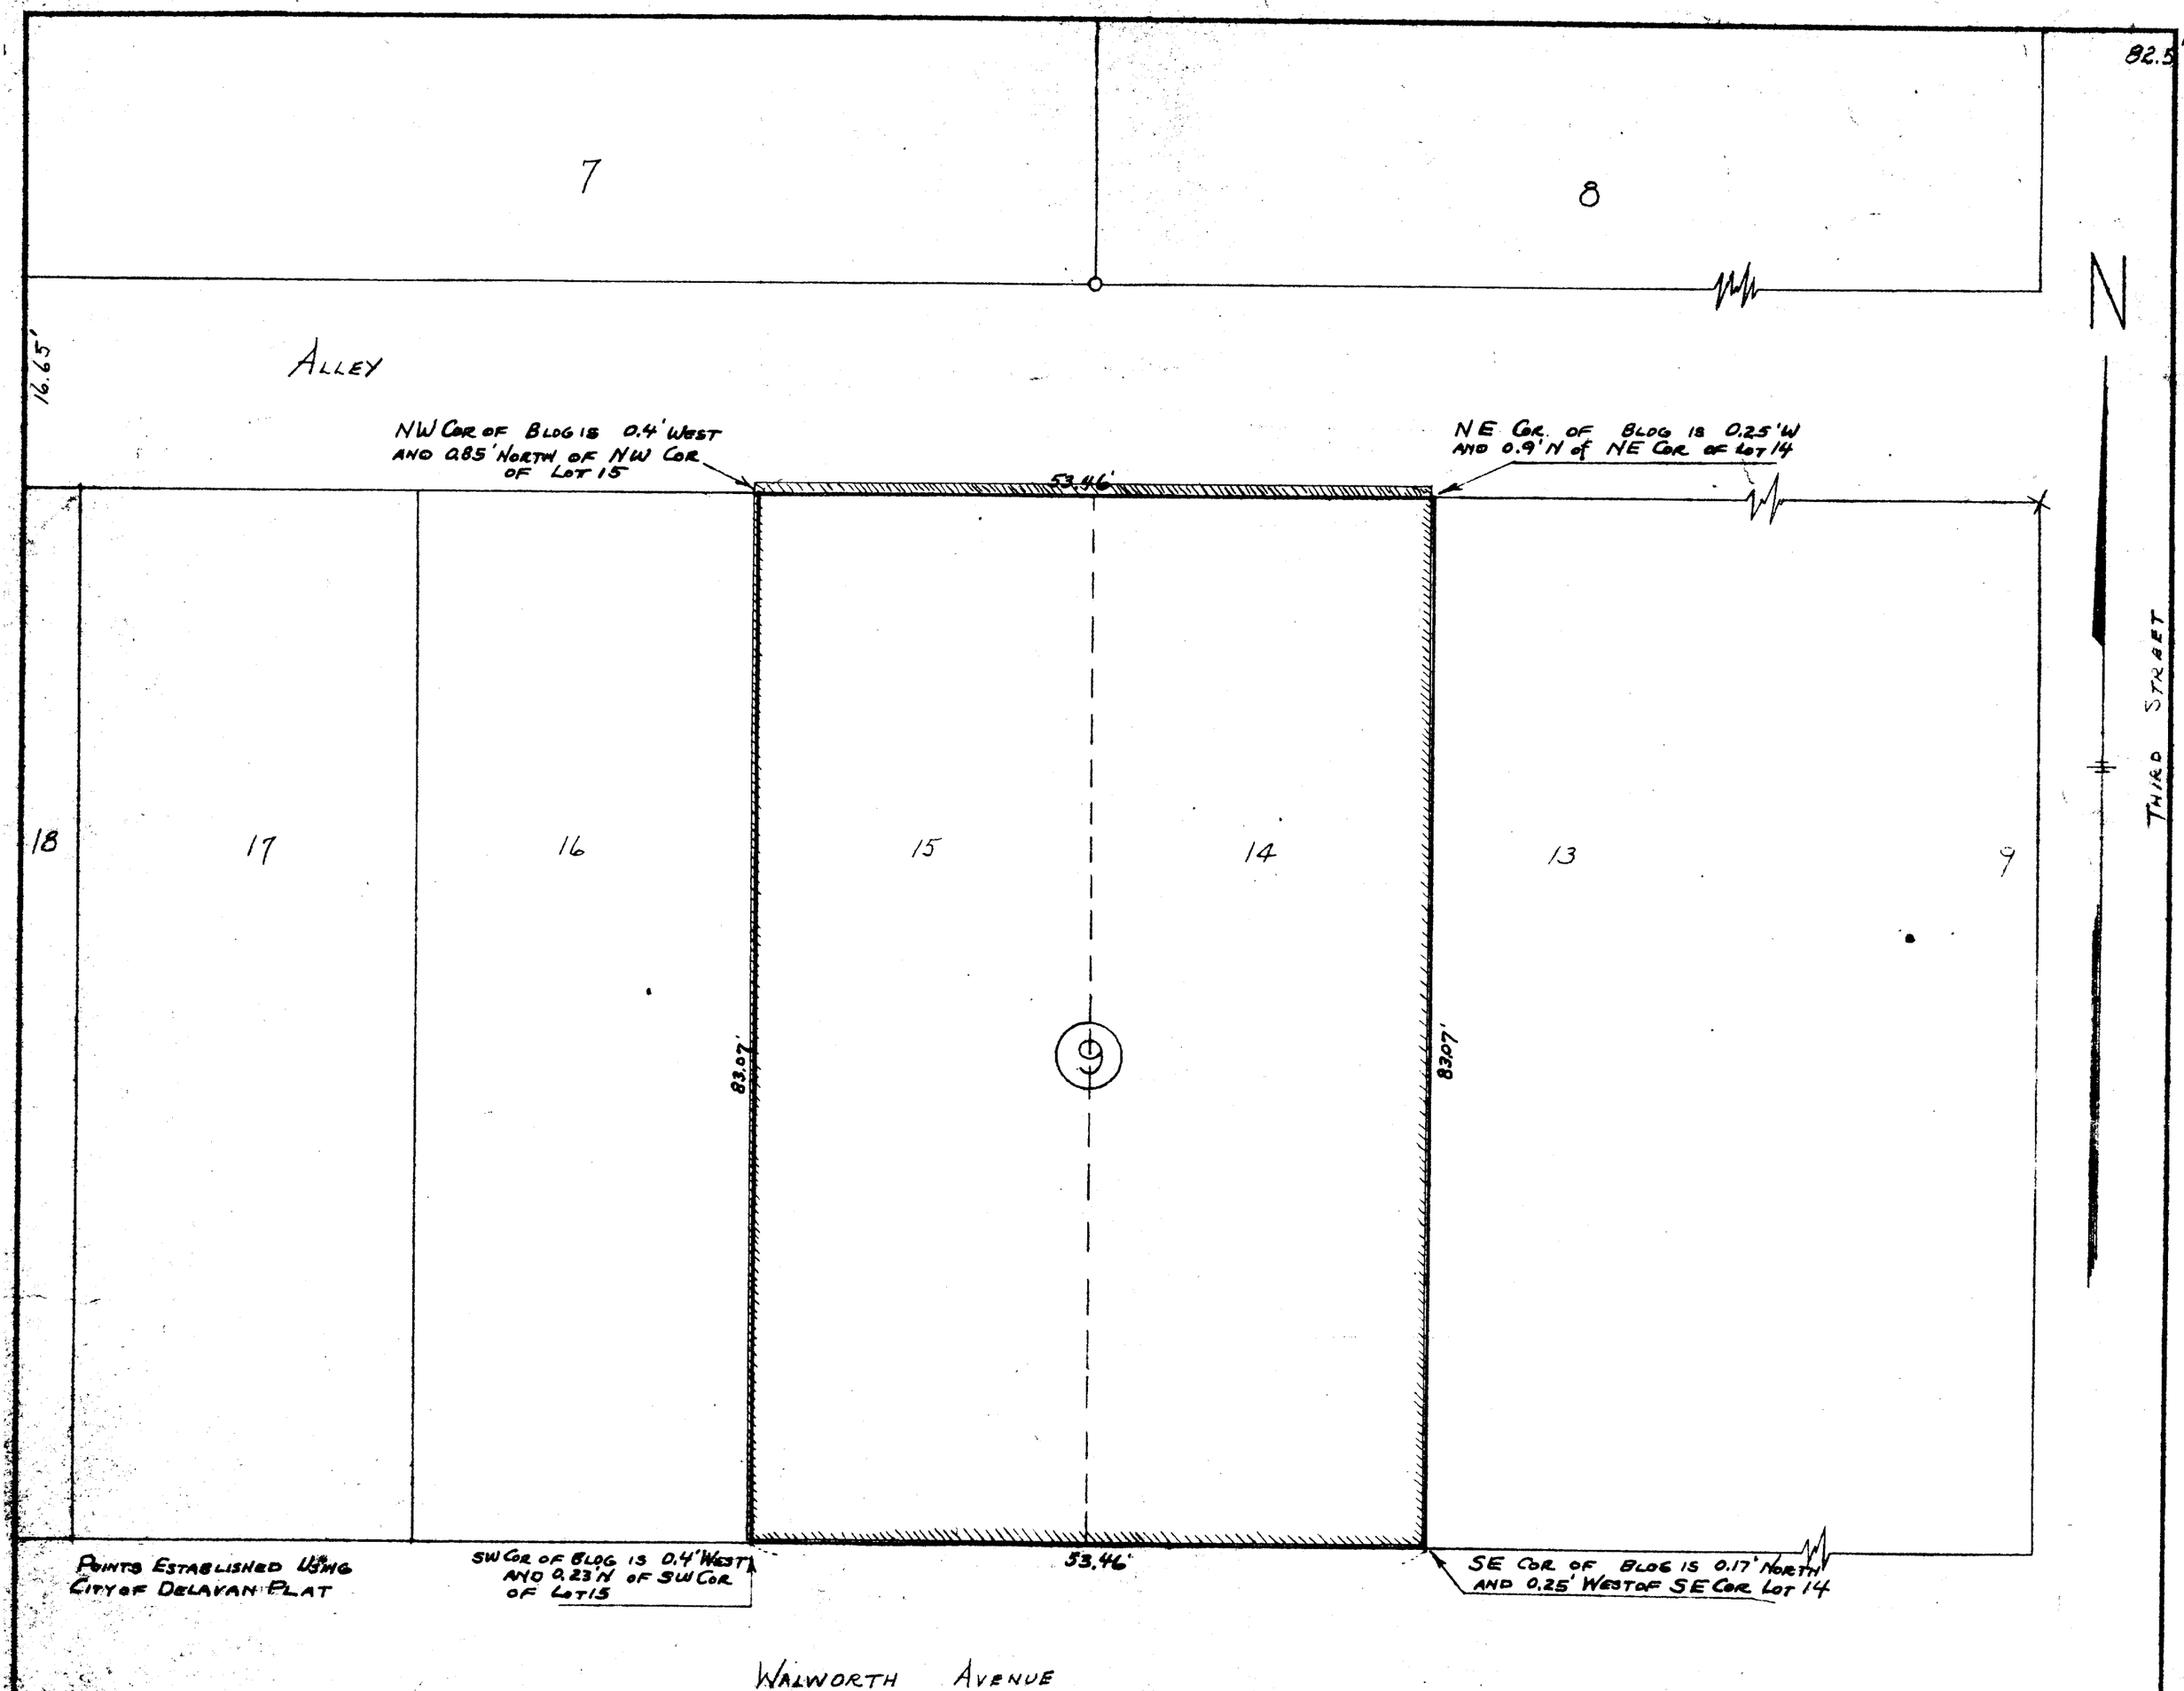

PLAT OF SURVEY
OF

LOTS 14 AND 15 OF BLOCK 9 OF THE ORIGINAL PLAT OF THE CITY OF DELAVAN WALWORTH COUNTY, WISCONSIN

Floyd L. Jensen
SURVEYOR

SCALE 1" = 10'

DATE MARCH 1955

2-30 J