
GEORGE T. DUNHAM
SURVEYING & SUBDIVIDING
DELAVAN, WISCONSIN

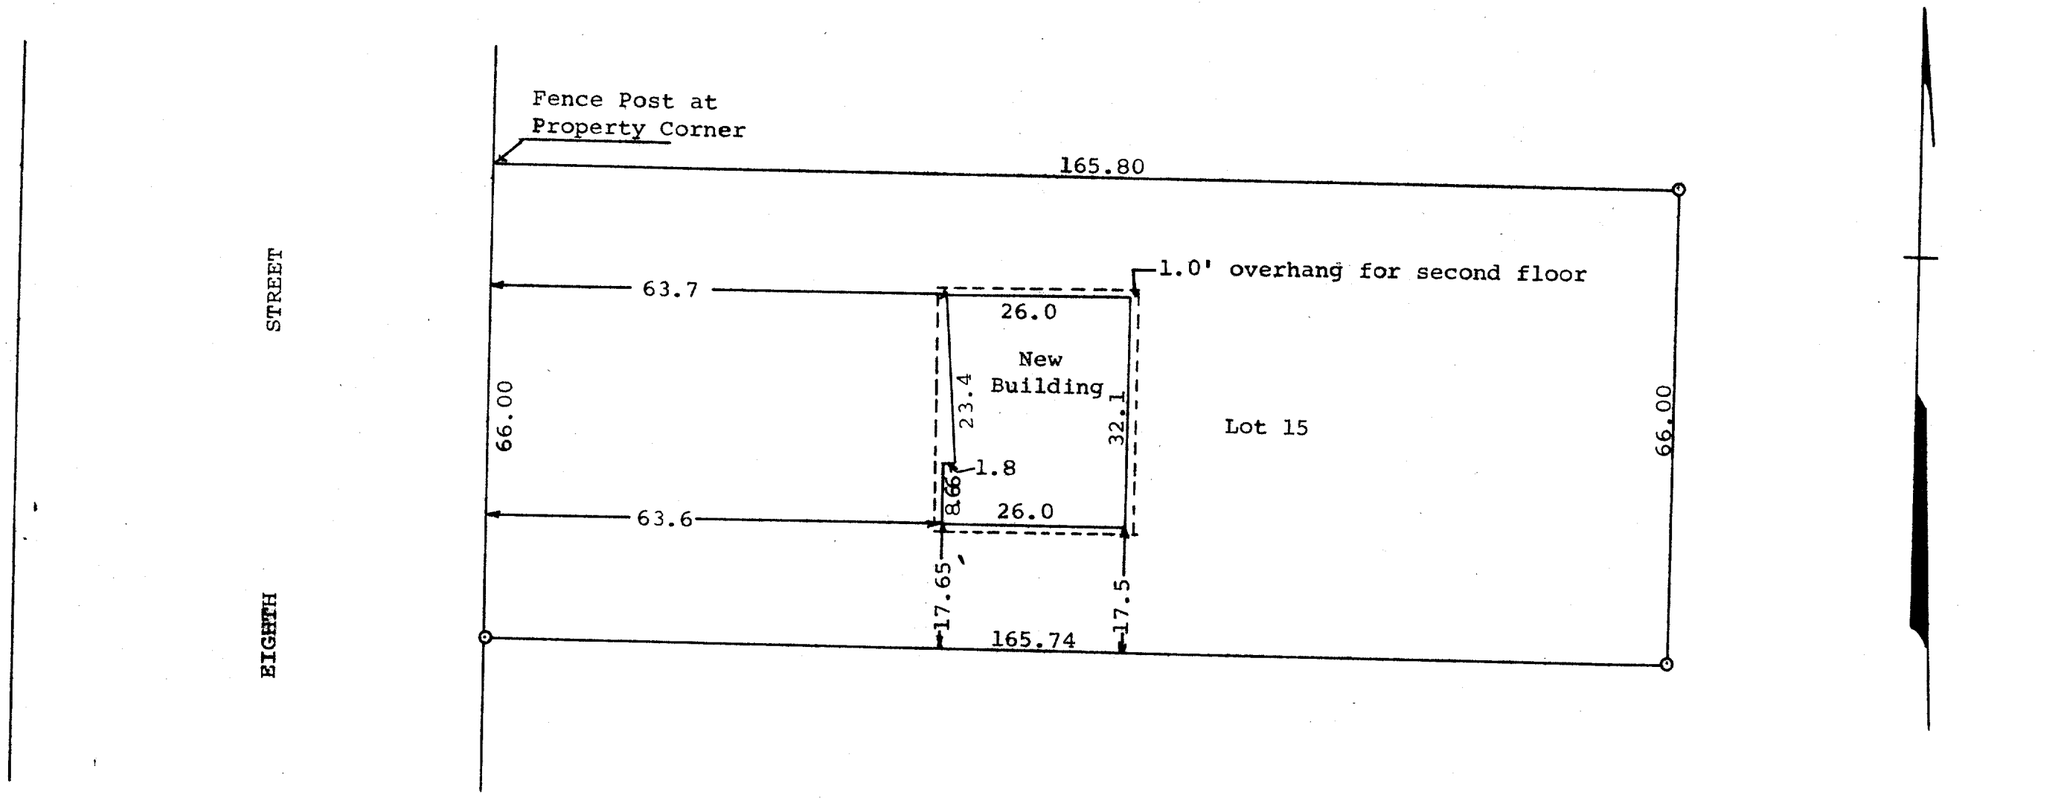

Scale - 1" = 20'
O = Iron Pipe

STATE OF WISCONSIN)
WALWORTH COUNTY) SS

I, George T. Dunham, Surveyor, certify that I have surveyed the property described as follows,

Lot 15, Block 20 Passage, Aram, & Downie Addition located in the City of Delavan, Walworth County, Wisconsin

and the above plat is an accurate survey and a true representation thereof and correctly shows the exterior boundary lines and location of buildings on said property and the correct measurements thereof.

April 23, 1969

George T. Dunham, Surveyor

XP-225

K & E 10-7155 250-3-68

2-364