
46-39

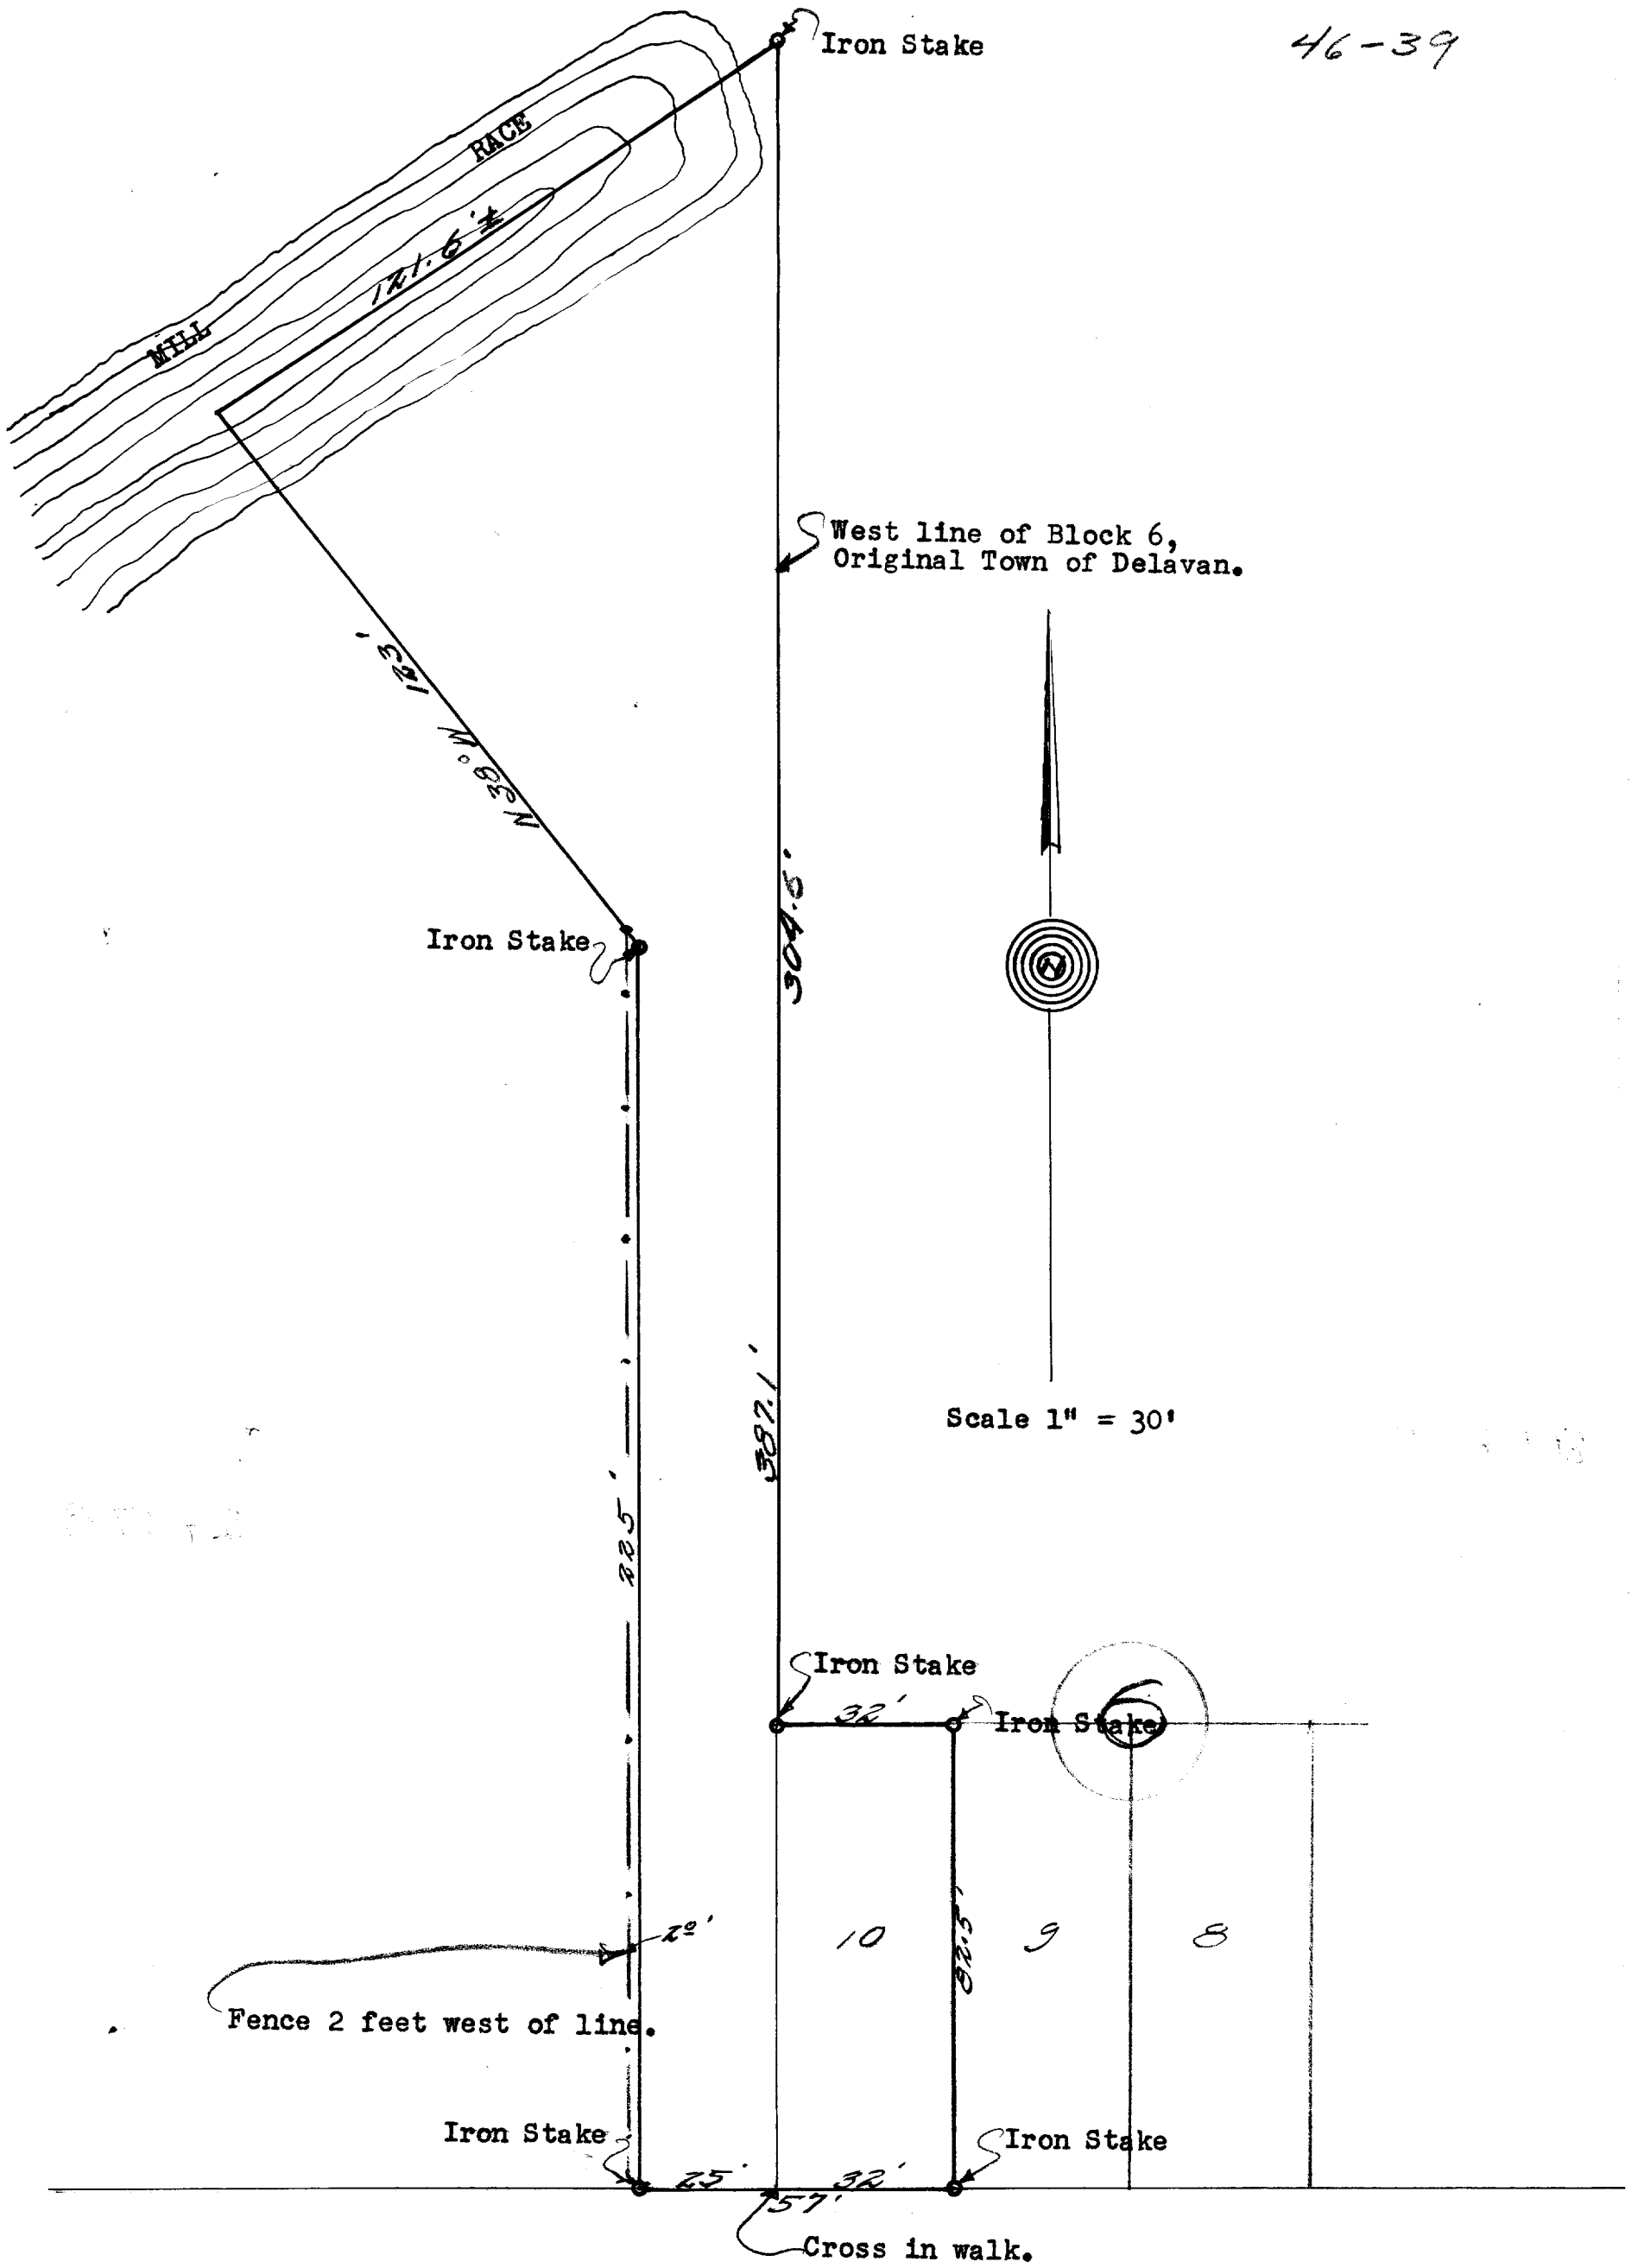

CERTIFICATE: I, hereby certify that I have on this the twenty third day of July 1946. surveyed the property described below, according to the official records on file in the office of the Recorder of Deeds in and for Walworth County, Wisconsin, and that the measurements and bearings of the boundary lines as taken at the site on this day are as shown on the above plat and substantially compare with the official record, and that no encroachments exist.

SIGNED AND SEALED THIS THE 24TH DAY OF JULY 1946.

Joseph M. Biagi. Professional Engineer
Elkhorn Wisconsin.

DESCRIPTION: Lot 10, Block 6 Original Town of Delavan, Walworth County, Wisconsin, also beginning at the southwest corner of said Lot 10, thence west 25 feet to an iron stake thence north 225 feet to an iron stake, thence N. 38° W., 123 feet to the Mill Race, thence northeasterly along the Mill Race 121.6 feet to the West line of said Block 6, thence south along the west line of Block 6 ; 387.1 feet to the place of beginning.

XWUP-111 and OP-25

2-37B