GEORGE T. DUNHAM
SURVEYING & SUBDIVIDING
DELAVAN, WISCONSIN

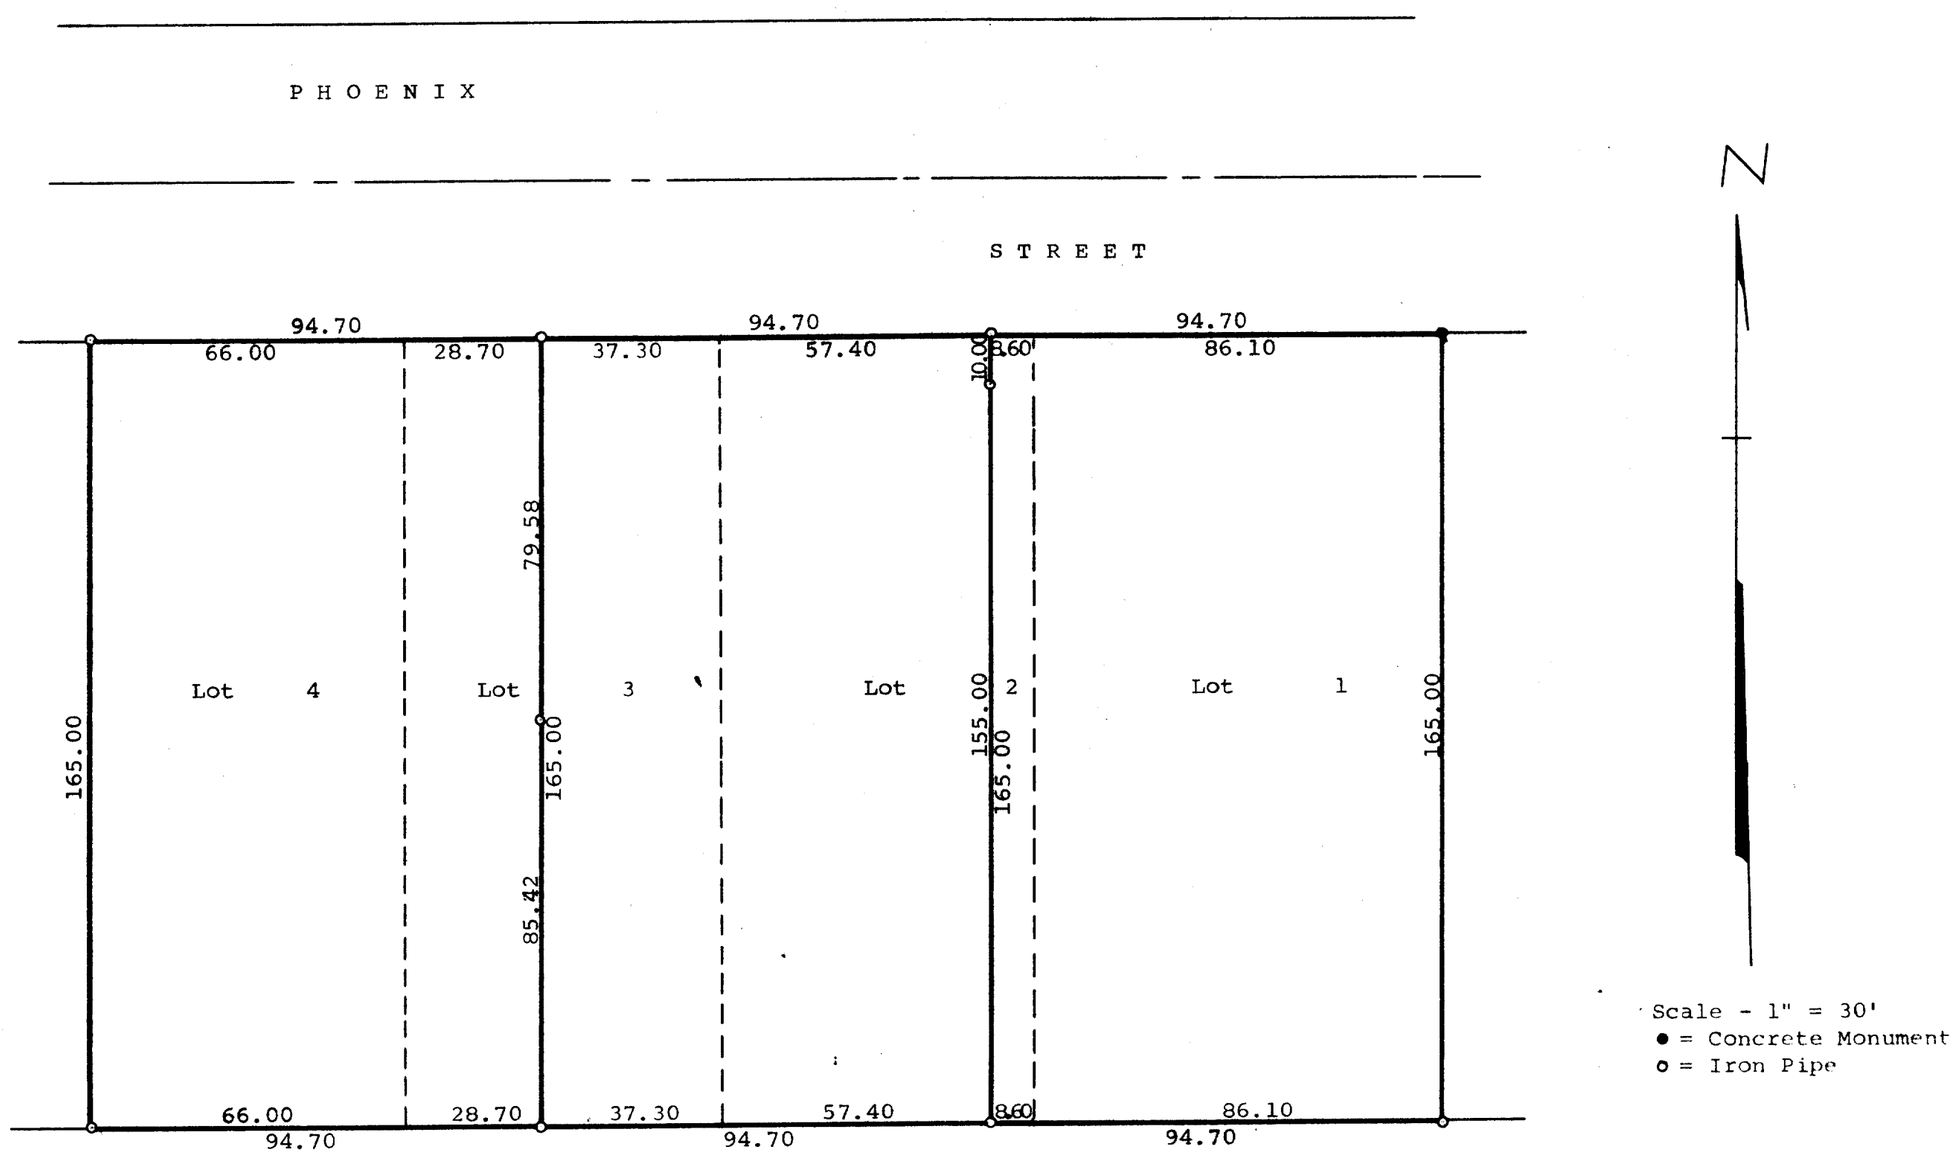

Plat of survey of Lots 1, 2, 3, and 4 in Block 3 of Sarah A. Phoenix Addition to the City of Delavan, Walworth County, Wisconsin.
March 29, 1967

George T. Dunham, Surveyor

X5-10 10A, 10A1

K & E 10-7188 250-8-66

2-380