

GEORGE T. DUNHAM
SURVEYING & SUBDIVIDING
DELAVAN, WISCONSIN

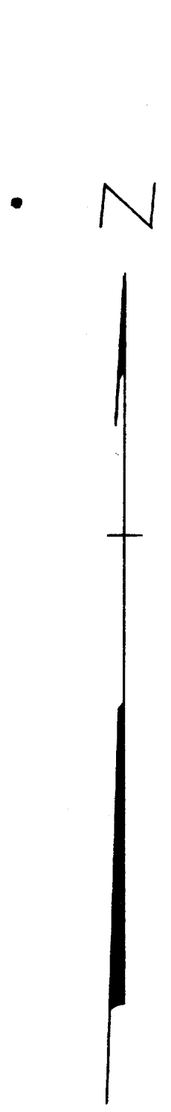

Scale - 1" = 10'
o = Iron Pipe

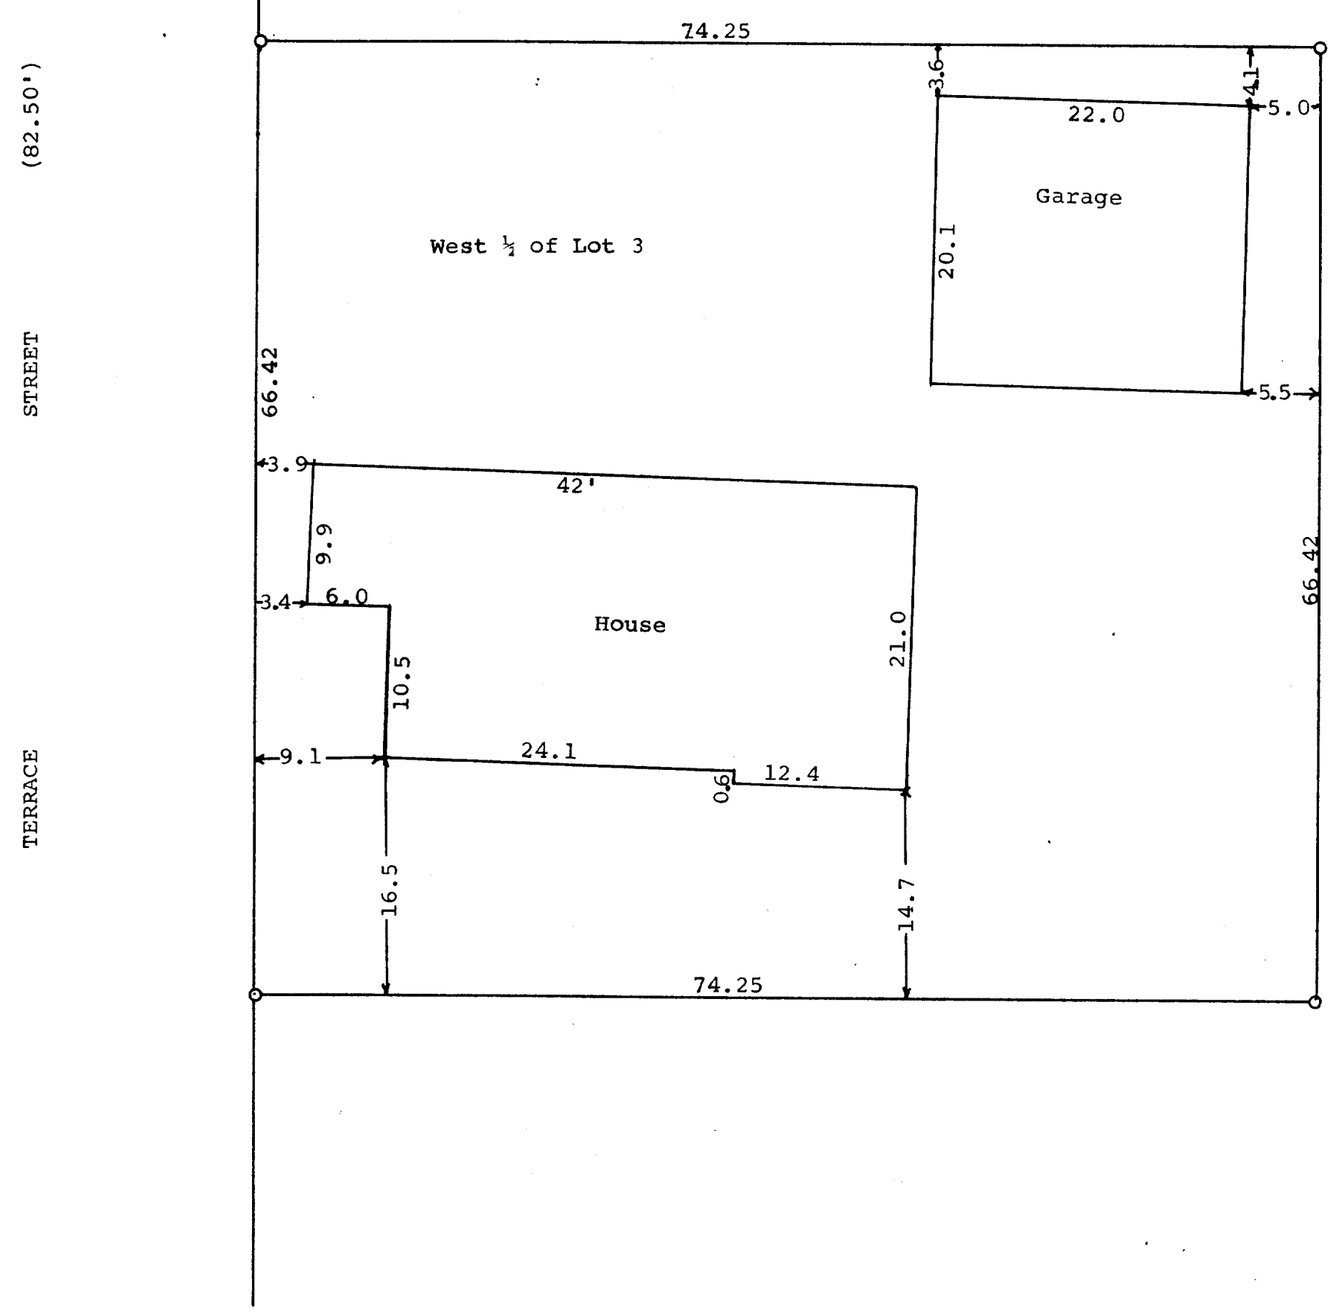

STATE OF WISCONSIN)
WALWORTH COUNTY) SS

I, George T. Dunham, Surveyor, certify that I have surveyed the property described as follows,

The West ½ of Lot 3, Block 22 of the Original Town (Now City) of Delavan, Walworth County, Wisconsin and the aboveplat is an accurate survey and a true representation thereof and correctly shows the exterior boundary lines and location of buildings on said property and the correct measurements thereof.

January 10, 1968

George T. Dunham, Surveyor

K & E 10-7155 250-8-66

X OP-229

2-393