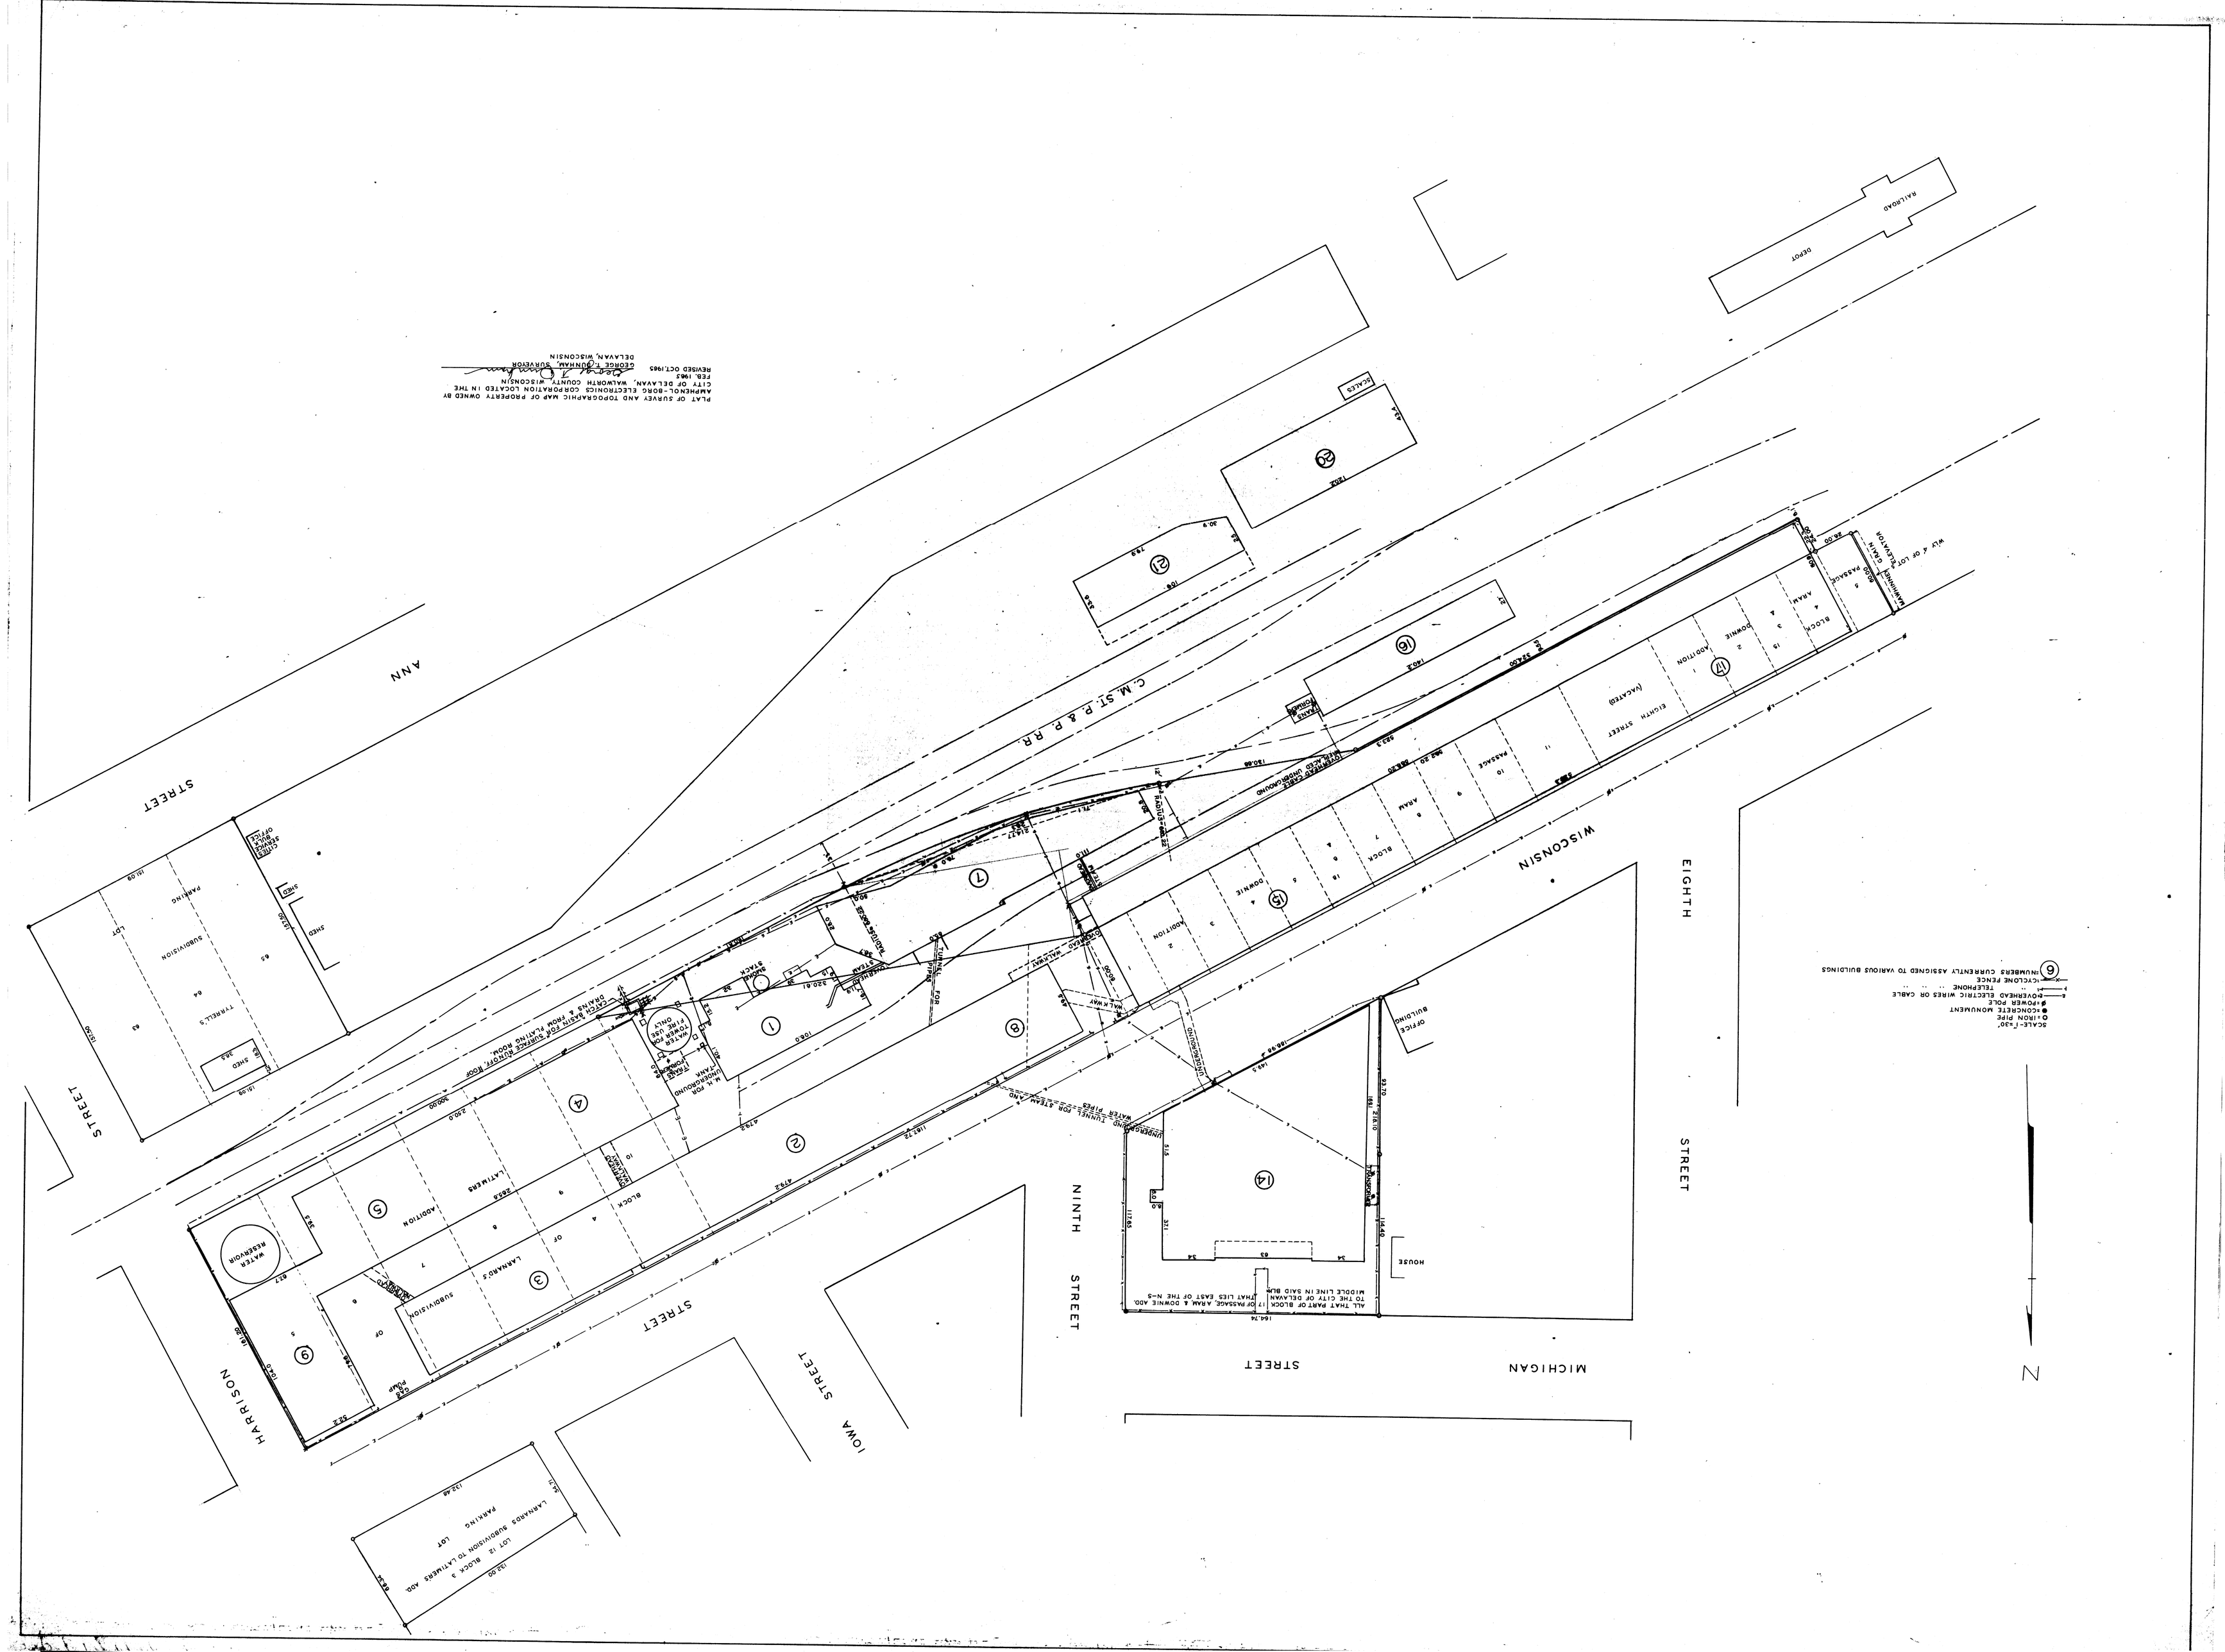
PLAT OF SURVEY AND TOPOGRAPHIC MAP OF PROPERTY OWNED BY
AMPHENOL-BORG ELECTRONICS CORPORATION LOCATED IN THE
CITY OF DELAVAN, WALWORTH COUNTY, WISCONSIN
FEB. 1963
GEORGE T. DUNHAM, SURVEYOR
REVISED OCT.1963
DELAVAN, WISCONSIN
SCALE: 1"=30'
SCALE-1"=30'
CONCRETE MONUMENT
IRON PIPE
POWER POLE
OVERHEAD ELECTRIC WIRES OR CABLE
TELEPHONE
CHAIN LINK FENCE
NUMBERS CURRENTLY ASSIGNED TO VARIOUS BUILDINGS
N
EIGHTH STREET
WISCONSIN STREET
MICHIGAN STREET
NINTH STREET
IOWA STREET
HARRISON STREET
ANN STREET
C.M.St.P.&P.R.R.
RAILROAD
DEPOT
OFFICE BUILDING
HOUSE
WATER RESERVOIR
SHED
TYRRELL'S SUBDIVISION
LARRABEE'S SUBDIVISION
LATHAMS ADDITION
BLOCK 4 OF LARRABEE'S SUBDIVISION
BLOCK 3 OF LATHAMS ADDITION
BLOCK 4 OF ARAM & DOWNIE ADDITION
EIGHTH STREET (VACATED)
ALL THAT PART OF BLOCK 17 OF PASSAGE ARAM & DOWNIE ADD. TO THE CITY OF DELAVAN THAT LIES EAST OF THE N-S MIDDLE LINE IN SAID BLK.
LARRABEE'S SUBDIVISION TO LATHAMS ADD.
LOT 12 BLOCK 3
PARKING LOT