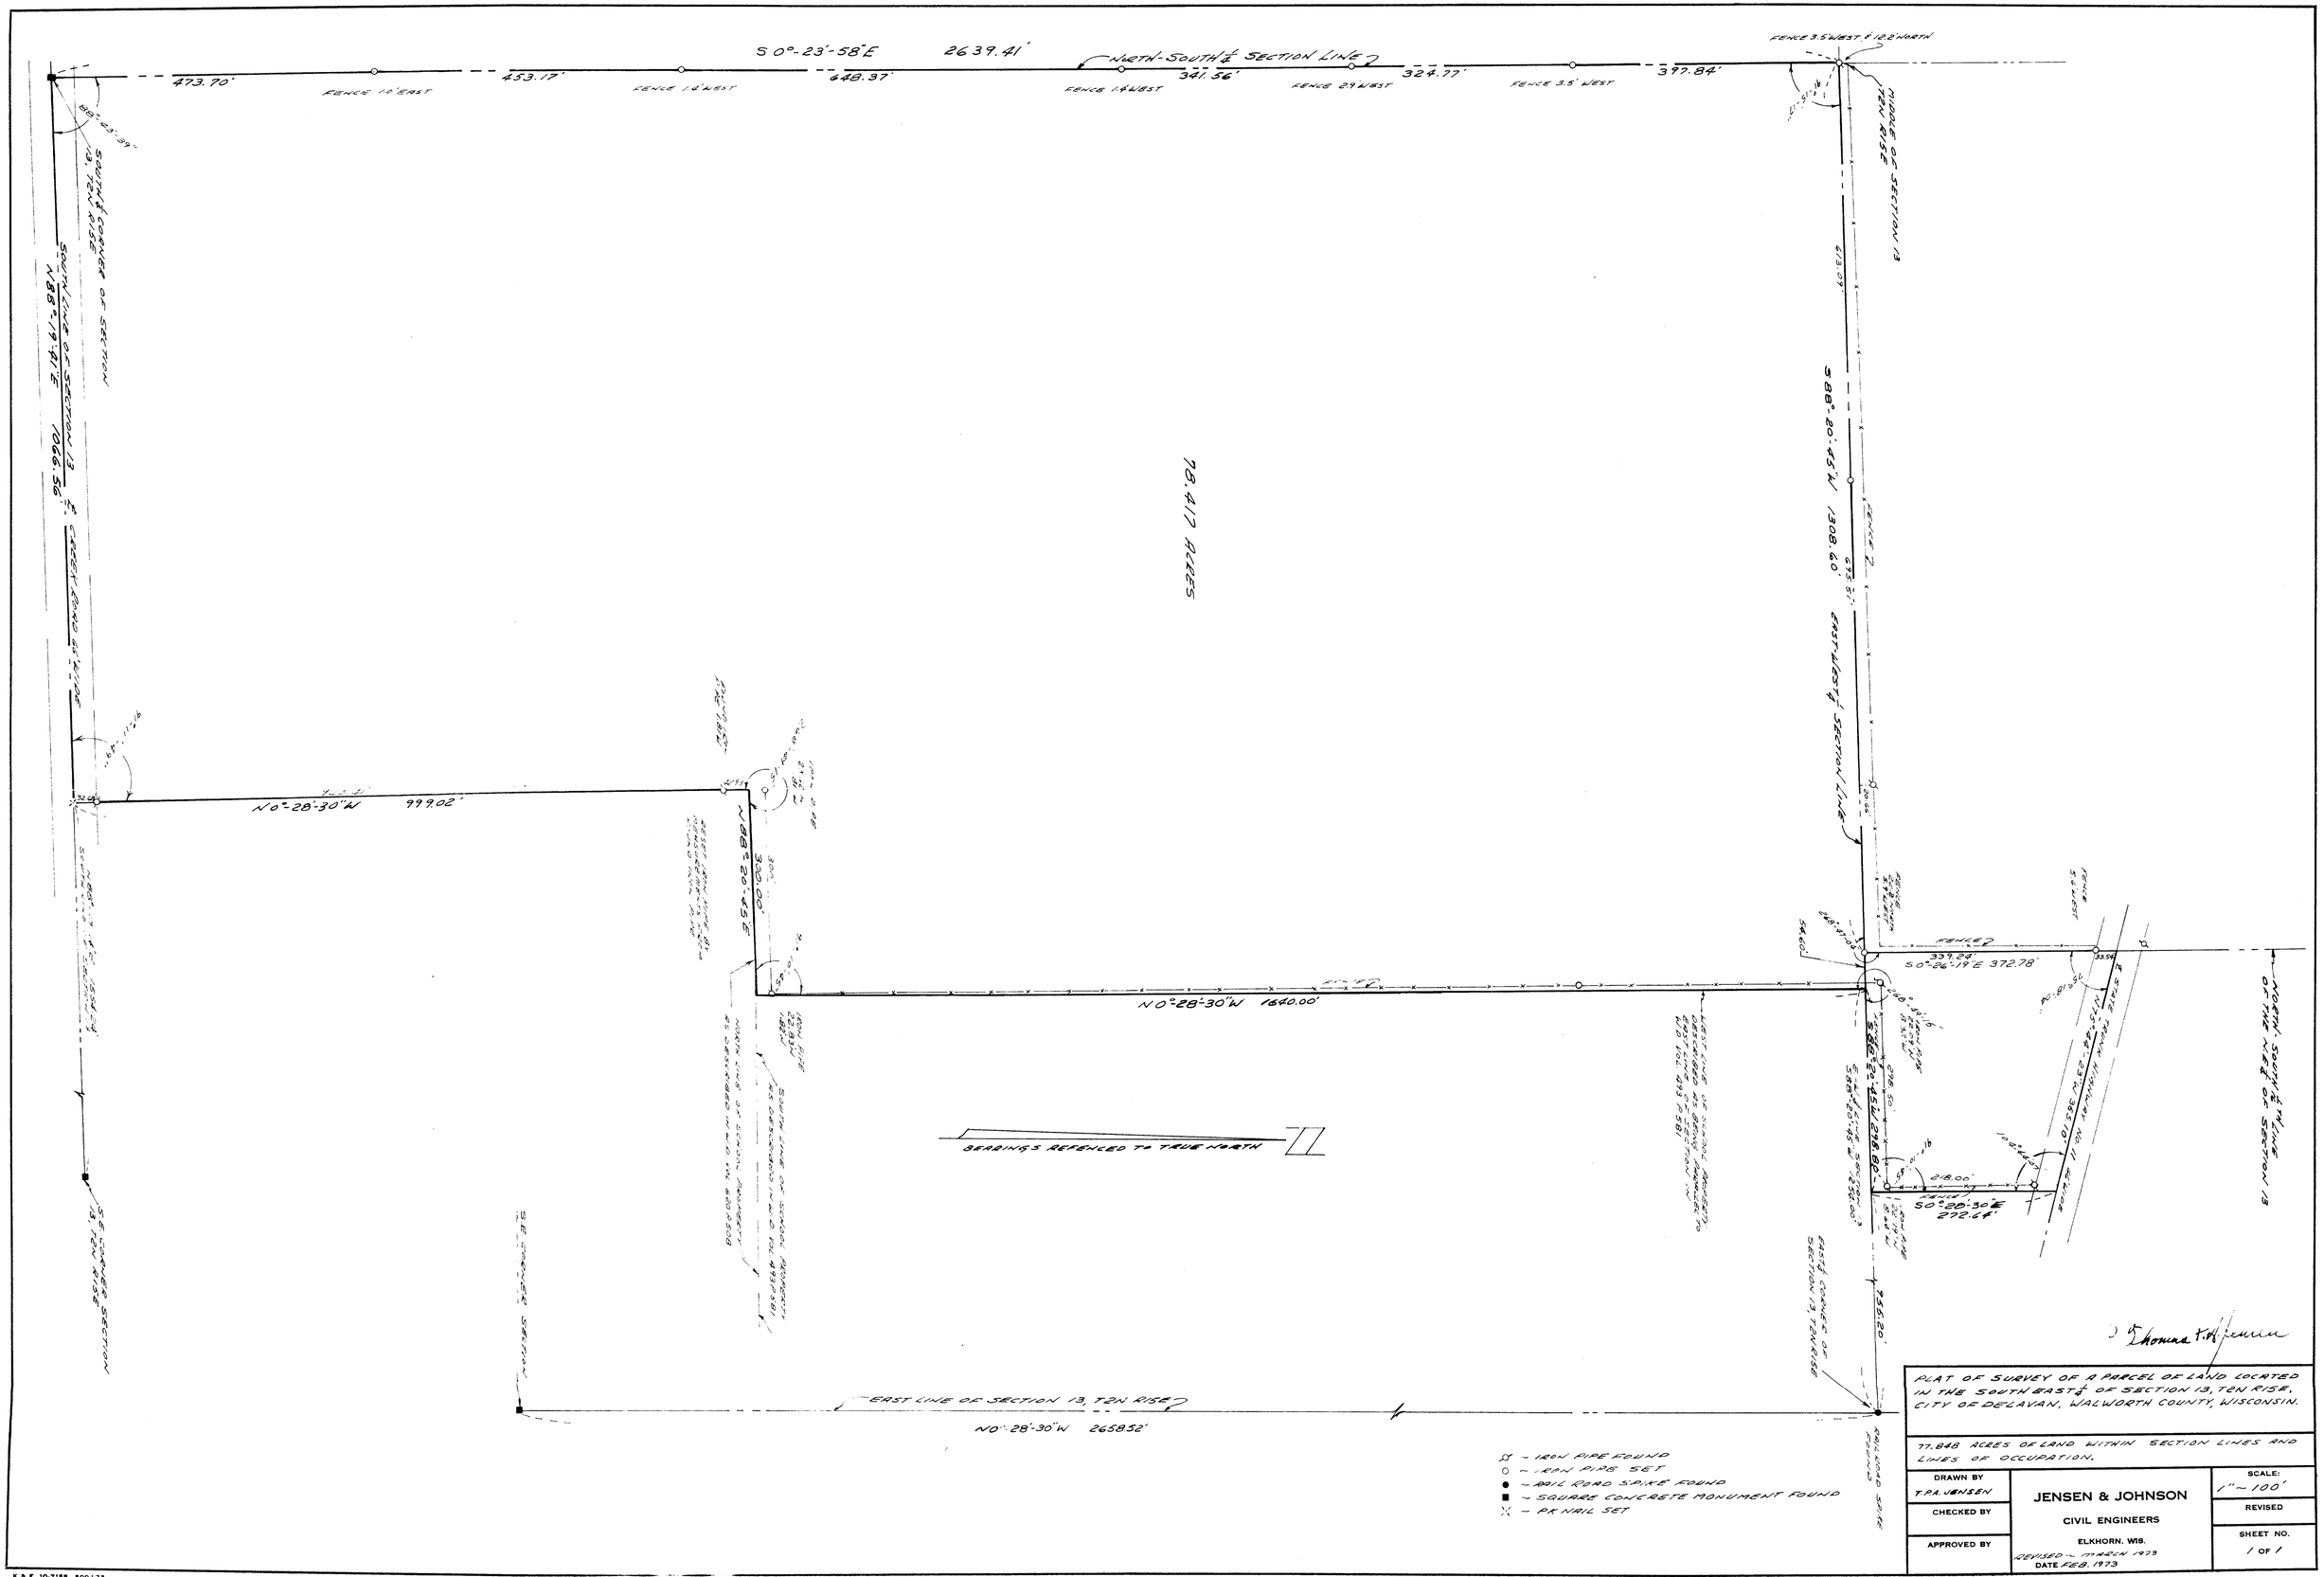

K & E 10-7188 500-1-72

2-485