
4-67

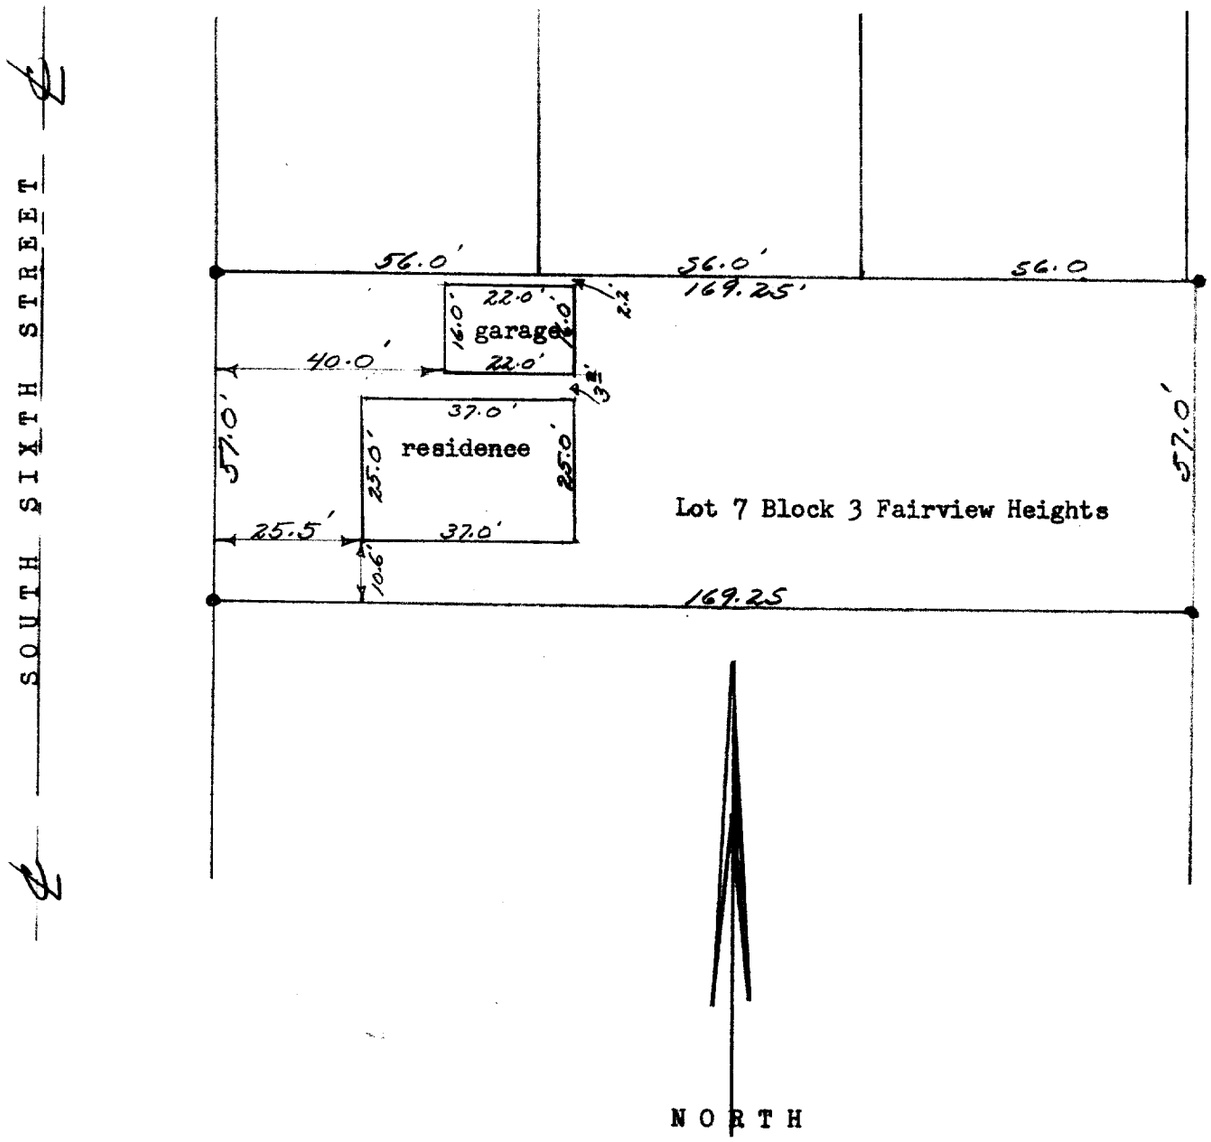

● Iron stake

DESCRIPTION: Lot 7 Block 3 Fairview Heights in the City of Delavan, Walworth County, Wisconsin.

CERTIFICATE: I, hereby certify that I have surveyed the above mentioned property and that the hereon portrayed is an accurate survey and a true representation thereof and correctly shews the exterior boundary lines and the location of the buildings and the other improvements thereof.

Dated: January 25th 1967.

KSCON
James F. Blagg, [illegible] 272
Elkhorn, Wisconsin

JAMES F. BLAGG
WISCONSIN
MILWAUKEE
SURVEYOR

XFH-37

2-51B