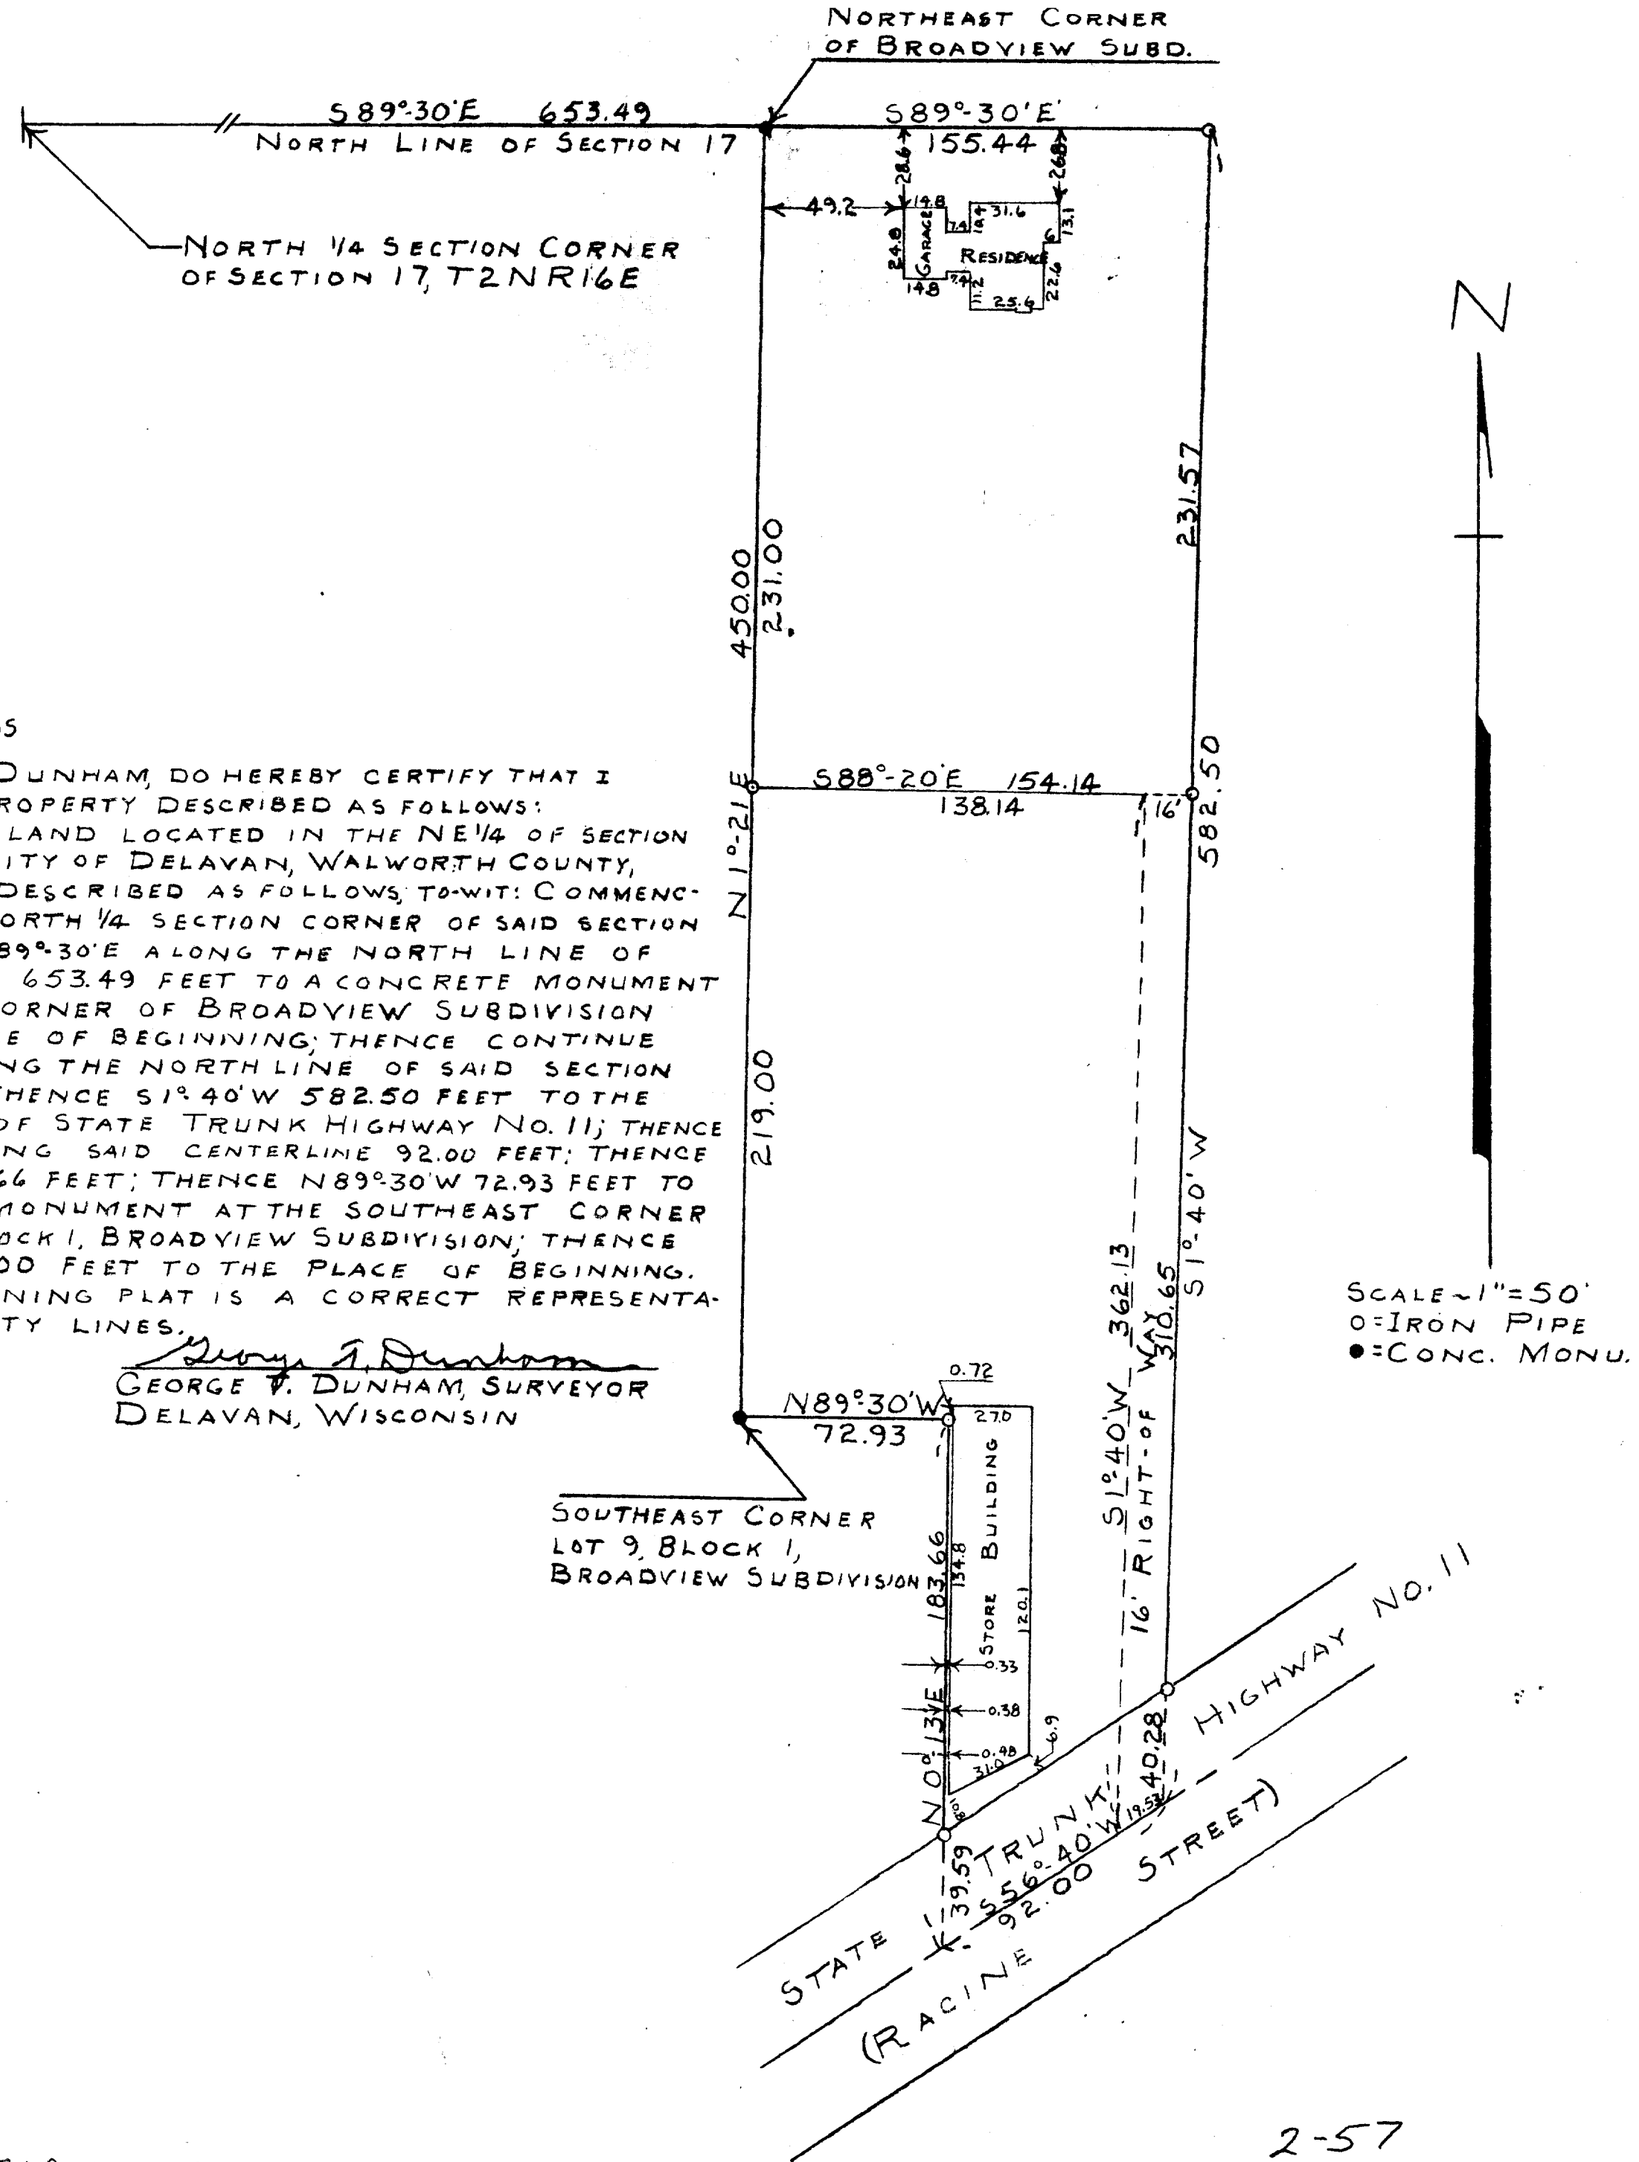

STATE OF WISCONSIN) SS
COUNTY OF WALWORTH)

I, GEORGE T. DUNHAM, DO HEREBY CERTIFY THAT I HAVE SURVEYED THE PROPERTY DESCRIBED AS FOLLOWS:

A PARCEL OF LAND LOCATED IN THE NE 1/4 OF SECTION 17, T2NR16E, CITY OF DELAVAN, WALWORTH COUNTY, WISCONSIN, DESCRIBED AS FOLLOWS, TO-WIT: COMMENCING AT THE NORTH 1/4 SECTION CORNER OF SAID SECTION 17; THENCE S89°-30'E ALONG THE NORTH LINE OF SAID SECTION 653.49 FEET TO A CONCRETE MONUMENT AT THE NE CORNER OF BROADVIEW SUBDIVISION AND THE PLACE OF BEGINNING; THENCE CONTINUE S89°-30'E ALONG THE NORTH LINE OF SAID SECTION 155.44 FEET; THENCE S1°-40'W 582.50 FEET TO THE CENTERLINE OF STATE TRUNK HIGHWAY NO. 11; THENCE S56°-40'W ALONG SAID CENTERLINE 92.00 FEET; THENCE N0°-13'-E 183.66 FEET; THENCE N89°-30'W 72.93 FEET TO A CONCRETE MONUMENT AT THE SOUTHEAST CORNER OF LOT 9, BLOCK 1, BROADVIEW SUBDIVISION; THENCE N1°-21'E 450.00 FEET TO THE PLACE OF BEGINNING.

AND THAT THE ADJOINING PLAT IS A CORRECT REPRESENTATION OF THE PROPERTY LINES.

MARCH 1, 1956
REVISED MARCH 20, 1956
REVISED JAN. 30, 1957

George T. Dunham
GEORGE T. DUNHAM, SURVEYOR
DELAVAN, WISCONSIN

2-57

WVP- 177A, 177A1, 177A2 + 177B