
DUNHAM SURVEYING, S.C.
SURVEYING & SUBDIVIDING
DELAVAN, WISCONSIN 53115

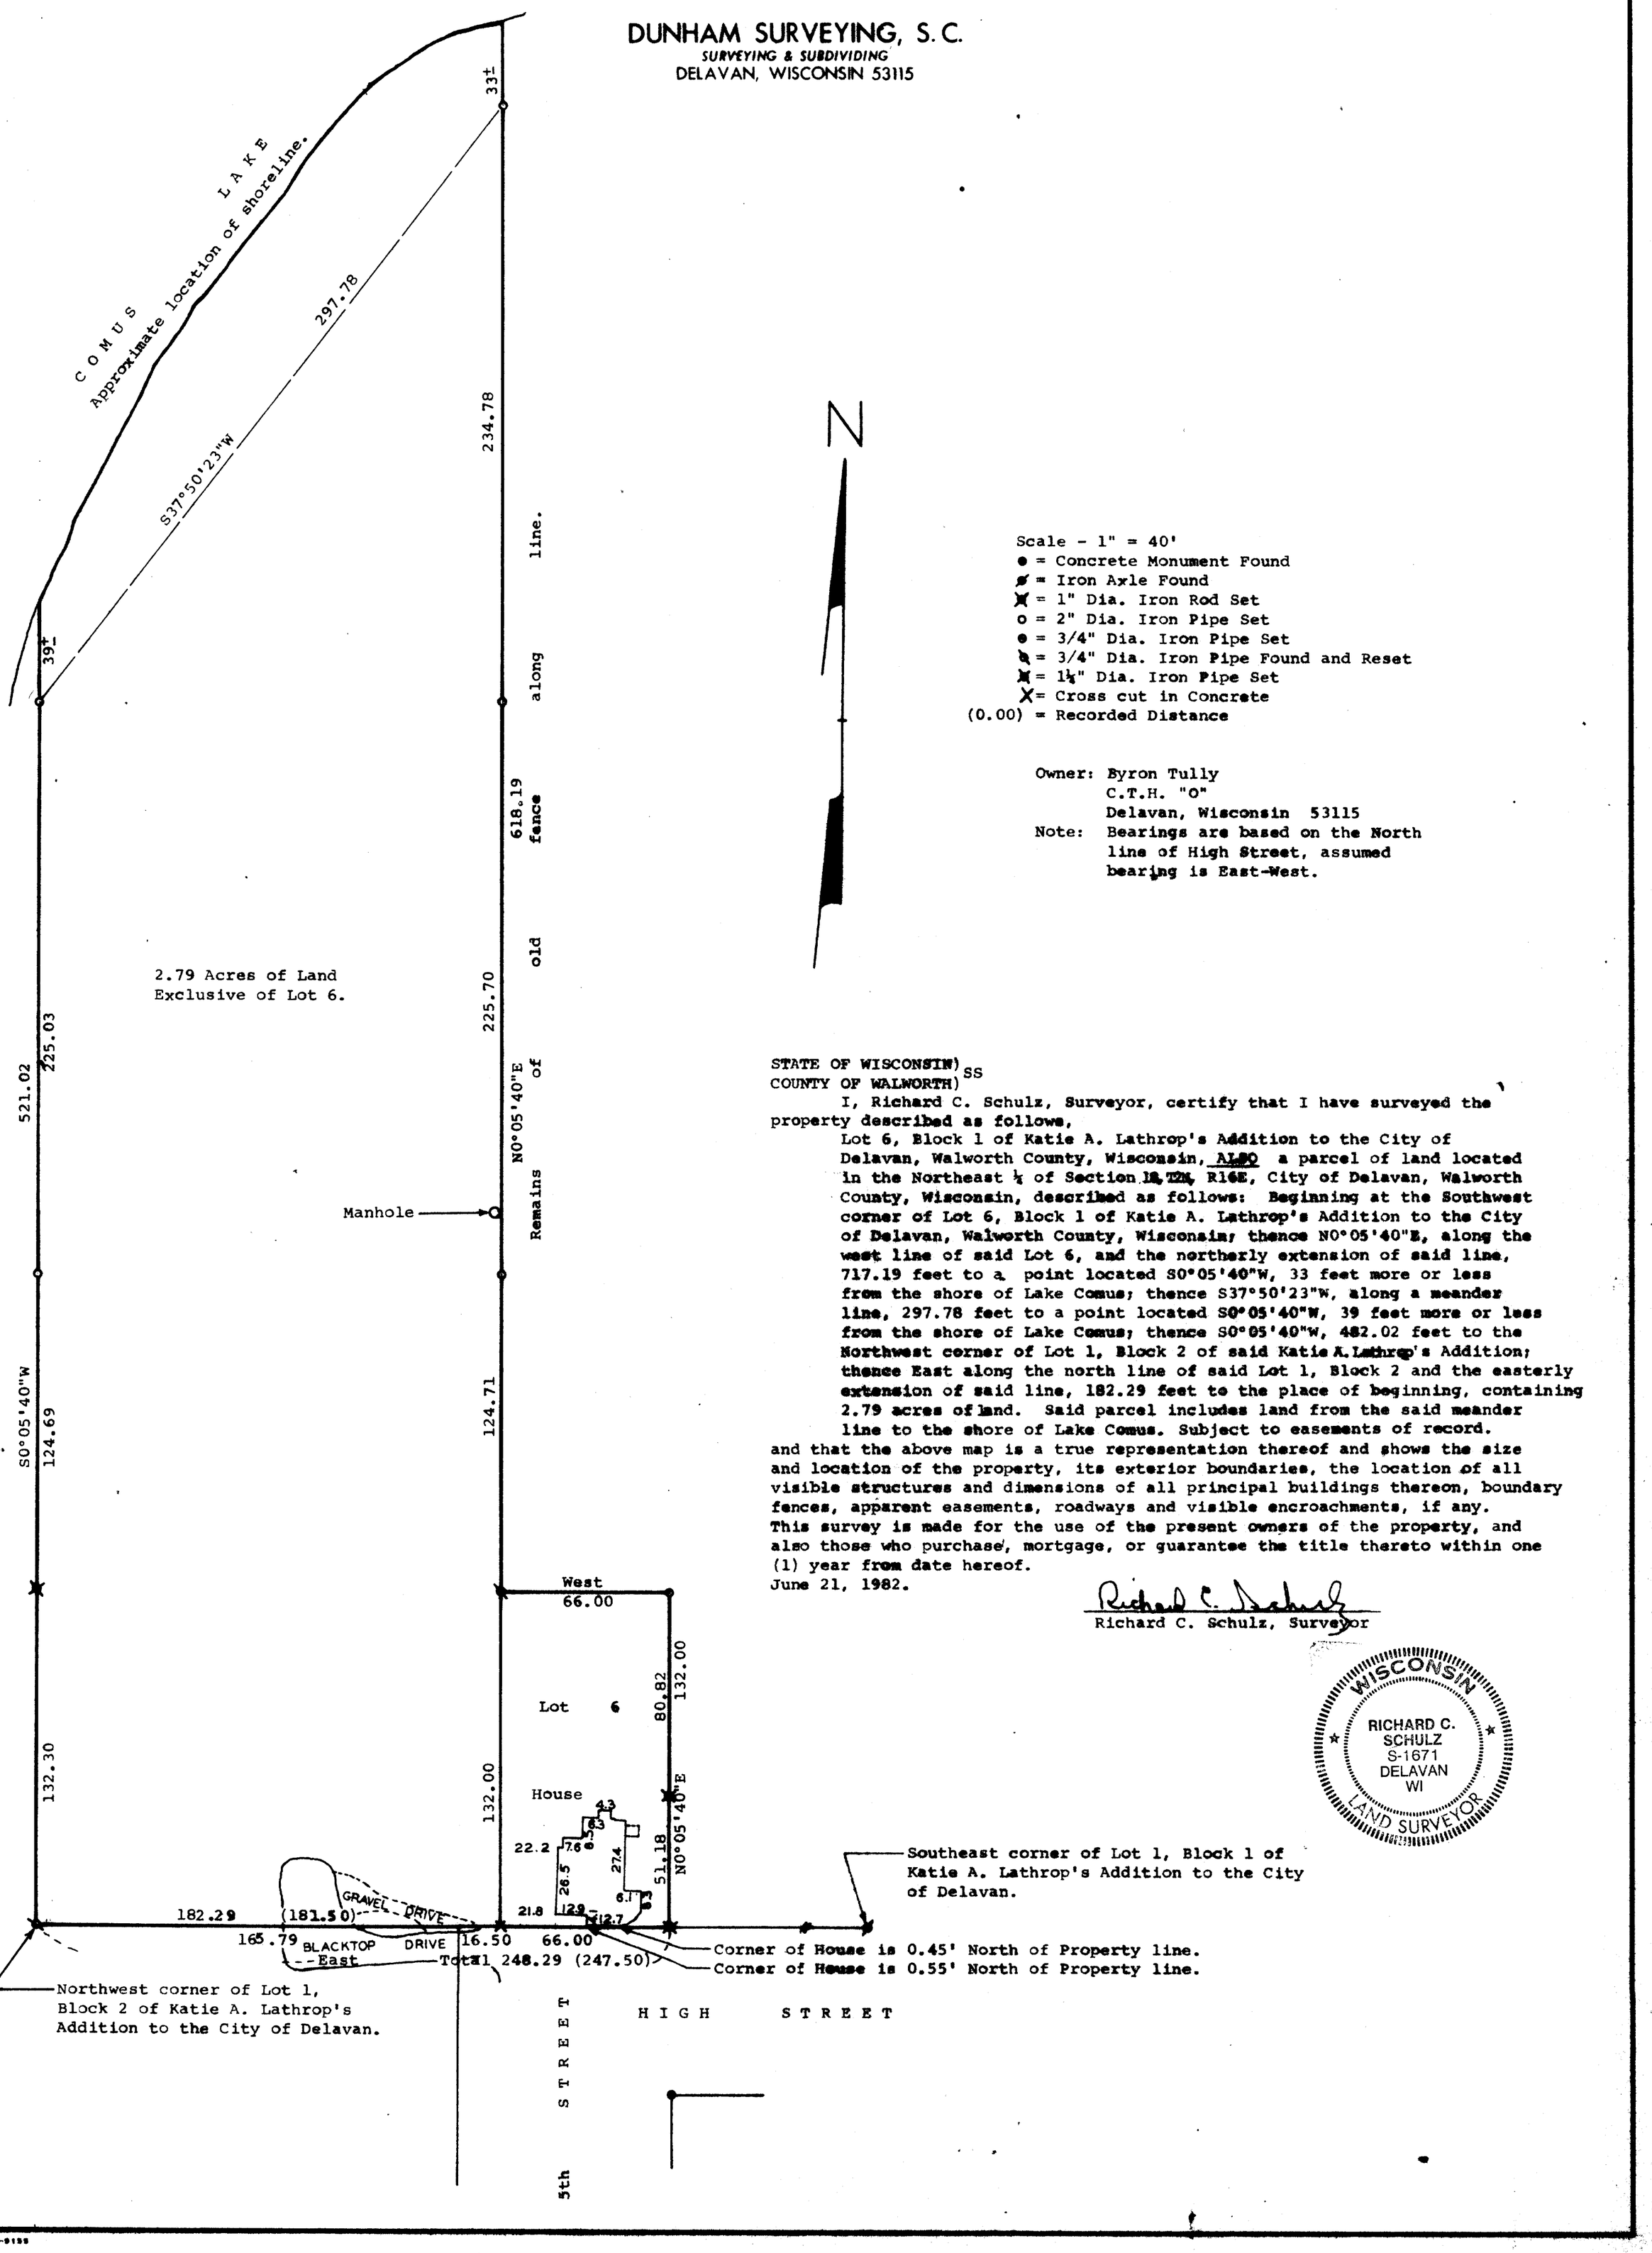

2.79 Acres of Land
Exclusive of Lot 6.

Owner: Byron Tully
C.T.H. "O"
Delavan, Wisconsin 53115

Note: Bearings are based on the North line of High Street, assumed bearing is East-West.

STATE OF WISCONSIN) SS
COUNTY OF WALWORTH)

I, Richard C. Schulz, Surveyor, certify that I have surveyed the property described as follows,

Lot 6, Block 1 of Katie A. Lathrop's Addition to the City of Delavan, Walworth County, Wisconsin, ALSO a parcel of land located in the Northeast ¼ of Section 18, T2N, R16E, City of Delavan, Walworth County, Wisconsin, described as follows: Beginning at the Southwest corner of Lot 6, Block 1 of Katie A. Lathrop's Addition to the City of Delavan, Walworth County, Wisconsin; thence N0°05'40"E, along the west line of said Lot 6, and the northerly extension of said line, 717.19 feet to a point located S0°05'40"W, 33 feet more or less from the shore of Lake Comus; thence S37°50'23"W, along a meander line, 297.78 feet to a point located S0°05'40"W, 39 feet more or less from the shore of Lake Comus; thence S0°05'40"W, 482.02 feet to the Northwest corner of Lot 1, Block 2 of said Katie A. Lathrop's Addition; thence East along the north line of said Lot 1, Block 2 and the easterly extension of said line, 182.29 feet to the place of beginning, containing 2.79 acres of land. Said parcel includes land from the said meander line to the shore of Lake Comus. Subject to easements of record.

and that the above map is a true representation thereof and shows the size and location of the property, its exterior boundaries, the location of all visible structures and dimensions of all principal buildings thereon, boundary fences, apparent easements, roadways and visible encroachments, if any. This survey is made for the use of the present owners of the property, and also those who purchase, mortgage, or guarantee the title thereto within one (1) year from date hereof.

June 21, 1982.

Richard C. Schulz
Richard C. Schulz, Surveyor

WISCONSIN
RICHARD C. SCHULZ
S-1671
DELAVAN
WI
LAND SURVEYOR

K & E 10-9155

XLA-5
LOT 6 Blk 1 KATIE LATHROP'S + UP-58

2-649-D