
● = IRON PIPE SURVEY STAKE FOUND
● = IRON ROD SURVEY STAKE FOUND
⊕ = CROSS CUT IN CONCRETE FOUND
○ = IRON PIPE SURVEY STAKE SET
(XXYX) = RECORD DIMENSION

FARRIS, HANSEN & COOPER, INC.
ENGINEERING, SURVEYING AND LAND PLANNING
715 W. WALWORTH ST. - P.O. BOX 487 - ELKHORN, WI 53121
OFFICE: 414/723-2098

PLAT OF SURVEY
LOT 10, BLOCK 1
CONVERSE'S SUB.
DELAVAN, WIS.

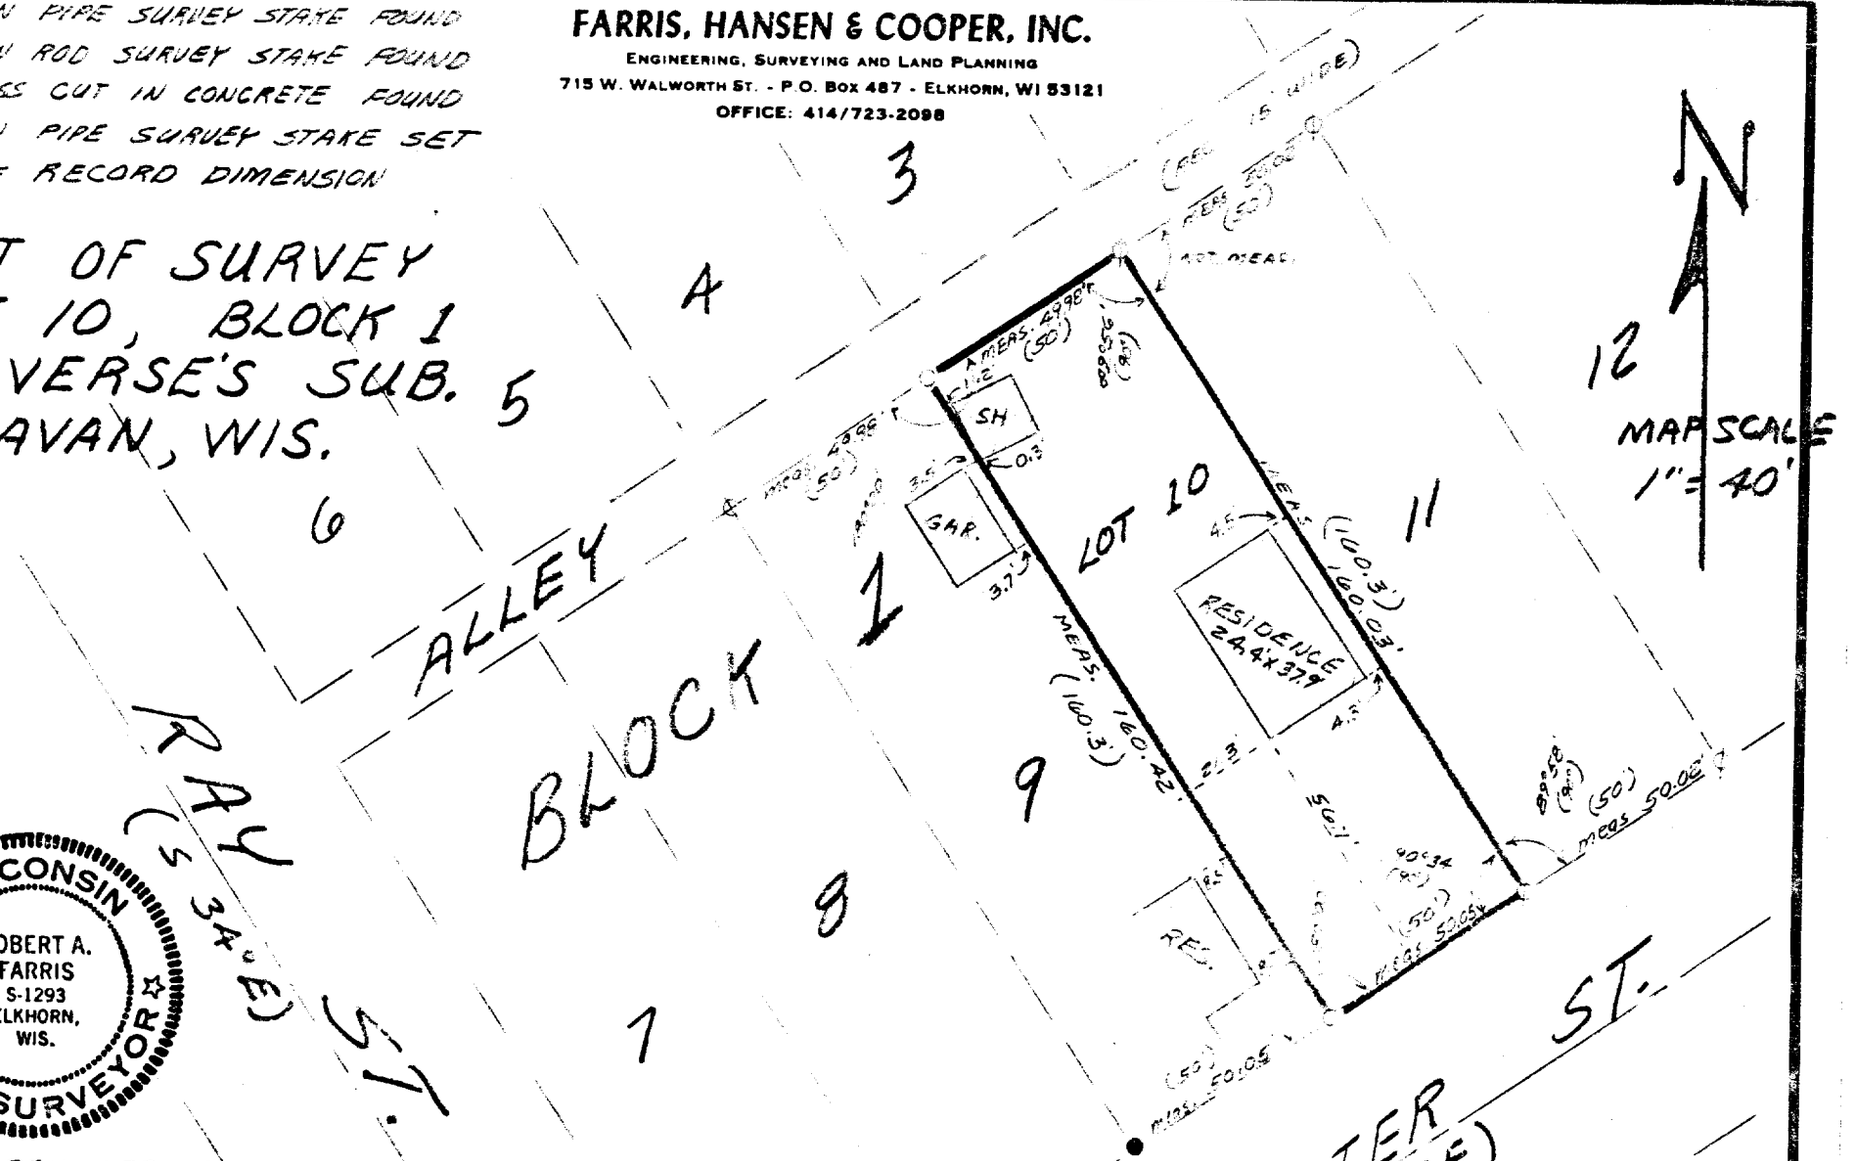

WISCONSIN
ROBERT A. FARRIS
S-1293
ELKHORN, WIS.
LAND SURVEYOR

I HEREBY CERTIFY THAT I HAVE SURVEYED LOT 10 OF BLOCK 1 OF CONVERSE'S SUBDIVISION LOCATED IN THE CITY OF DELEVAN, WISCONSIN, AND THAT THIS PLAT OF SURVEY IS A TRUE AND ACCURATE REPRESENTATION OF THE LOT LINES AND BUILDING LOCATION TO THE BEST OF MY PROFESSIONAL KNOWLEDGE AND BELIEF

1 APRIL 1982

Robert A. Farris

DRAWING NUMBER 1946

XC-5-5

2-649 E