
DUNHAM SURVEYING, S. C.
SURVEYING & SUBDIVIDING
DELAVAN, WISCONSIN 53115

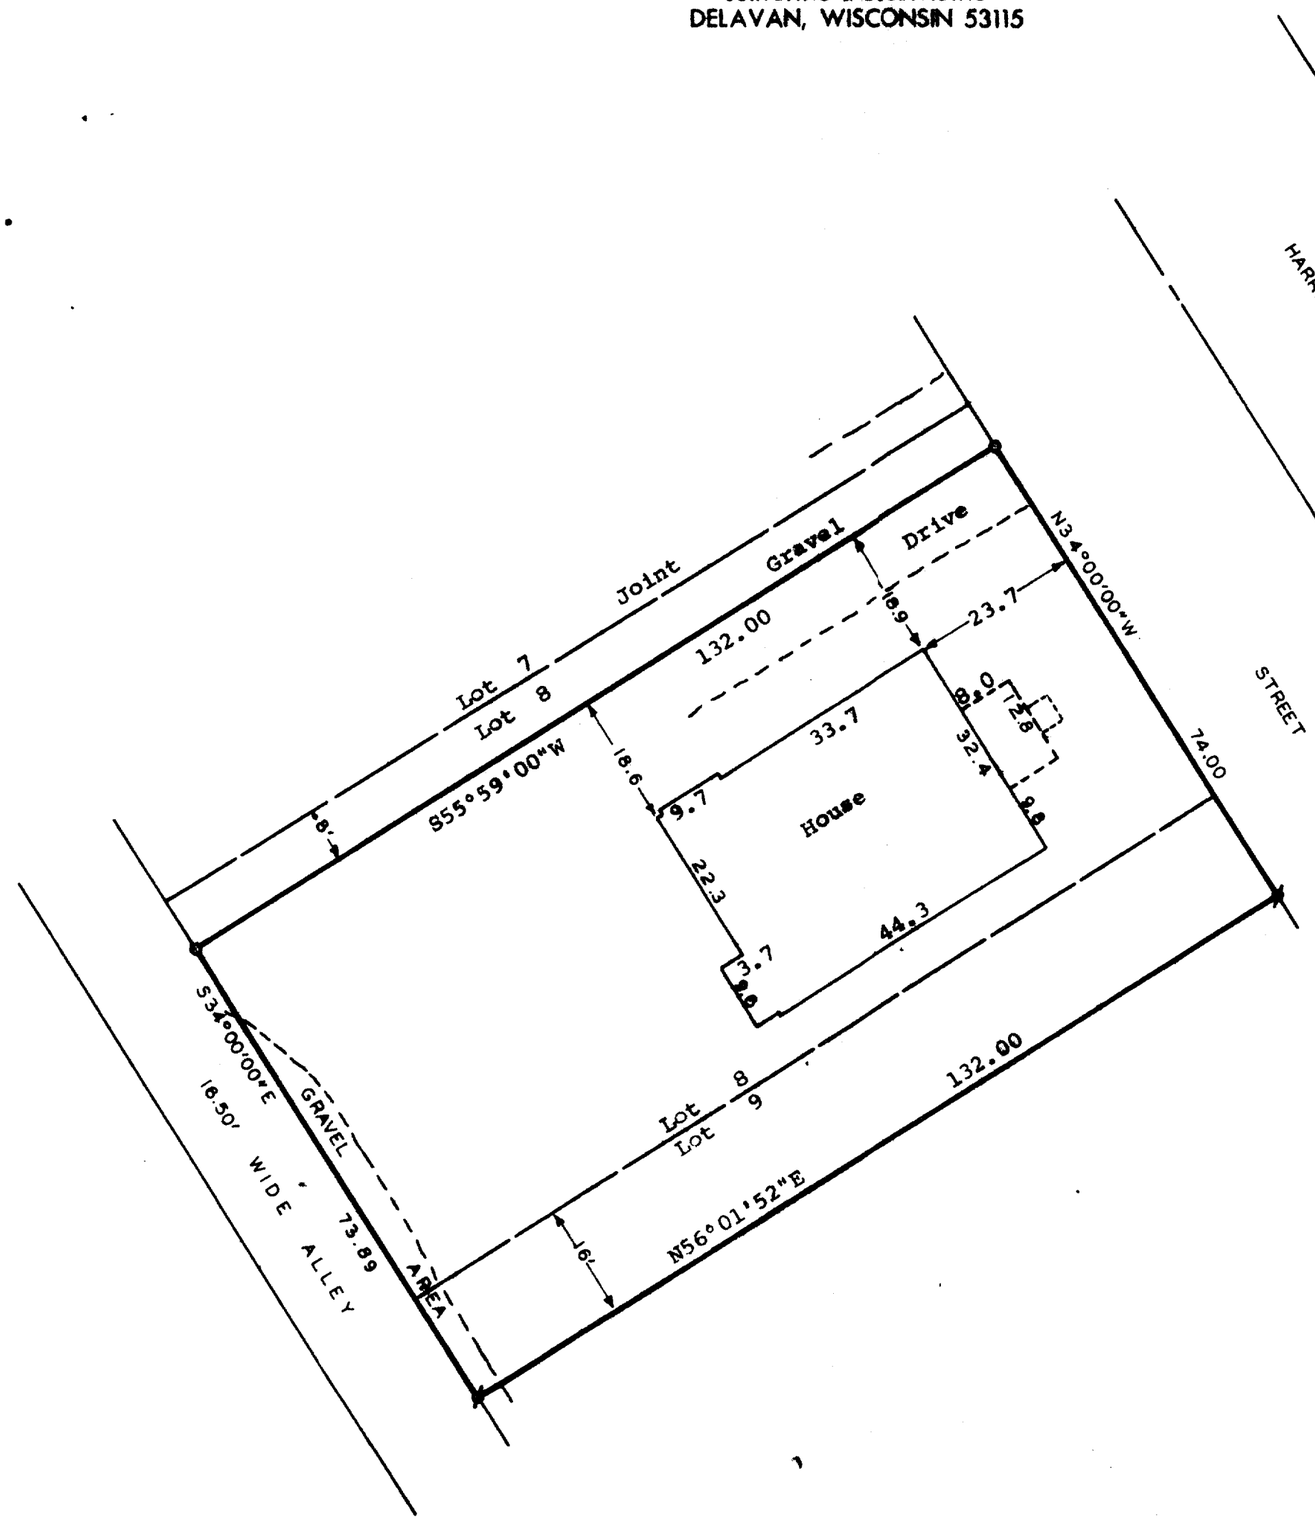

Ø = Iron Pipe Found - 1" Dia.
O = Iron Pipe Set-1¼" Dia.

Note: Bearings are referenced to the Westerly line of Harrison Street, assumed N34°00'00"W.

Owner: Joseph Yirek
340 Bradley Ave.
Delavan, WI 53115

STATE OF WISCONSIN)
COUNTY OF WALWORTH) SS

I, James M. Dunham, Surveyor, certify that I have surveyed the property described as follows:

The North 16' of Lot 9 and all of Lot 8, EXCEPTING the North 8' thereof, all being in Block 3 of Larnard's Subdivision of Latimer's Addition to the City of Delavan, Walworth County, Wisconsin.

and that the above map is a true representation thereof and shows the size and location of the property, its exterior boundaries, the location of all visible structures and dimensions of all principal buildings thereon, boundary fences, apparent easements, roadways and visible encroachments, if any.

This survey is made for the use of the present owners of the property, and also those who purchase, mortgage, or guarantee the title thereto within one (1) year from date hereof.

May 12, 1982.

James M Dunham
James M. Dunham, Surveyor

WISCONSIN
JAMES M. DUNHAM
S-1331
DELAVAN, WIS.
LAND SURVEYOR

K & E 10-9155

XLDA-24 - Chain-Lk 8' ± except N 8' N16' of LOT 9 Blk 3, Larnard's Subd.

2-652-D