
DUNHAM SURVEYING, S.C.
SURVEYING & SUBDIVIDING
DELAVAN, WISCONSIN 53115



Scale - 1" = 20'
● = Concrete Monument
◔ = Iron Pipe Found
○ = Iron Pipe Set
(0.00) = Recorded Distance

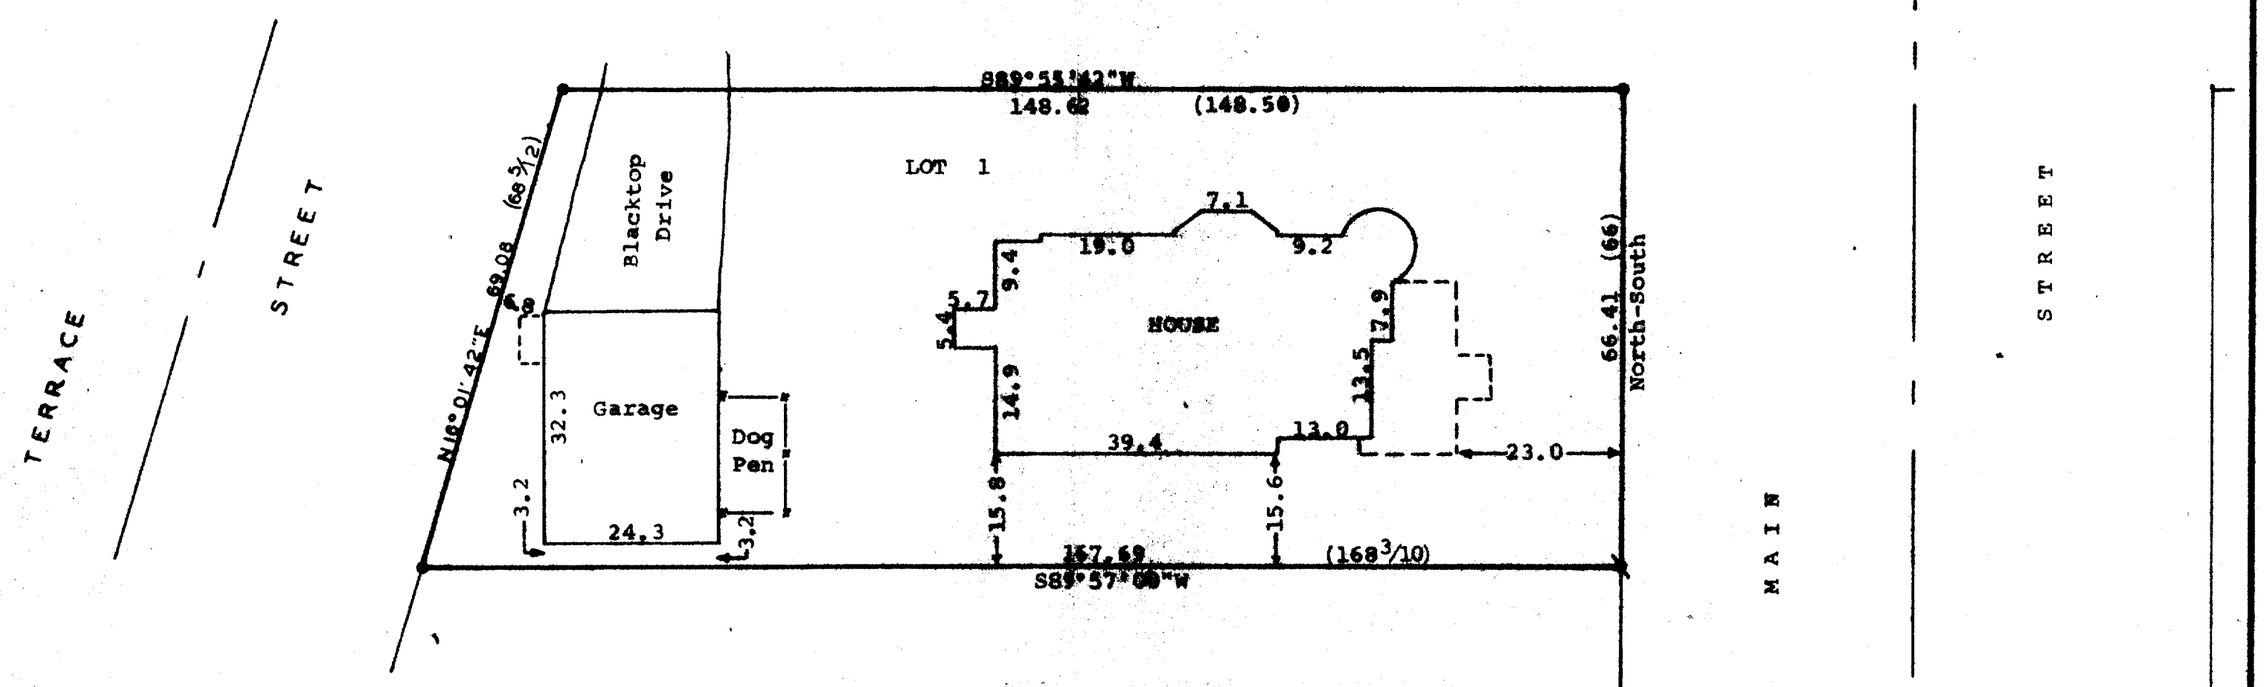

Owner: Nora Tifft
505 Alder Avenue
Delavan, Wisconsin 53115
Note: Bearings are based on the West line of Main Street, assumed bearing is North.

STATE OF WISCONSIN)
COUNTY OF WALWORTH) ss

I, James M. Dunham, Surveyor, certify that I have surveyed the property described as follows,

Lot 1 of Block 16 of the Original Plat of the Village (now City) of Delavan, Walworth County, Wisconsin,

and that the above map is a true representation thereof and shows the size and location of the property, its exterior boundaries, the location of all visible structures and dimensions of all principal buildings thereon, boundary fences, apparent easements, roadways and visible encroachments, if any.

This survey is made for the use of the present owners of the property, and also those who purchase, mortgage, or guarantee the title thereto within one (1) year from date hereof.

May 4, 1982

James M Dunham
James M. Dunham, Surveyor

WISCONSIN
JAMES M. DUNHAM
S-1331
DELAVAN, WIS.
LAND SURVEYOR

K & E 10-9155

LOT 1, Blk 16 Orig Plat XOP-00170

2-654-D