
KOLB LAND CONSULTING, INC.

LAND SURVEYING · SUBDIVIDING · LAND PLANNING

LAKE GENEVA, WISCONSIN 53147

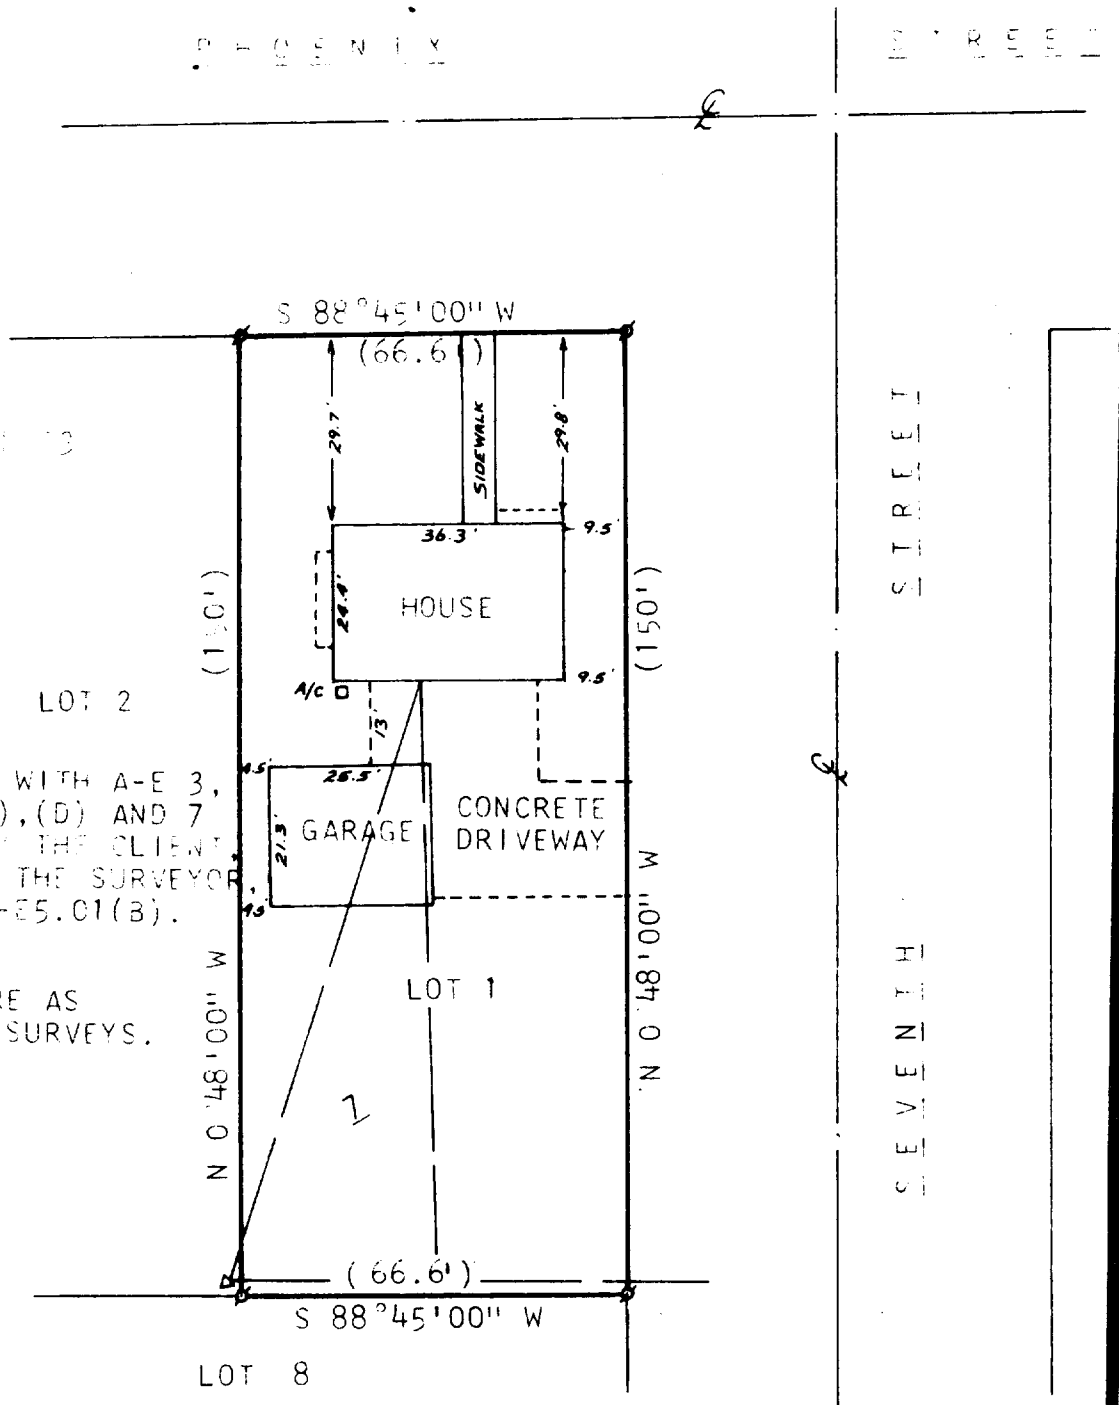

TAX NUMBER: D-FH-53

NOTE: COMPLIANCE WITH A-E 3, 5(F), 6(A),(B),(C),(D) AND 7 HAS BEEN WAIVED BY THE CLIENT IN AGREEMENT WITH THE SURVEYOR AS PERMITTED IN A-E5.01(B).

NOTE: BEARINGS ARE AS SHOWN ON EXISTING SURVEYS.

BLOCK

MORTGAGE INSPECTION OF

LOT 1, BLOCK 7, FAIRVIEW HEIGHTS, A SUBDIVISION LOCATED IN THE CITY OF DELAVAN, WALWORTH COUNTY, WISCONSIN.

ORDERED BY: ANCHOR SAVINGS & LOAN ASSOCIATION
500 E. WALWORTH AVE.
DELAVAN, WI 53115

OWNER: JAMES DADY, JR.
670 PHOENIX
DELAVAN, WI 53115

SCALE - 1"=30'

LEGEND
- ⌀ - IRON PIPE FOUND
- △ - UTILITY POLE
- ——— ——— - OVERHEAD UTILITY LINES
- ( ) - RECORDED AS

Harold H. Kolb

HAROLD H. KOLB
WISCONSIN REGISTERED LAND SURVEYOR, S-187
DATE FEBRUARY 28, 1984

XFH-53

2-670-K

D-FH-53