COOPER SURVEYING SERVICES


Rural - Residential - Commercial

DANIEL D. COOPER
Registered Land Surveyor

Route 3, Box 255 :: Elkhorn, Wisconsin 53121

Phone (414) 723-6265

SURVEYING & PLANNING
SUBDIVISIONS - LOT SURVEYS
CONSTRUCTION STAKING - MAPPING

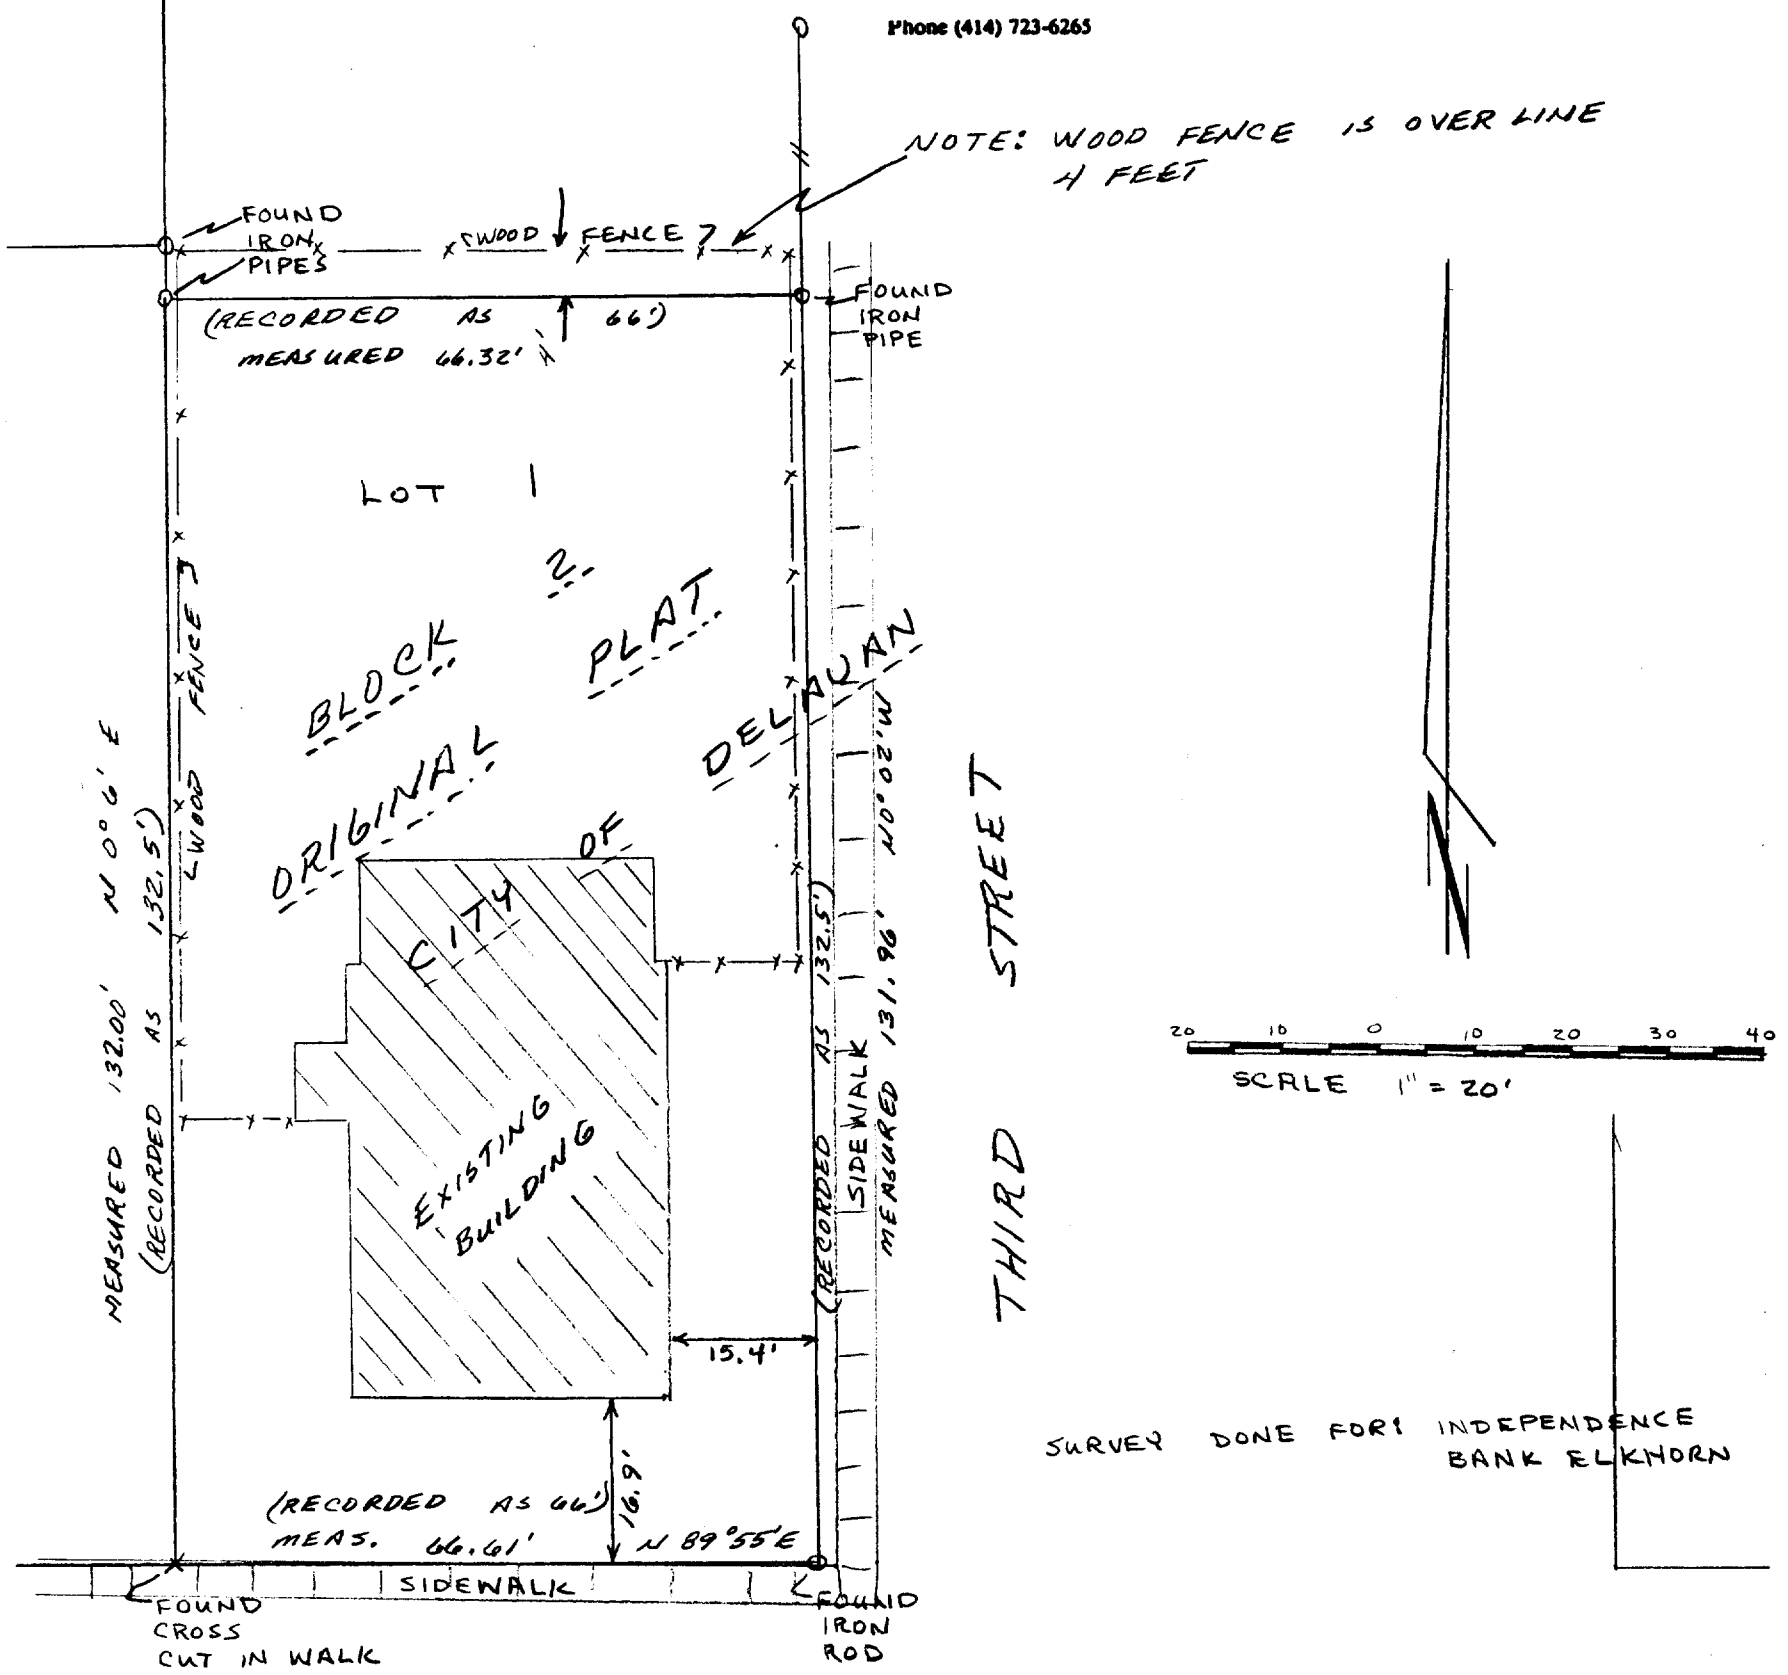

DESCRIPTION OF RECORD.

PLAT OF SURVEY OF THE SOUTHERLY 132.5 FEET OF LOT 1 OF BLOCK 2 OF THE ORIGINAL PLAT OF THE CITY OF DELAVAN, WALWORTH COUNTY, WISCONSIN

I, DANIEL D. COOPER, REGISTERED SURVEYOR, DO HEREBY CERTIFY THAT I HAVE SURVEYED THE PROPERTY DESCRIBED HEREON AND THAT THE MAP SHOWN HEREON IS A TRUE AND ACCURATE REPRESENTATION THEROF TO THE BEST OF MY PROFESSIONAL KNOWLEDGE AND BELIEF.

DATED THIS 17 DAY OF May .1984 Daniel D Cooper
DANIEL D. COOPER, RLS NO. S-1464

WISCONSIN
DANIEL D. COOPER
S-1464
WIS.
LAND SURVEYOR

XOP-2

2-680-C

DRAWING NO. 1916