

DUNHAM SURVEYING, S.C.

SURVEYING & SUBDIVIDING
DELAVAN, WISCONSIN 53115

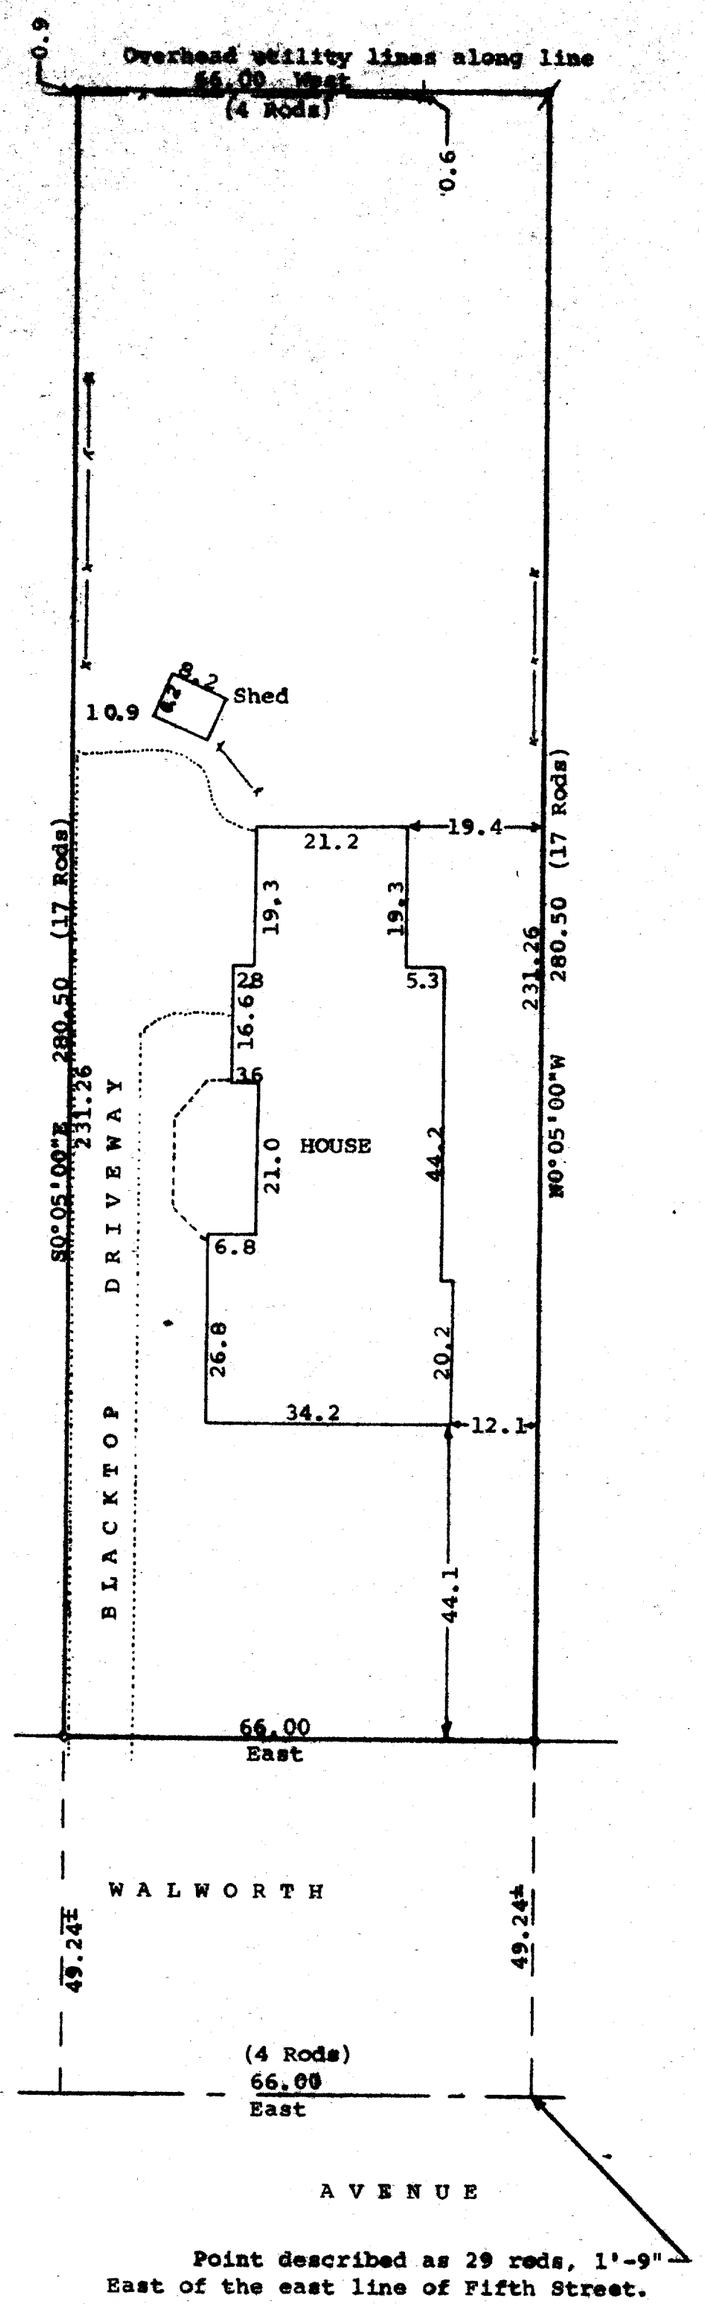

Point described as 29 rods, 1'-9" East of the east line of Fifth Street.
Field measurement = 481.72 feet.

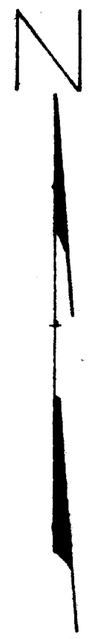

Scale - 1" = 20'
o = 3/4" Dia. Iron Pipe Found
$\not o$ = 1" Dia. Iron Pipe Found
—x—x— = Wooden Fence
(0.00) = Recorded Distance

Bearings are referenced to the north line of Walworth Avenue. Assumed bearing of East used.

Owner: Frank Dederich
601 E. Walworth Ave.
Delavan, Wisconsin 53115

STATE OF WISCONSIN)
COUNTY OF WALWORTH) SS

I, George T. Dunham, Surveyor, certify that I have surveyed the property described as follows,

A parcel of land located in the Northeast ¼ of Section 18, T 2 N, R 16 E, Walworth County, Wisconsin, described as follows: Commencing at the intersection of the east line of Fifth Street and the center line of Walworth Avenue; thence East along said center line 415.72 feet to the place of beginning; thence continue East along said center line 66.00 feet; thence N0°05'00"W 280.50 feet; thence West 66.00 feet; thence S0°05'00"E 280.50 feet to the place of beginning,

and that the plat shown above is a true representation thereof and shows the size and location of the property, its exterior boundaries, the location of boundary fences, apparent easements, roadways and visible encroachments, if any, and that I have surveyed the property hereon described according to the official records to the best of my knowledge and belief.

March 2, 1984

George T. Dunham, Surveyor

WISCONSIN
GEORGE T. DUNHAM
DELAVAN, WIS.
S-306
LAND SURVEYOR

XWOP-103A

2-692