
DUNHAM SURVEYING, S.C.
SURVEYING & SUBDIVIDING
DELAVAN, WISCONSIN 53115

RECEIVED
MAR 5

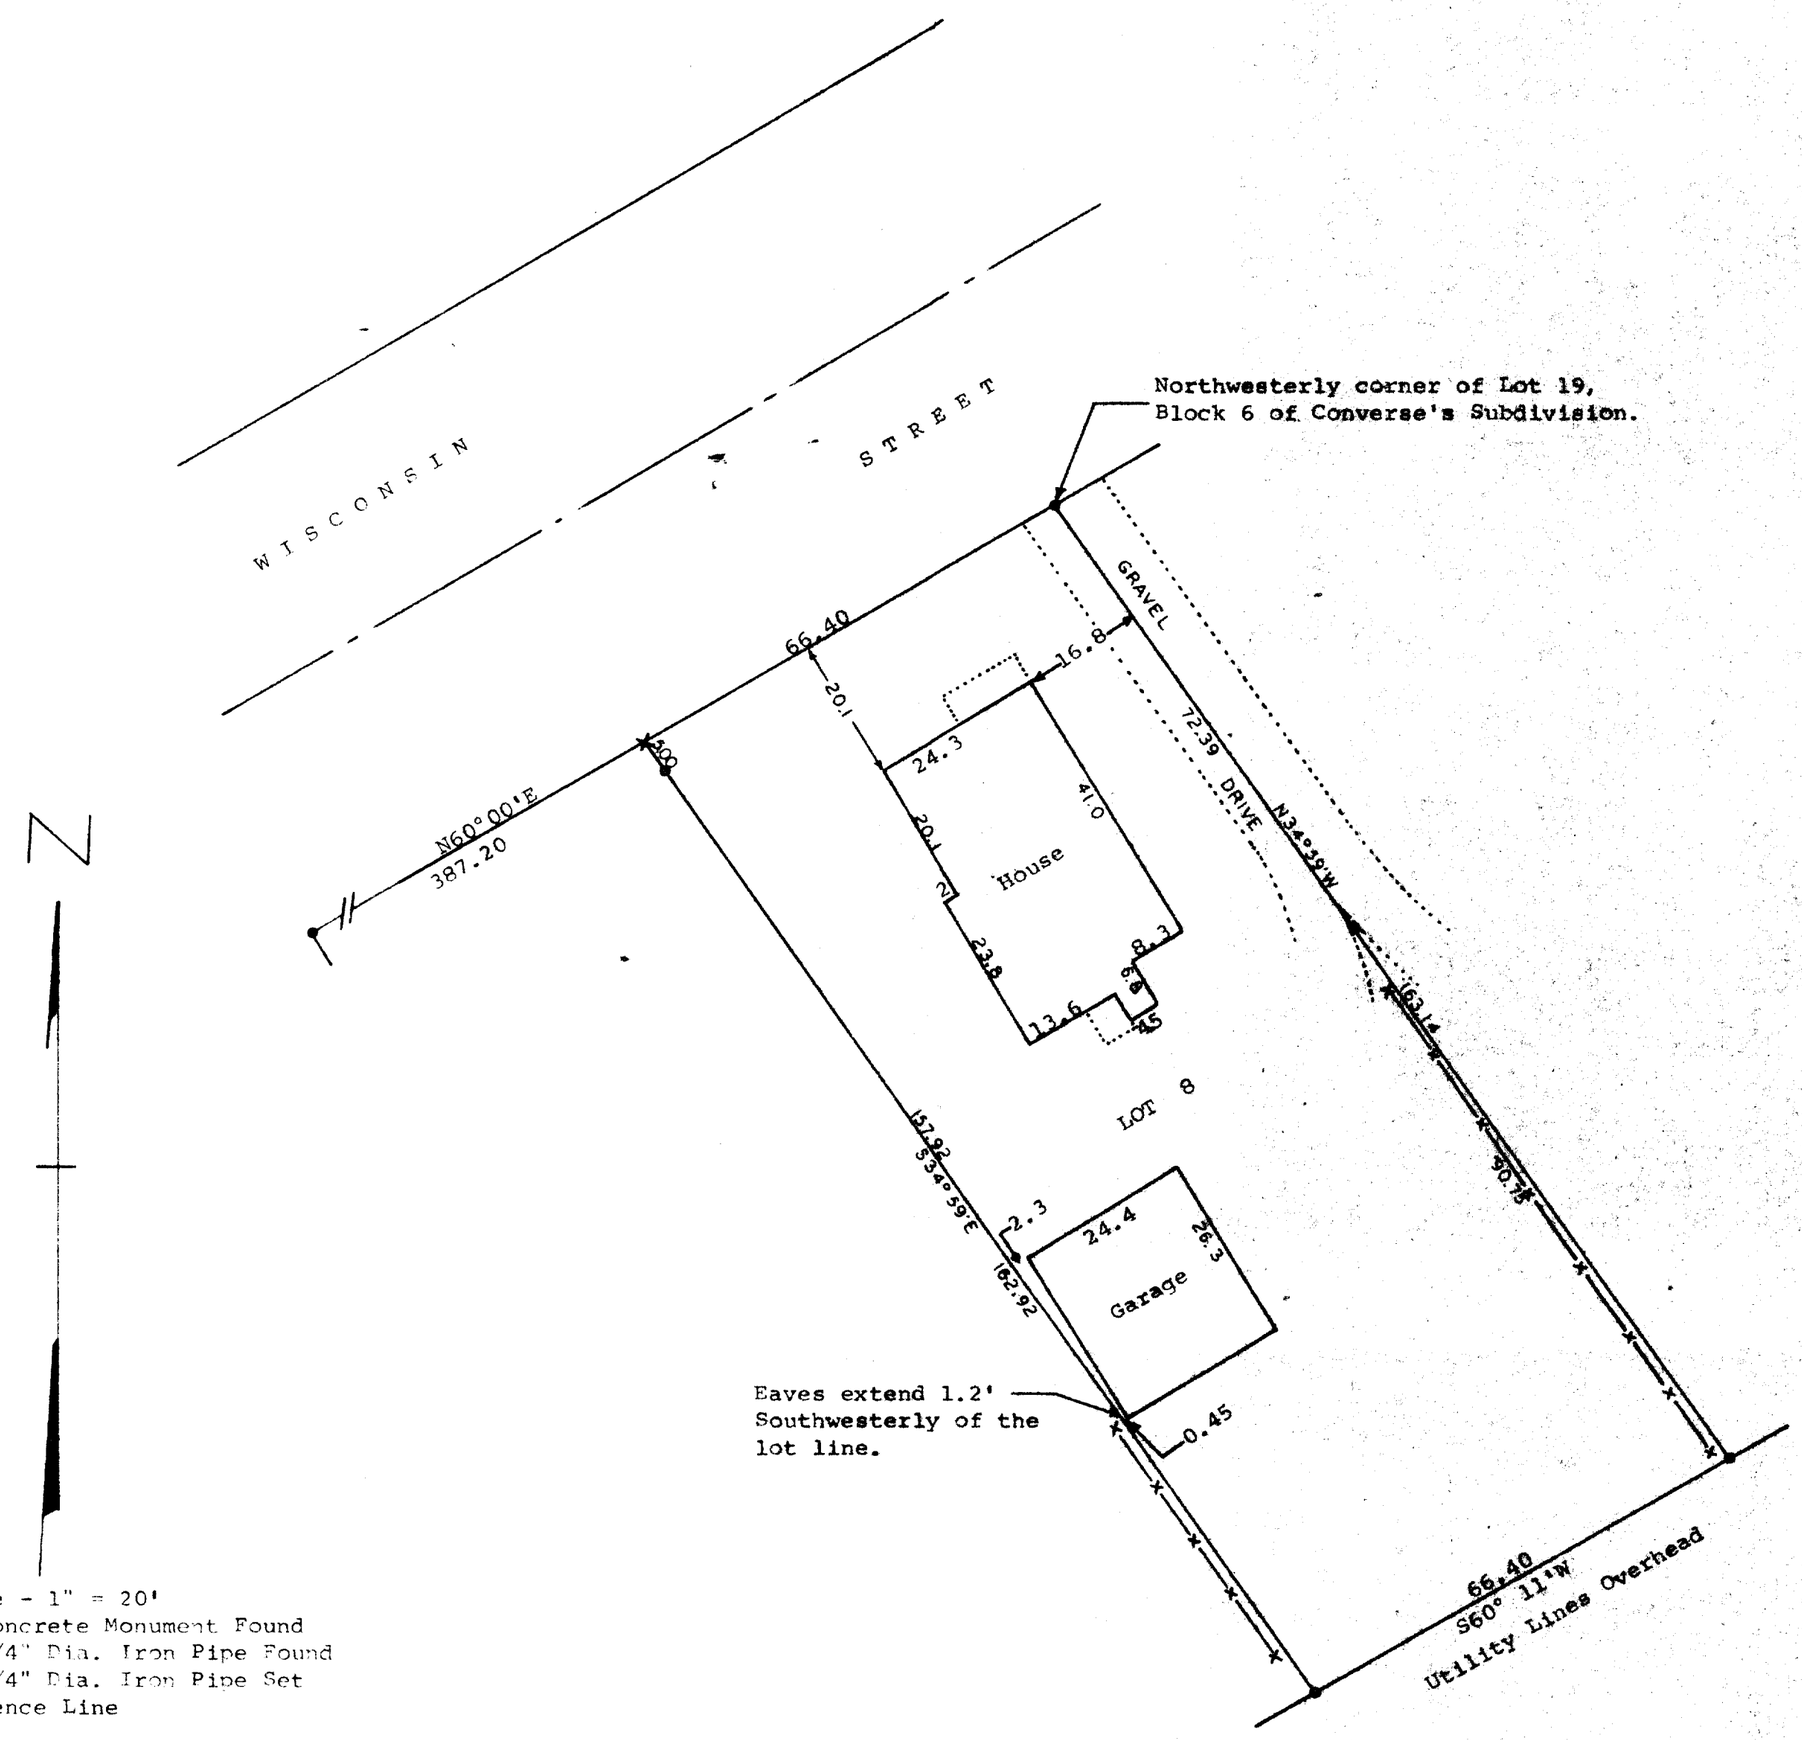

Scale - 1" = 20'
● = Concrete Monument Found
∅ = 3/4" Dia. Iron Pipe Found
o = 3/4" Dia. Iron Pipe Set
—x——x— = Fence Line

Bearings are referenced to the southeasterly line of Wisconsin Street. Assumed bearing of N60°00'E used.

STATE OF WISCONSIN)
COUNTY OF WALWORTH) SS

I, George T. Dunham, Surveyor, certify that I have surveyed the property described as follows,

Lot 8 of Heiss Shanahan Subdivision, located in the City of Delavan, Walworth County, Wisconsin,

and that the map shown hereon is a correct representation thereof and shows the size and location of the property, its exterior boundaries, the location of all visible structures and dimensions of all principal buildings thereon, boundary fences, apparent easements, roadways and visible encroachments, if any, and that I have surveyed the property hereon described, according to the official records, to the best of my knowledge and belief.

November 24, 1986

George T. Dunham, Surveyor

WISCONSIN LAND SURVEYOR
GEORGE T. DUNHAM
S-306
DELAVAN WIS.

18307

XHS-7

2-743

GMB 1020