
ABELL
SURVEYING & MAPPING
DELAVAN, WISCONSIN 53115
414-728-6737

RECEIVED

BRADLEY AVENUE

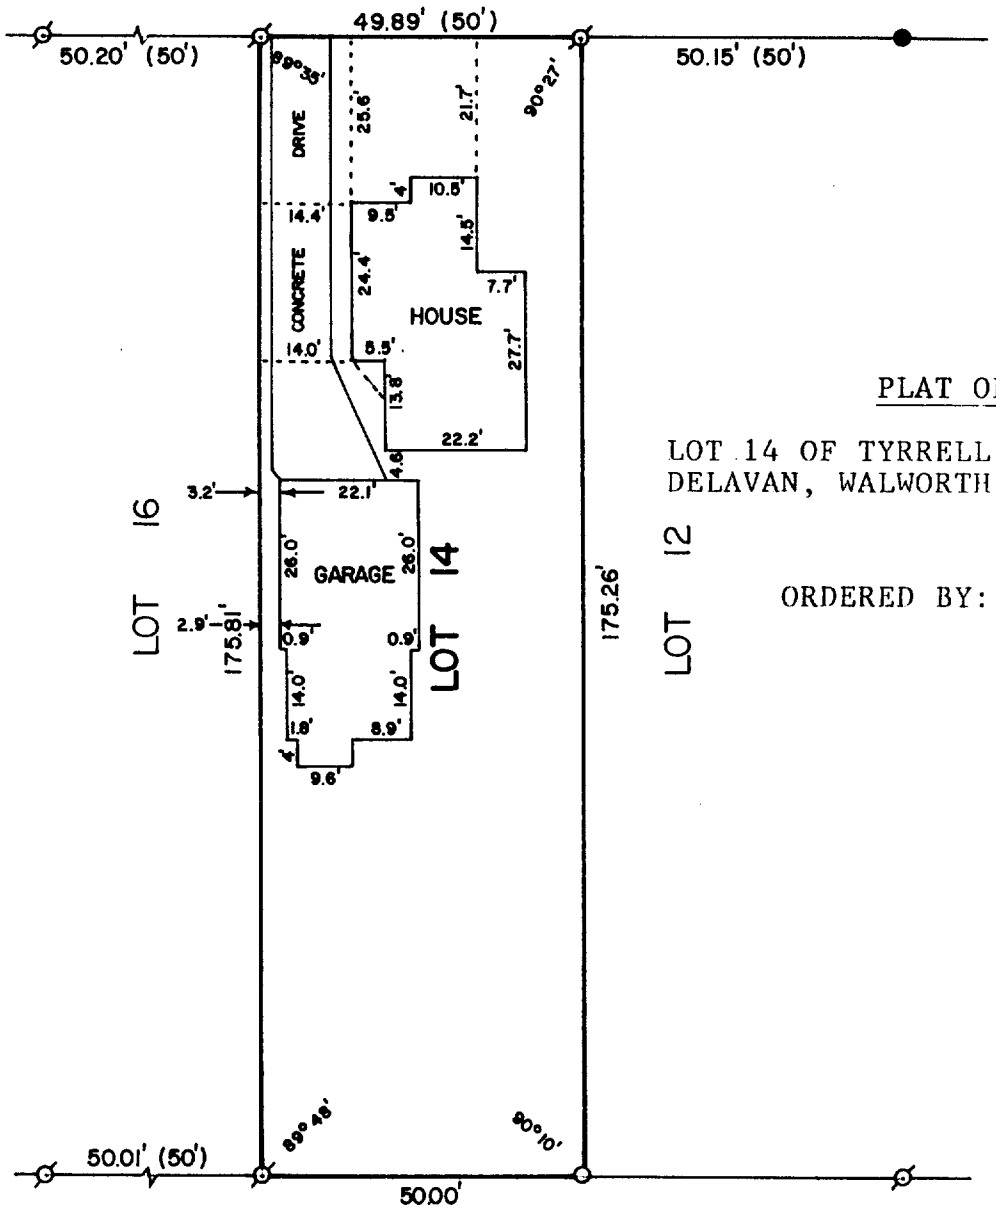

PLAT OF SURVEY OF

LOT 14 OF TYRRELL SUBDIVISION, CITY OF DELAVAN, WALWORTH COUNTY, WISCONSIN.

ORDERED BY: ANCHOR SAVINGS & LOAN
500 E. WALWORTH AVE.
DELAVAN, WI. 53115

SCALE - 1"=30'

LEGEND

- ⌀ - IRON PIPE FOUND
- ● - IRON ROD FOUND
- ○ - IRON ROD SET
- ( )- RECORDED AS

I, DAVID F. ABELL, DO HEREBY CERTIFY THAT I HAVE SURVEYED THE PROPERTY HEREON DESCRIBED ACCORDING TO THE OFFICIAL RECORDS AND THAT THE PLAT HEREON IS A CORRECT REPRESENTATION OF THE PROPERTY LINES TO THE BEST OF MY KNOWLEDGE AND BELIEF.

David F. Abell
DAVID F. ABELL
WISCONSIN REGISTERED LAND SURVEYOR, S-1596

November 23, 1987
DATE JOB NUMBER -87186

NOTE: THIS IS NOT A CERTIFIED COPY UNLESS SEALED.

2-903