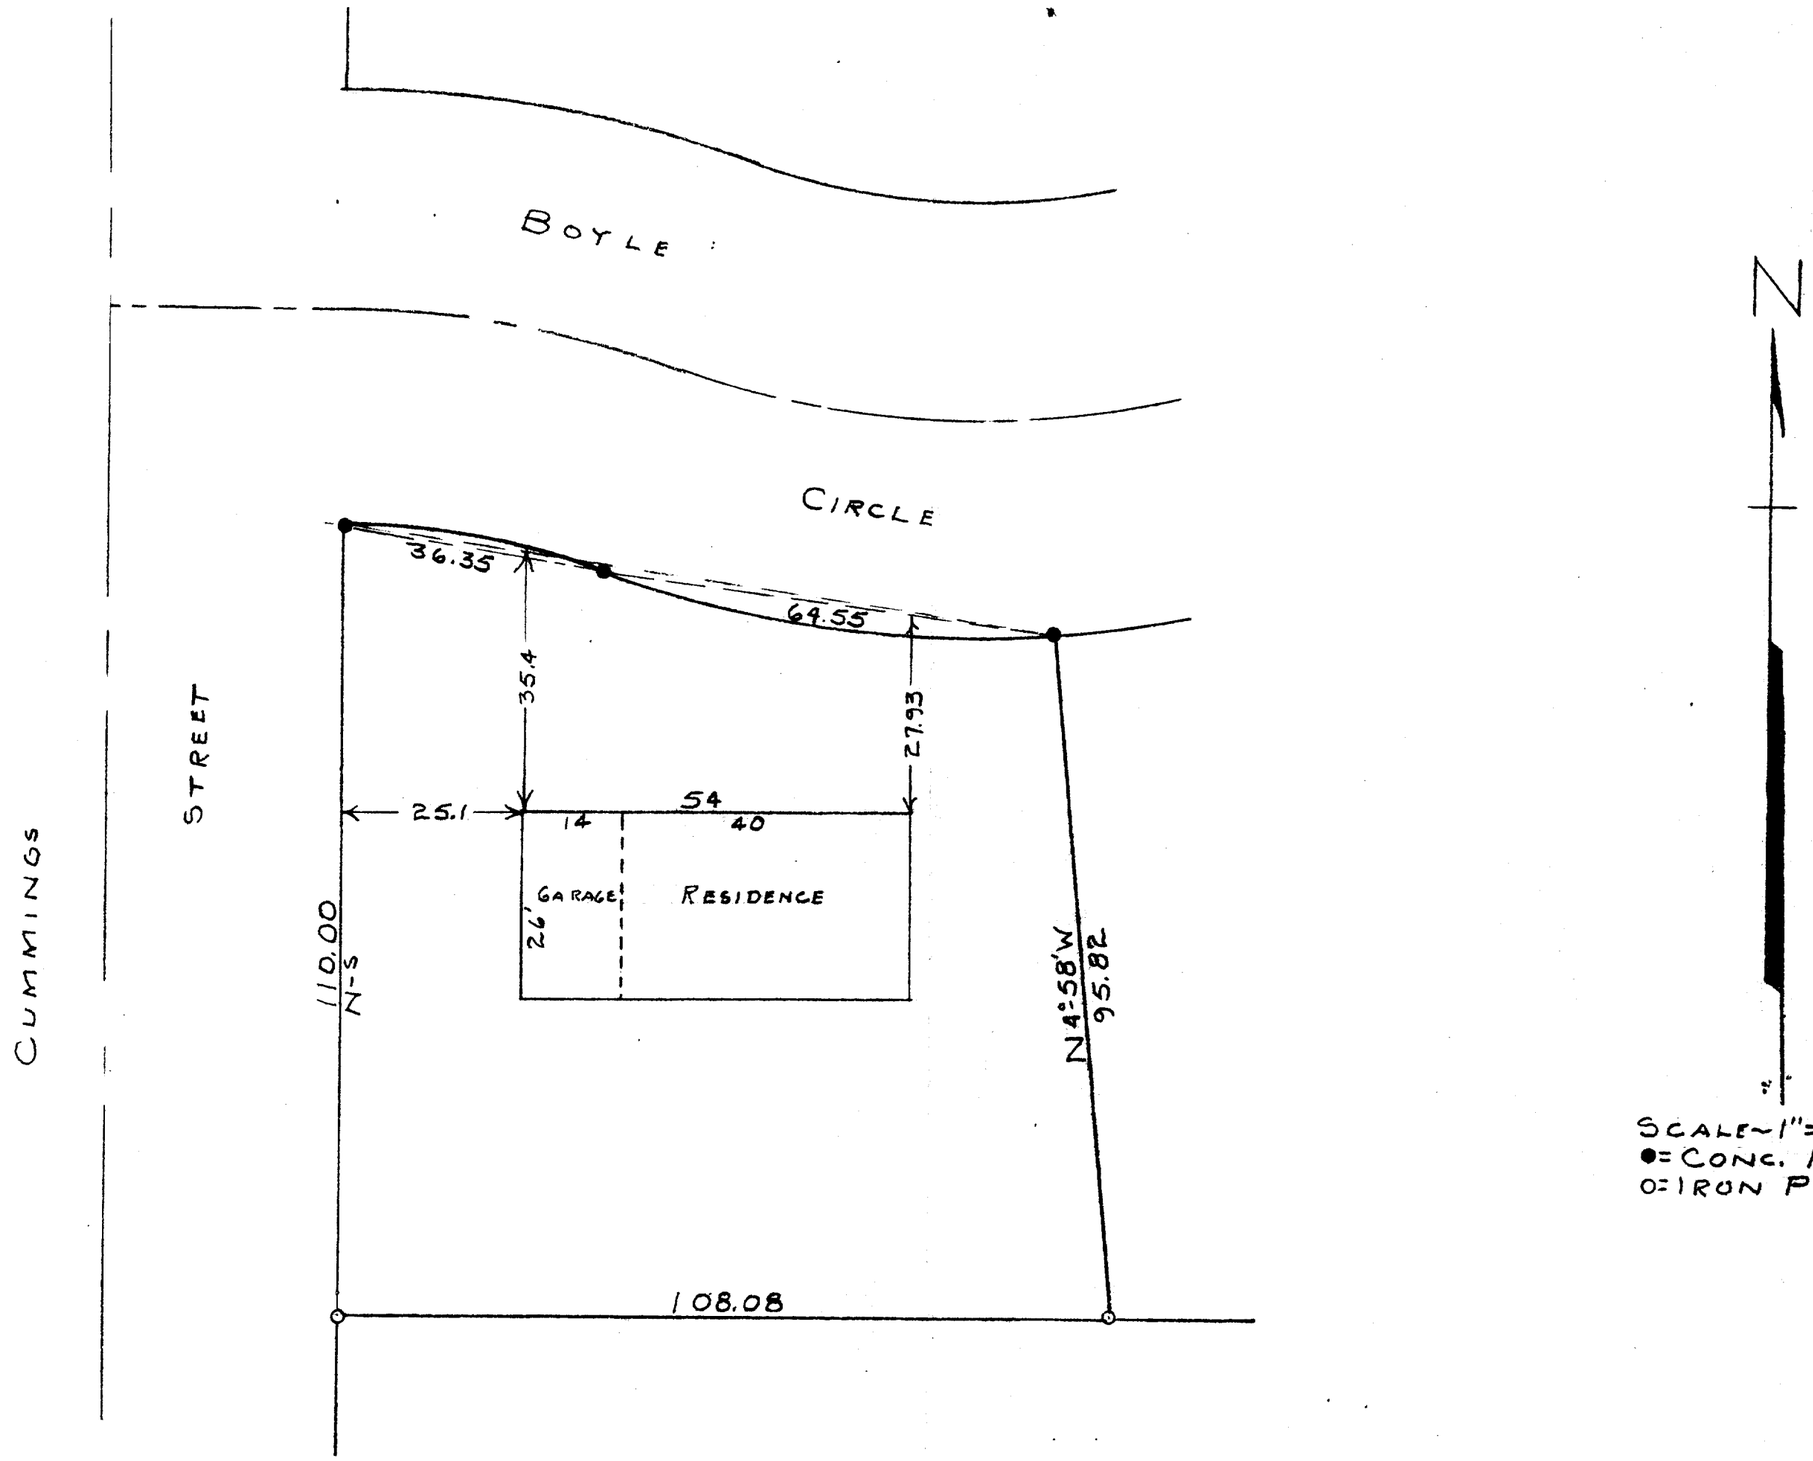

STATE OF WISCONSIN)
WALWORTH COUNTY) SS

I, GEORGE T. DUNHAM, DO HEREBY CERTIFY THAT I HAVE SURVEYED THE PROPERTY DESCRIBED AS FOLLOWS, TO-WIT:

LOT 17 OF HILLTOP SUBDIVISION LOCATED IN SECTION 18, T2NR16E, CITY OF DELAVAN, WALWORTH COUNTY, WISCONSIN

AND THAT THE PLAT SHOWN ABOVE IS A CORRECT REPRESENTATION OF THE PROPERTY LINES AND OF THE IMPROVEMENTS LOCATED THEREON.

JUNE 11, 1958

George T. Dunham

GEORGE T. DUNHAM, SURVEYOR
DELAVAN, WISCONSIN

2-84

XH1-17