RECEIVED
JUL 6 1988

ABELL
SURVEYING & MAPPING
DELAVAN, WISCONSIN 53115
414-728-6737

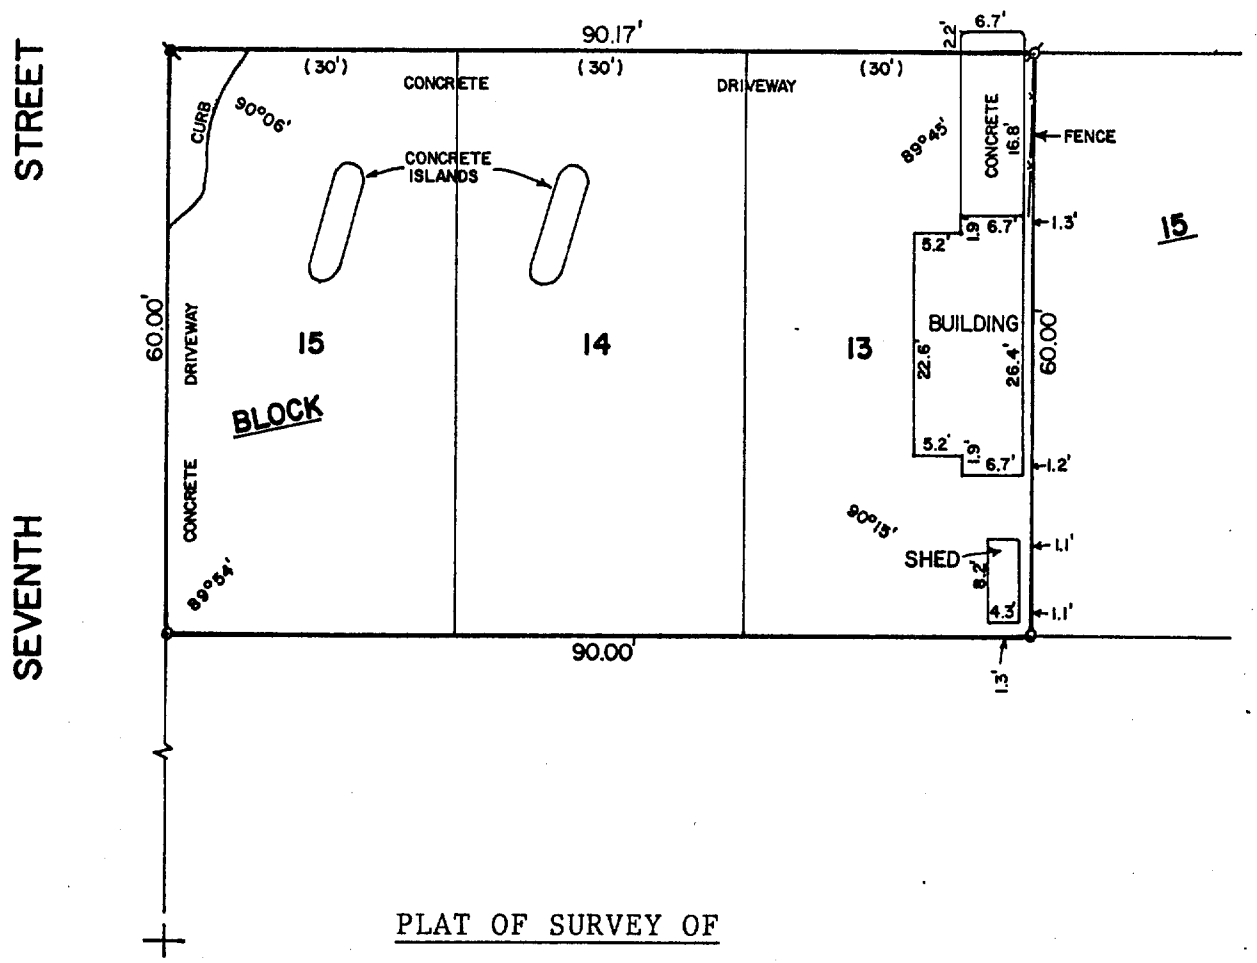

PLAT OF SURVEY OF

LOTS 13-15, BLOCK 15, PASSAGE, ARAM & DOWNIE ADDITION, CITY OF DELAVAN, WALWORTH COUNTY, WISCONSIN.

ORDERED BY: JERRY DeFRANCISO
c/o DUANE MATRANGE
20 ORCHARD ST.
WILLIAMS BAY, WI. 53191

SCALE - 1"=20'

LEGEND
- IRON PIPE FOUND
- IRON ROD IN CONCRETE FOUND
+ - CUT CROSS IN CONCRETE FOUND
( )- RECORDED AS
o - IRON ROD SET

I, DAVID F. ABELL, DO HEREBY CERTIFY THAT I HAVE SURVEYED THE PROPERTY HEREON DESCRIBED ACCORDING TO THE OFFICIAL RECORDS AND THAT THE PLAT HEREON IS A CORRECT REPRESENTATION OF THE PROPERTY LINES TO THE BEST OF MY KNOWLEDGE AND BELIEF.

David F. Abell
DAVID F. ABELL
WISCONSIN REGISTERED LAND SURVEYOR, S-1596

April 6, 1988
DATE JOB NUMBER - 88047

NOTE: THIS IS NOT A CERTIFIED COPY UNLESS SEALED.

2-841