

ABELL
SURVEYING & MAPPING
DELAVAN, WISCONSIN 53115
414-728-6737

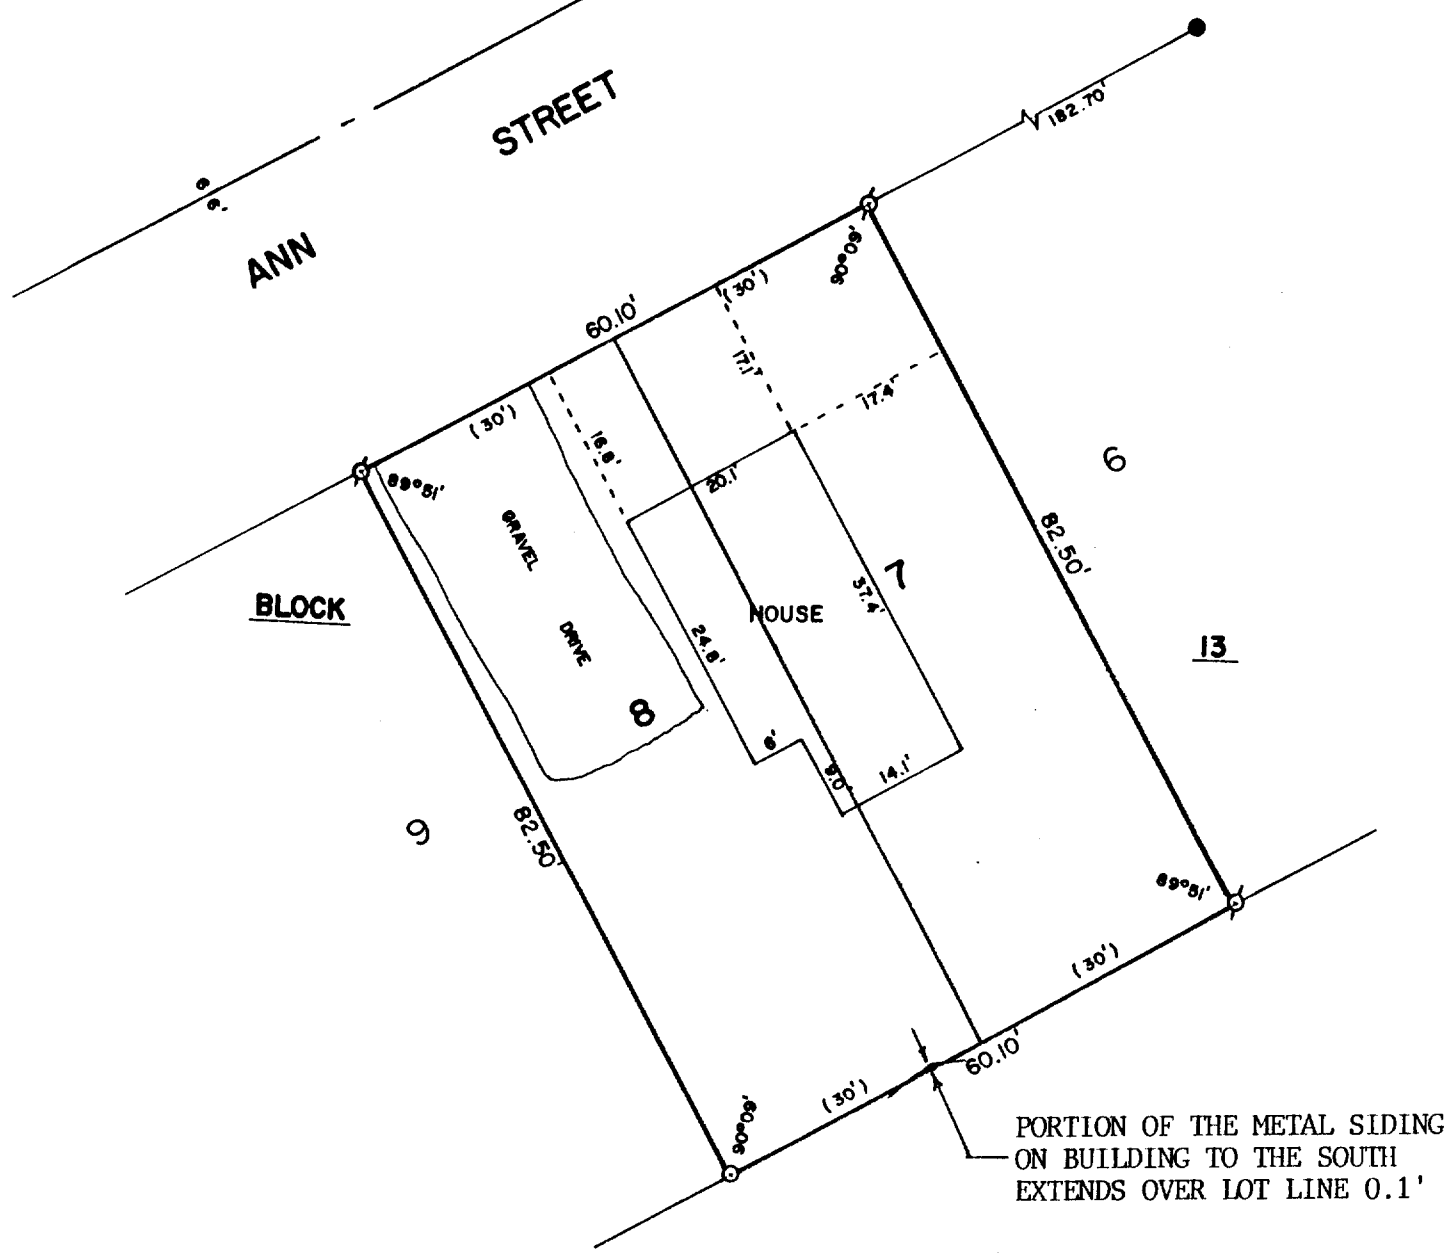

PLAT OF SURVEY OF

LOTS 7 AND 8, BLOCK 13, PASSAGE, ARAM AND DOWNIE ADDITION TO THE CITY OF DELAVAN, WALWORTH COUNTY, WISCONSIN.

ORDERED BY: CENTURY 21 - SKANDIA REALTY
312 S. 7th STREET
DELAVAN, WI. 53115

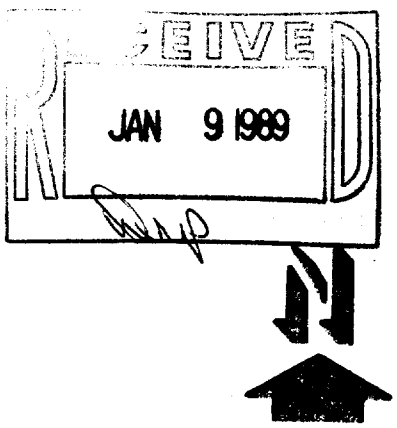

SCALE - 1"=20'

LEGEND
- ⌀ - IRON PIPE FOUND
- o - IRON ROD SET
- ⌀ - CONCRETE MONUMENT FOUND
- ( )- AS SHOWN ON EXISTING SURVEY RECORDS

I, DAVID F. ABELL, DO HEREBY CERTIFY THAT I HAVE SURVEYED THE PROPERTY HEREON DESCRIBED ACCORDING TO THE OFFICIAL RECORDS AND THAT THE PLAT HEREON IS A CORRECT REPRESENTATION OF THE PROPERTY LINES TO THE BEST OF MY KNOWLEDGE AND BELIEF.

David F. Abell
DAVID F. ABELL
WISCONSIN REGISTERED LAND SURVEYOR, S-1596

August 11, 1988
DATE JOB NUMBER - 88183

NOTE: THIS IS NOT A CERTIFIED COPY UNLESS SEALED.

XP-168A

2-900