# PLAT OF SURVEY
## –OF–

LOTS 6, 7, 8, AND 9, ALL IN BLOCK 3, EXCLUDING THE SOUTHERLY 26.31 FEET THEREOF, CLARKE'S ADDITION TO THE VILLAGE OF EAST TROY, WALWORTH COUNTY, WISCONSIN.


SURVEY FOR: BRUCE KLAMM

SURVEY ADDRESS: 3023 GRAYDON AVE.

NOTE: BEARINGS HEREON RELATE TO THE SOUTH LINE OF GRAYDON AVENUE. ASSUMED BEARING N89°46'44"E.


"I hereby certify that I have surveyed the above described property and that the above map is a correct representation thereof and shows the size and location of the property, its exterior boundaries, the location of all visible structures and dimensions of all principal buildings thereon, boundary fences, apparent easements, roadways and encroachments, if any."

"This survey is made for the use of the present owners of the property, and those who purchase, mortgage, or guarantee the title thereto within one year from date hereof."

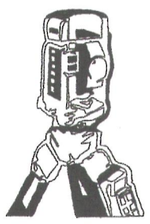


B.W. SURVEYING, INC.

LAND SURVEYS
MAPPING AND PLANNING
412 N. PINE STREET
BURLINGTON, WI 53105
(262)–767–0225

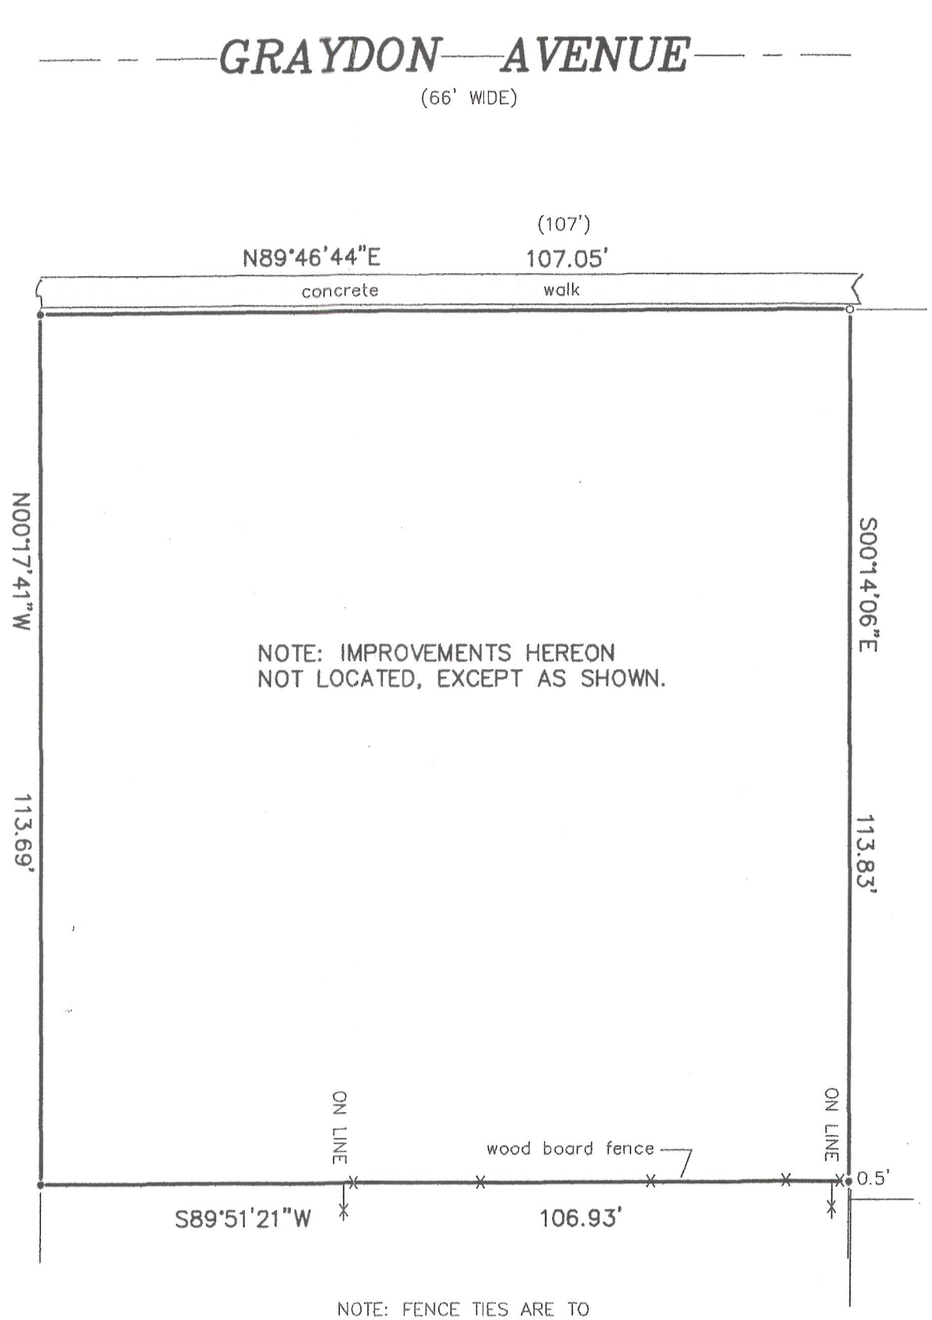
NOTE: FENCE TIES ARE TO CENTER OF POSTS.


RECEIVED
OCT – 5 2012
By SMF




LEGEND

- ○ FOUND IRON PIPE
- ● FOUND IRON ROD


WISCONSIN
ROBERT J. WETZEL
S-1778
BURLINGTON, WI
LAND SURVEYOR


THIS IS NOT AN ORIGINAL PRINT UNLESS THIS SEAL IS RED.

Robert J. Wetzel
ROBERT J. WETZEL S–1778

MAY 31, 2012 — DATE

8471 — JOB NUMBER

RCA-22

003-1010