PLAT OF SURVEY
OF

PART OF THE NORTHEAST 1/4 OF SECTION 30, T. 4 N., R. 18 E. OF THE 4TH P.M., VILLAGE OF EAST TROY, WALWORTH COUNTY, WISCONSIN, MORE PARTICULARLY DESCRIBED AS FOLLOWS: COMMENCE AT THE NORTHWEST CORNER OF H. F. EBERT'S SUBDIVISION, THENCE SOUTH 16.50 FEET TO THE PLACE OF BEGINNING OF PARCEL OF LAND HEREINAFTER DESCRIBED: THENCE CONTINUE SOUTH ALONG THE WEST LINE OF SAID LOT 5, to the SOUTHWEST CORNER OF SAID LOT 5; THENCE WEST 66 FEET; THENCE NORTH 148.5 FEET; THENCE EAST 66 FEET TO THE PLACE OF BEGINNING.


I HEREBY CERTIFY THAT I HAVE SURVEYED THE LAND DESCRIBED ABOVE AND THAT THE PLAT DRAWN HEREON IS A CORRECT REPRESENTATION OF SAID SURVEY. I FURTHER CERTIFY THAT THE BUILDINGS ON SAID LAND ARE LOCATED AS SHOWN ON THIS PLAT.

John F Degen 4-29-75

JOHN F. DEGEN, LAND SURVEYOR #242
589 N. PINE ST., BURLINGTON, WISCONSIN.

SCALE 1" = 30'
o = IRON PIPE STAKE FOUND OR SET AS NOTED ON PLAT.
FOR: C-MAC BUILDING CORP.

WISCONSIN
JOHN F. DEGEN
BURLINGTON, WIS.
LAND SURVEYOR

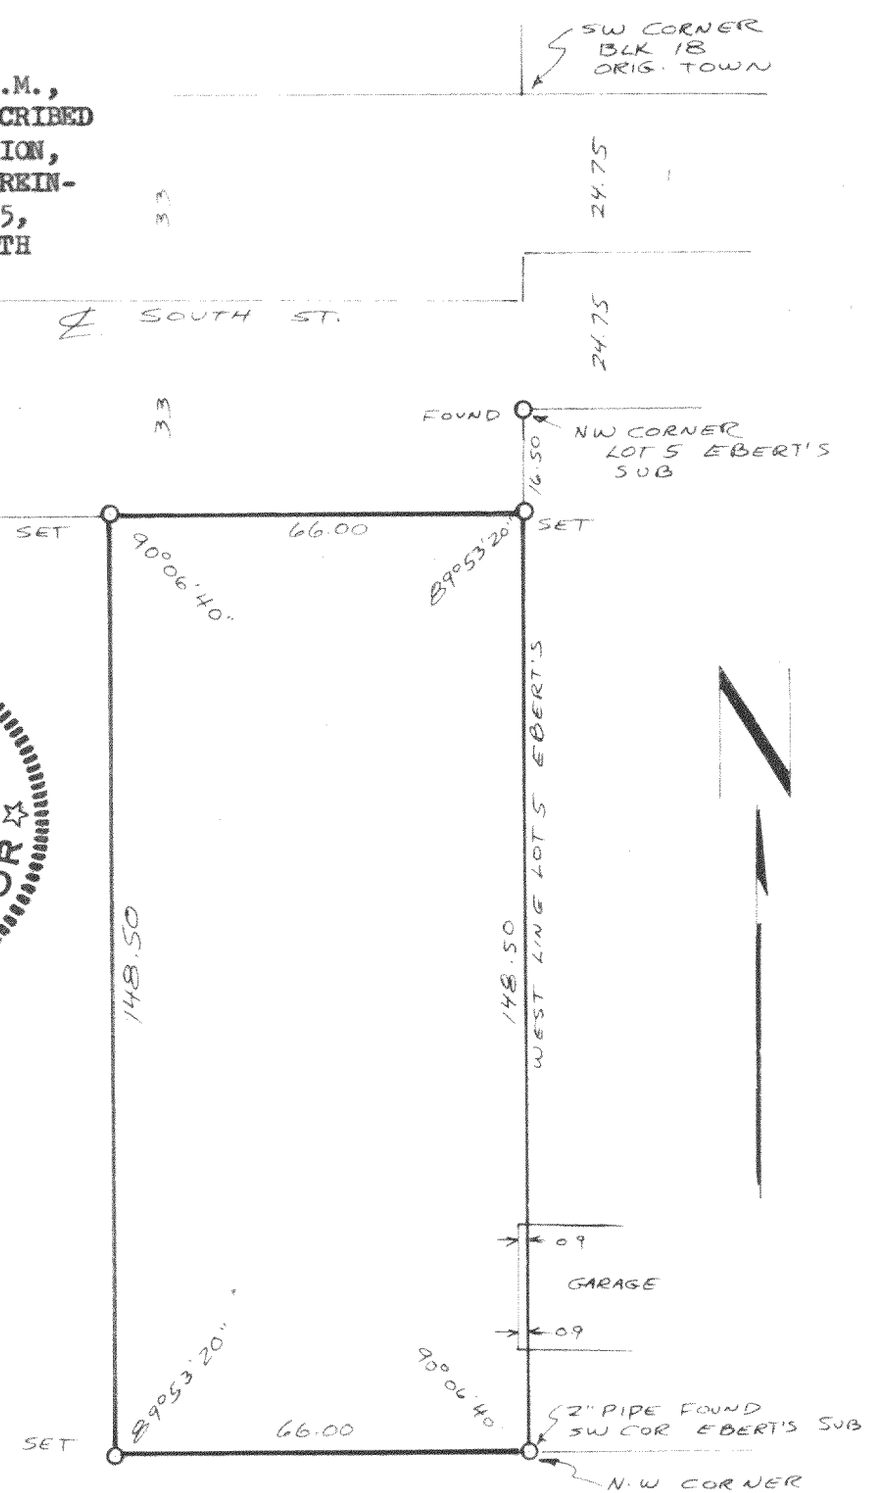

UP-191A

3-102