PLAT OF SURVEY
-OF-

COMMENCING AT A POINT IN THE NORTH LINE OF LOT 3, BLOCK 11, VILLAGE OF EAST TROY, 46 FEET WEST OF THE NORTHEAST CORNER OF SAID LOT 3, RUN THENCE SOUTH PARALLEL WITH THE EAST LINE OF SAID LOT TO THE SOUTH LINE OF SAID LOT, THENCE EAST ALONG THE SOUTH LINE OF SAID LOT 46 FEET TO THE SOUTHEAST CORNER OF SAID LOT; THENCE NORTH ALONG THE EAST LINE OF SAID LOT TO THE NORTHEAST CORNER OF SAID LOT, THENCE WEST ALONG THE NORTH LINE OF SAID LOT 46 FEET TO THE POINT OF BEGINNING. SAID LAND BEING IN THE VILLAGE OF EAST TROY, WALWORTH COUNTY, WISCONSIN.

SURVEY FOR: TIM BARR
SURVEY LOCATION: 2885 MAIN STREET

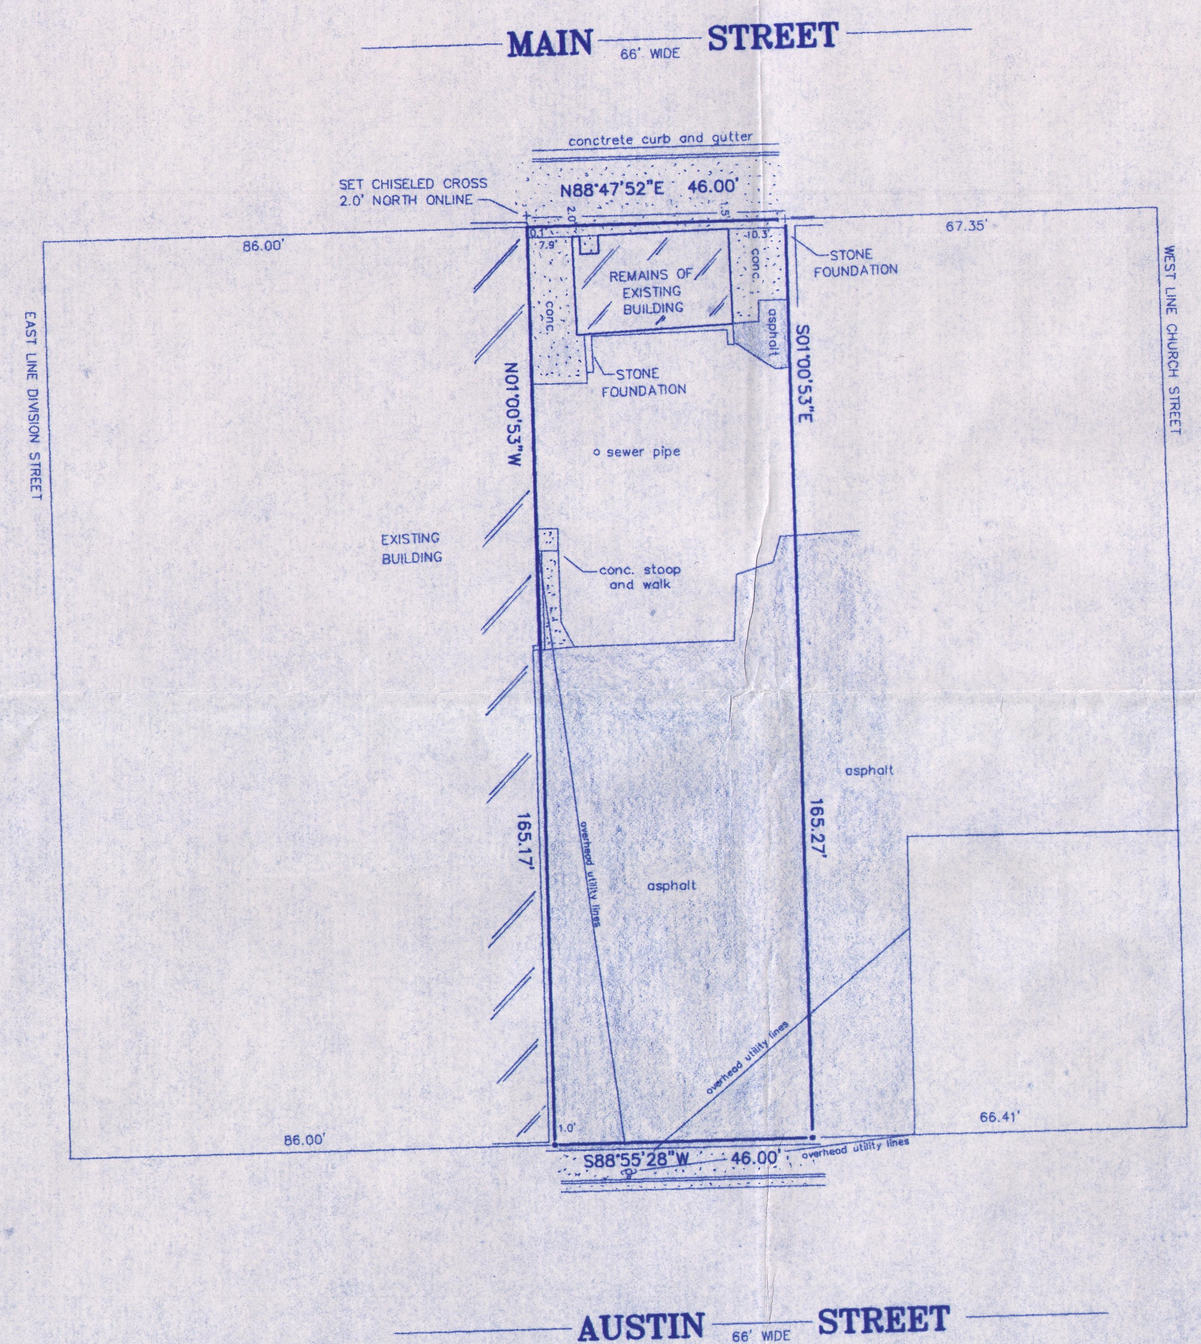

BEARINGS HEREON RELATE TO THE DATUM USED IN THE PLATS OF BONNERS LAKE RESORT AND SUMMERHAVEN SUBDIVISION.

GRAPHIC SCALE
20 10 0 20
SCALE: 1 = 20'

LEGEND

- o FOUND IRON PIPE
- • SET NAIL
- + SET CHISELED CROSS
- UTILITY POLE

WISCONSIN ROBERT J. WETZEL S-1778 BURLINGTON, WI LAND SURVEYOR

RECEIVED OCT 24 2013 gle

THIS IS NOT AN ORIGINAL PRINT UNLESS THIS SEAL IS RED.

ROBERT J. WETZEL S-1778

B.W. SURVEYING, INC.
412 N. PINE STREET
BURLINGTON, WI 53105
(262)-767-0225

DRAWN BY:	bw	DATE:	REVISED: JULY 15, 2013 JUNE 17, 2013
CHECKED BY:	rw/dw	DRAWING NO.:	8636d1
JOB NO.:	8636	SHEET 1 OF 1	

ROP -107 003-1036