
# PLAT OF SURVEY

A parcel of land being part of Lot 11, Block B of Lenck's Park Addition to the Village of East Troy, Walworth County, Wisconsin, beginning at the Southeast corner of Lot 7 of said Block B; thence North 89 Degrees East 133 feet; which line is the South line of said Lot 7; thence South 1 degrees East to the North line of Main Street; thence South 81 degrees West along the North line of Main Street 134.30 feet more or less to the Southeast corner of Lot 10 of said Block B; thence North 1 degrees West along the West line of said Lot 11, 244.50 feet to the place of beginning.

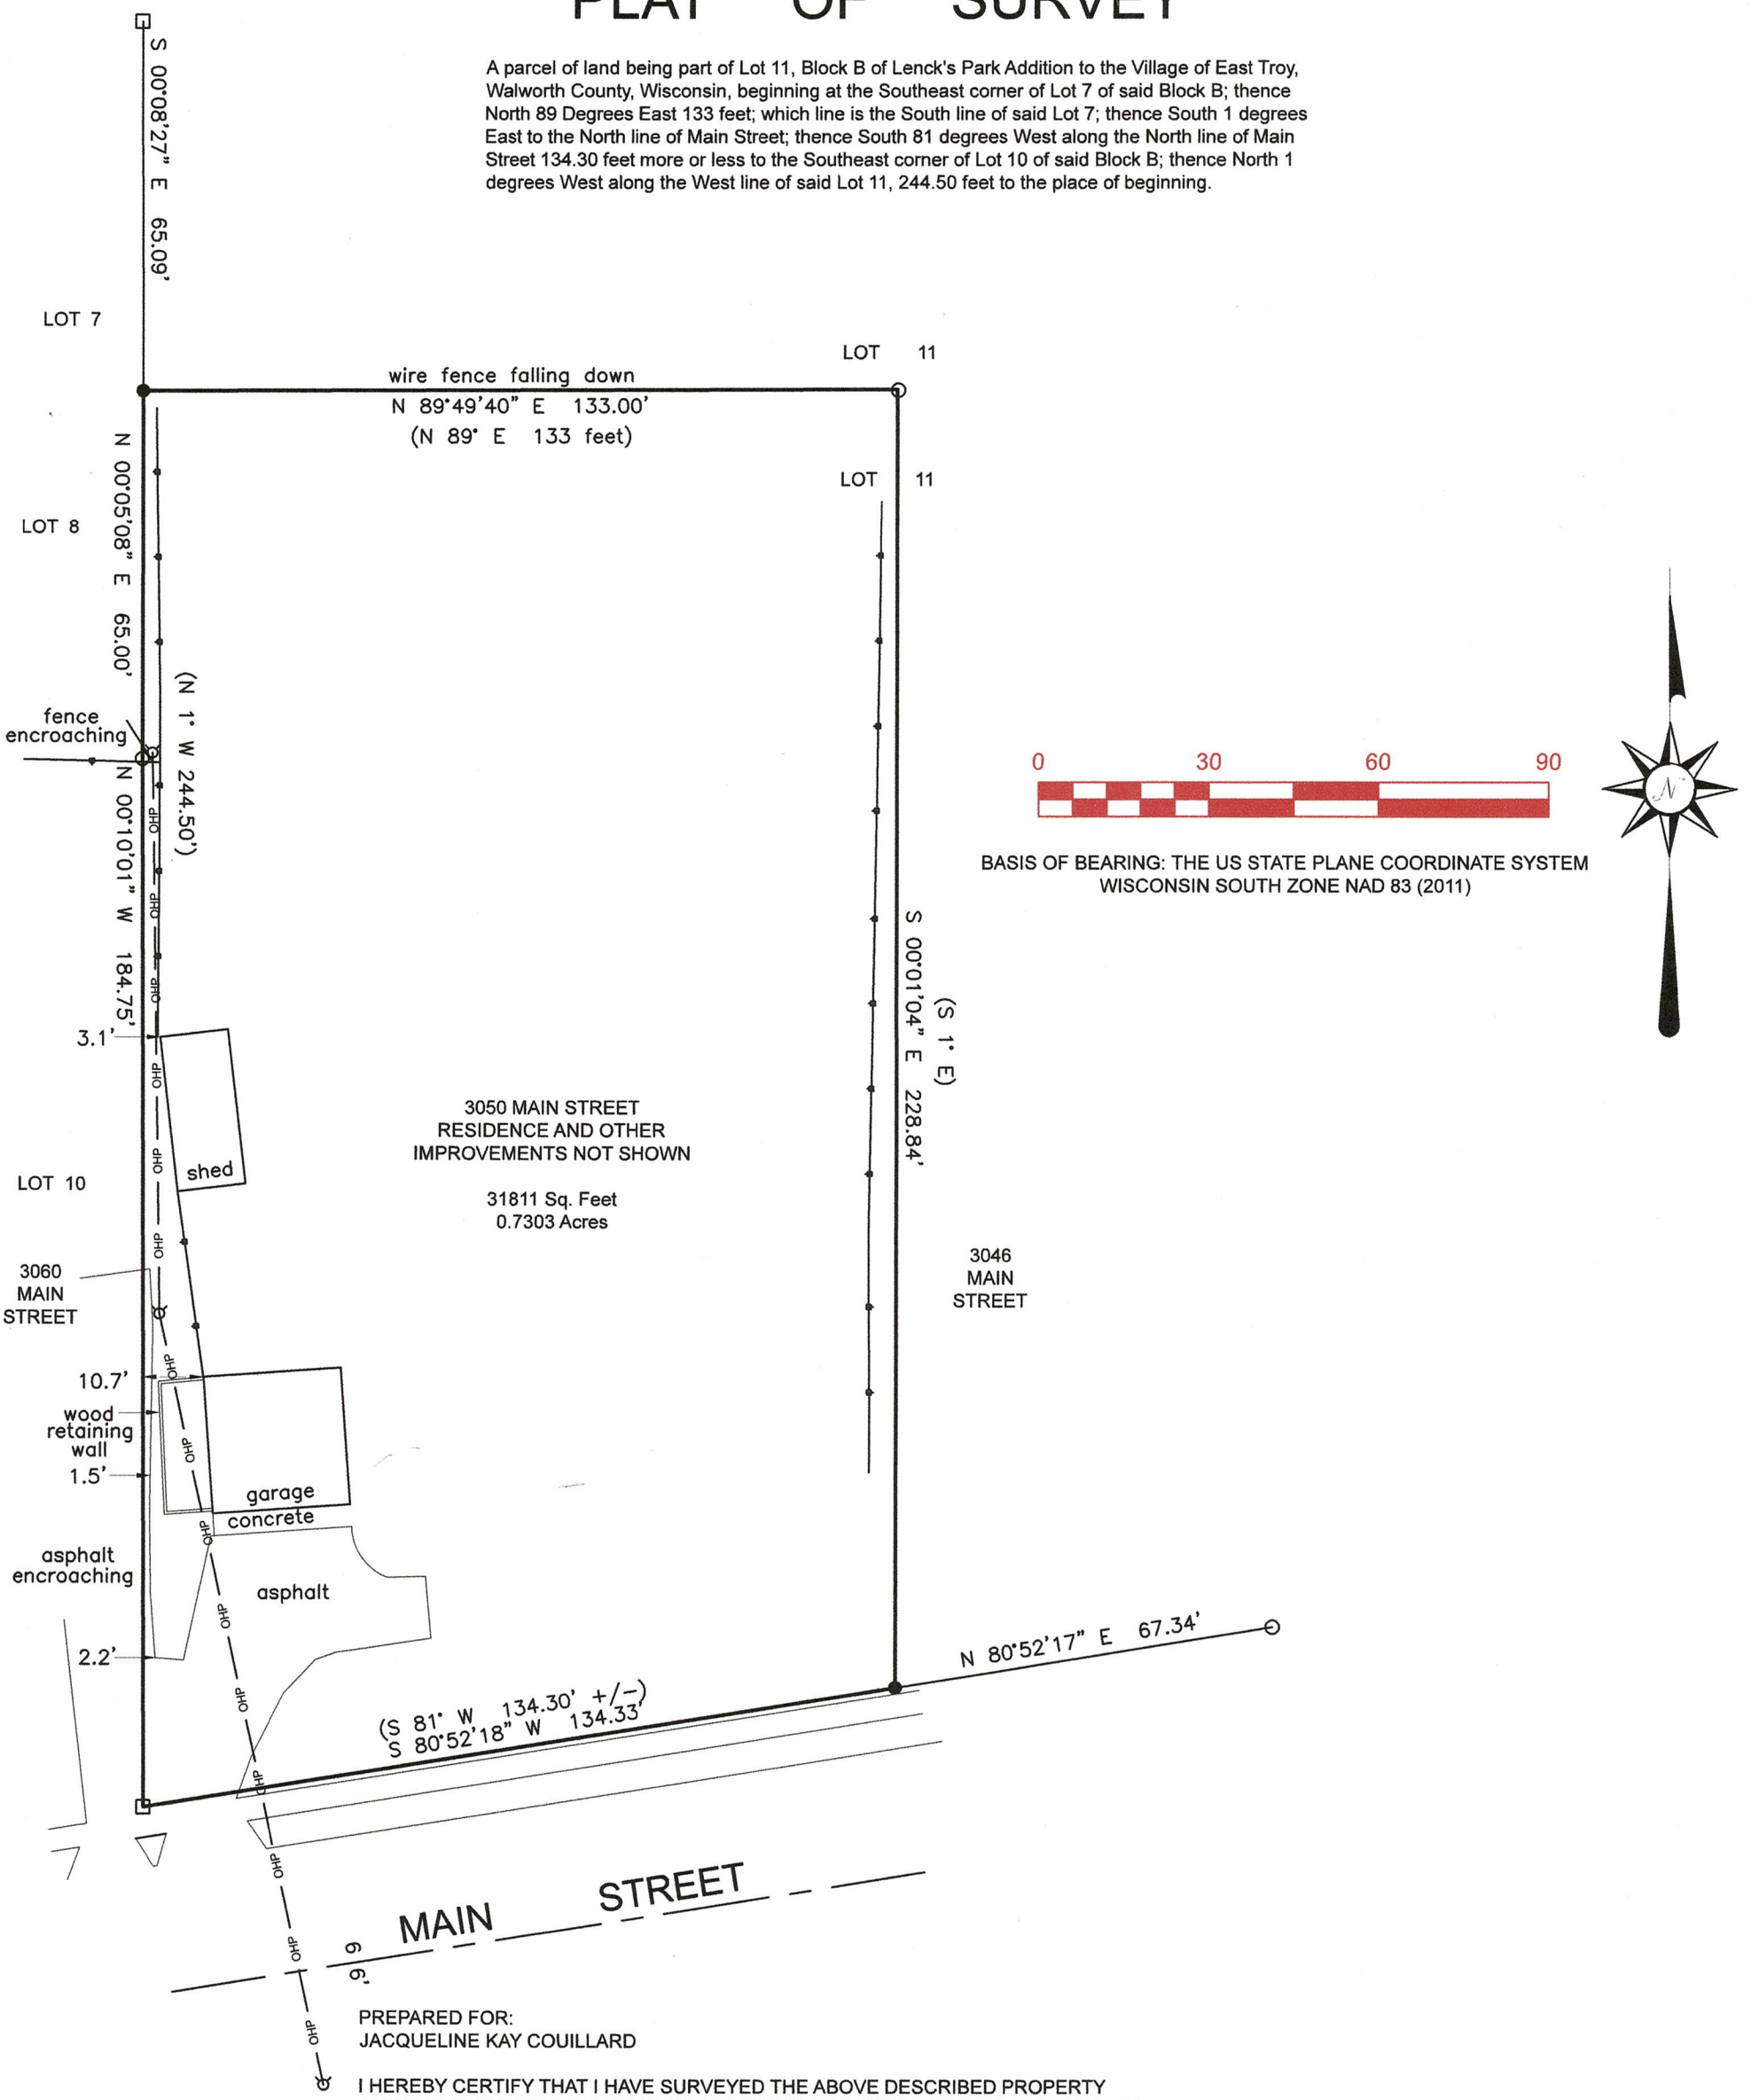


PREPARED FOR:
JACQUELINE KAY COUILLARD

I HEREBY CERTIFY THAT I HAVE SURVEYED THE ABOVE DESCRIBED PROPERTY AND THE ABOVE MAP IS A TRUE REPRESENTATION THEREOF AND SHOWS THE SIZE AND LOCATION OF THE PROPERTY, ITS EXTERIOR BOUNDARIES, THE LOCATION AND DIMENSIONS OF ALL STRUCTURES THEREON, FENCES, APPARENT EASEMENTS, ROADWAYS, AND VISIBLE ENCROACHMENTS. IF ANY.

THIS SURVEY IS MADE FOR THE PRESENT OWNERS OF THE PROPERTY AND THOSE WHO PURCHASE, MORTGAGE, OR GUARANTEE THE TITLE THERETO WITHIN ONE YEAR FROM THIS DATE HEREOF.

DATED THIS 8TH DAY OF NOVEMBER 2024
RECERTIFIED OCTOBER 10, 2026

(XXX) = RECORDED AS

O = FOUND IRON PIPE

□ = FOUND IRON BAR

● = SET IRON PIPE 1" X 24" 1.13 LBS/LF

—— OHP —— = OVERHEAD UTILITY LINES

SCALE 1" = 30'

JOB NO. 2024-059

TAX ID # RLP 00032


LAKELAND SURVEYORS LLC
P O BOX 188
DELAVAN, WI 53115
262-475-9567
email: lakelandsurveyors@outlook.com


WISCONSIN
STEVEN L. SCHMIDT
S-2813
ELKHORN
WI
LAND SURVEYOR

Steve Schmidt

STEVEN L SCHMIDT S - 2813
Wisconsin Professional Land Surveyor