
#77-66

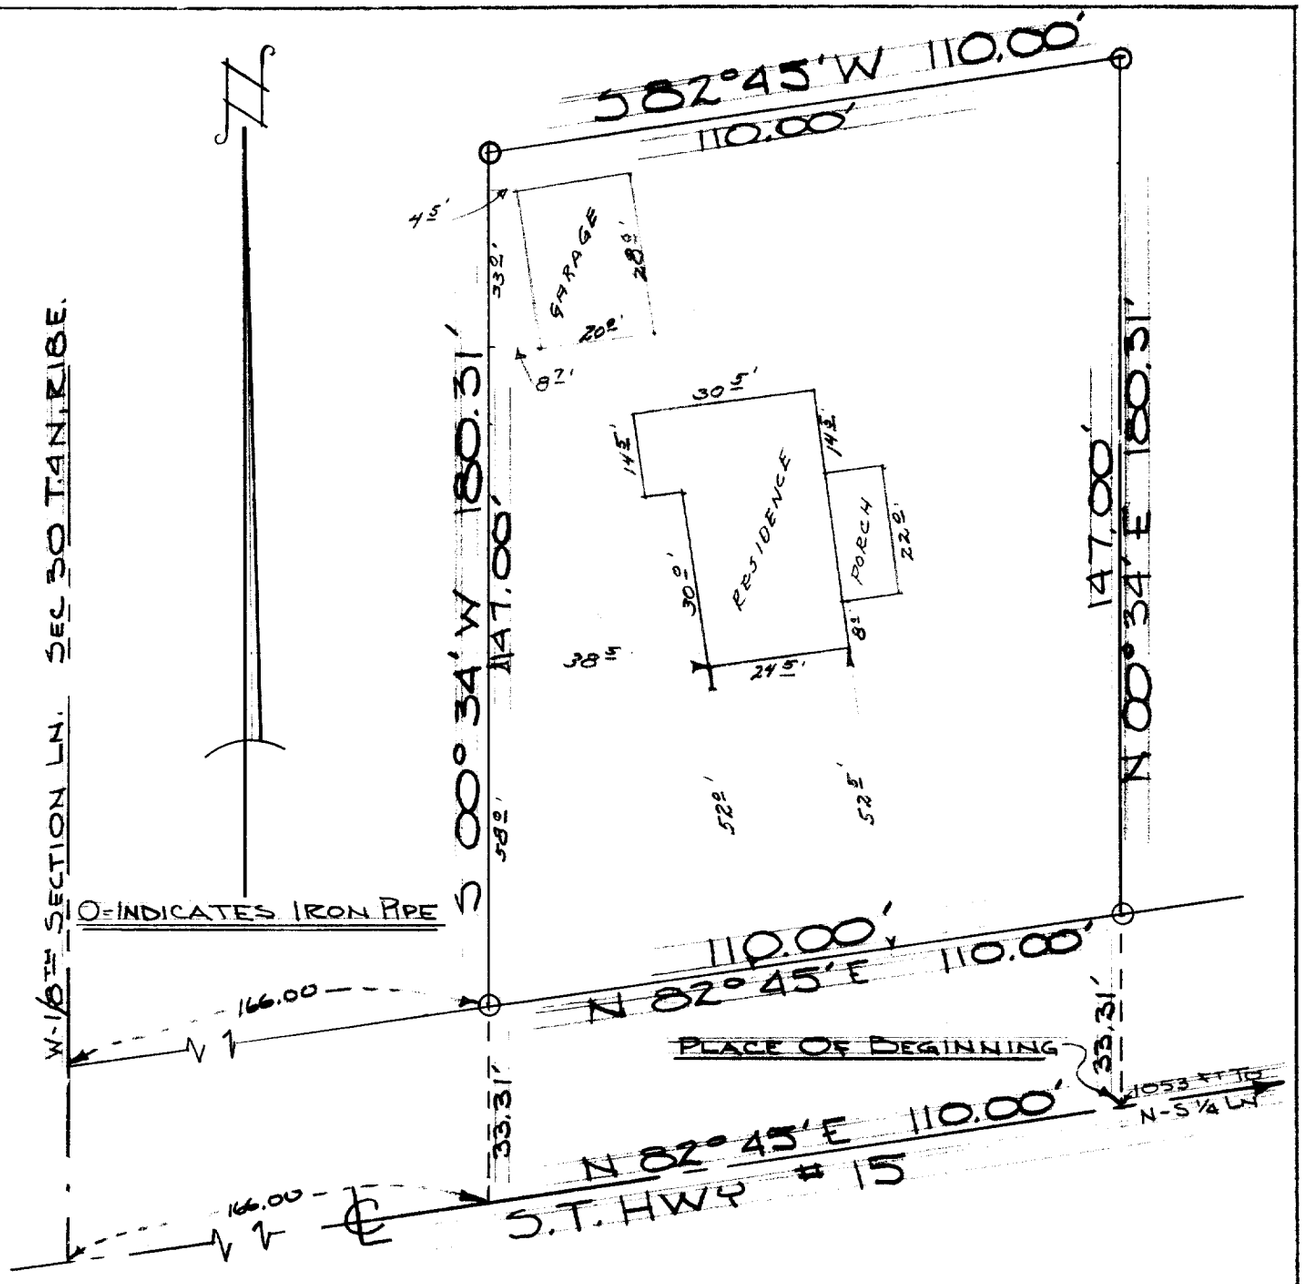


**DESCRIPTION:** Commencing at the point of intersection of the Center line of S. T. Hwy. #15 and the N-S ¼ Section line of Section 30, T. 4 N., R. 18 E. Walworth County, Wisconsin; thence S. 82° 45' W. 1053.00 feet to the place of beginning of the lands hereinafter described: thence N. 00° 34' E. 180.31 feet, thence S. 82° 45' W. 110.00 feet, thence S. 00° 34' W. 180.31 feet to a point in the center line of said highway, thence N. 82° 45' E. 110.00 feet to the place of beginning.

CERTIFICATE: I, James F. Biagi, surveyor, do hereby certify that I have surveyed the property hereon described.

May 31, 1966.

James F. Biagi R.L.S. 272

WISCONSIN JAMES F. BIAGI MILWAUKEE CO. REG. LAND SURVEYOR

UP-107 (part of)

3-11B