
PLAT OF SURVEY

COMMENCING AT A POINT IN THE NORTH LINE OF LOT 3, BLOCK 11, VILLAGE OF EAST TROY, 46 FEET WEST OF THE NE CORNER OF SAID LOT 3, RUN THENCE SOUTH PARALLEL WITH THE EAST LINE OF SAID LOT TO THE SOUTH LINE OF SAID LOT, THENCE EAST ALONG THE SOUTH LINE OF SAID LOT 46 FEET TO THE SE CORNER OF SAID LOT THENCE NORTH ALONG THE EAST LINE OF SAID LOT TO THE NORTHEAST CORNER OF SAID LOT, THENCE WEST ALONG THE NORTH LINE OF SAID LOT 46 FEET TO THE POINT OF BEGINNING.

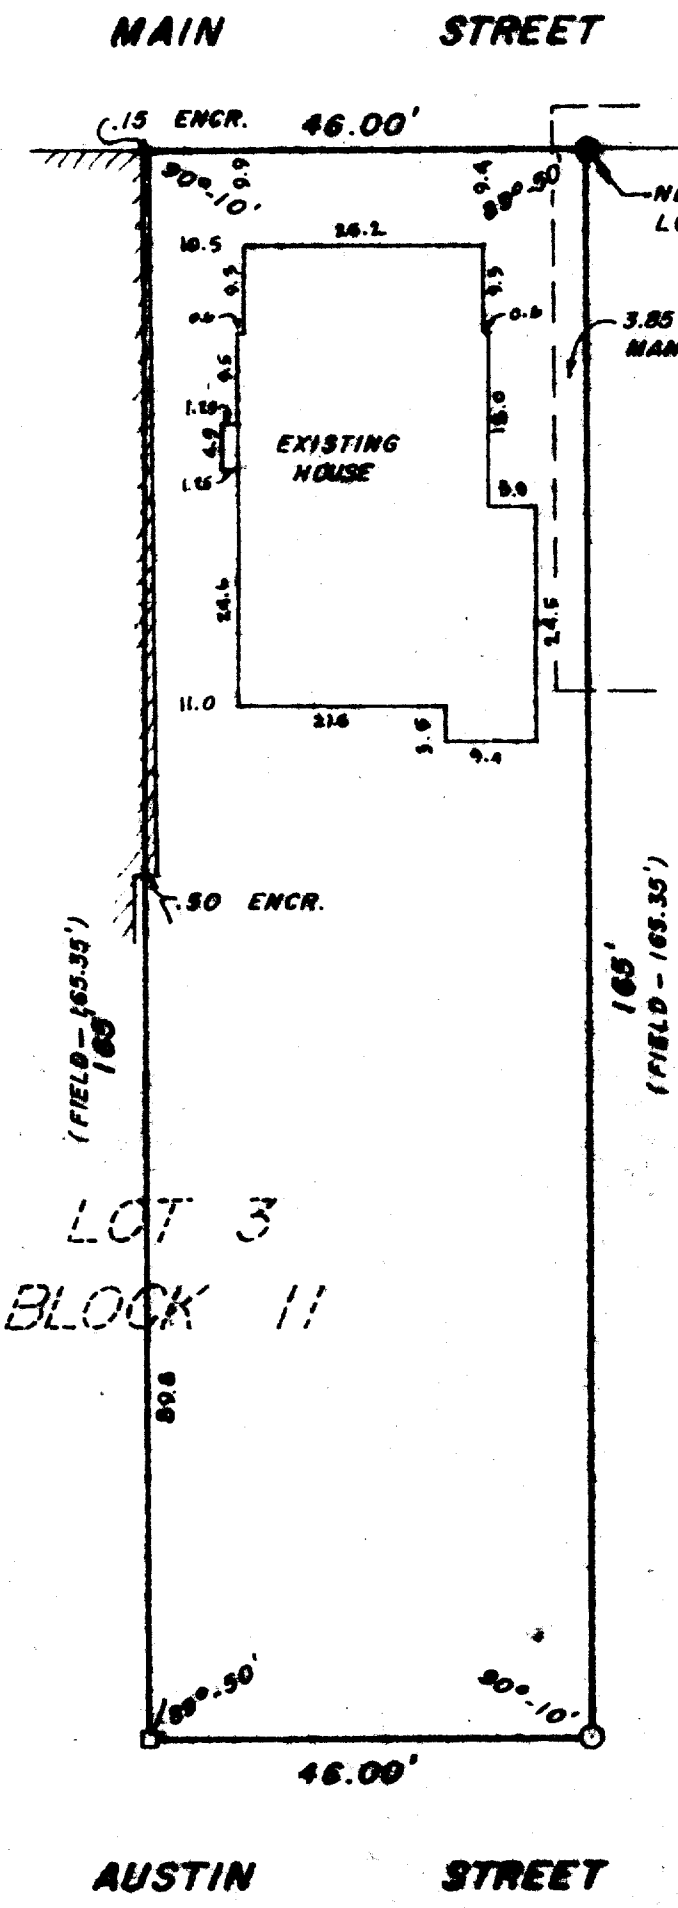

--- LEGEND ---

○ DENOTES FOUND 2" DIA. IRON PIPE

● DENOTES FOUND 1" DIA. IRON PIPE

□ DENOTES CHISELLED "+" IN CONCRETE

SCALE: 1" = 20'

JOB NO. 7704

DATE: JULY 13, 1977

FOR: C-MAC BUILDING
CHURCH ST. AND MAIN ST.
EAST TROY, WI

SURVEYOR'S CERTIFICATE

I HEREBY CERTIFY THAT THE LANDS DEPICTED HEREON HAVE BEEN SURVEYED UNDER MY DIRECTION AND THAT THE PLAT HEREON DRAWN IS A CORRECT REPRESENTATION OF SAID SURVEY.

DONALD C. CHAPUT
LAND SURVEYOR S-1316
SALEM, WI

WISCONSIN DONALD C. CHAPUT S-1316 SALEM, WISCONSIN LAND SURVEYOR

OP-107

3-163