
Plat of Survey

Known as Douglas Avenue, in the Village of East Troy, Wisconsin
Lot 48 in TROYJEN'S SUBDIVISION, being a Subdivision of a part of the NW 1/4 and the SW 1/4 of Section 19, T 4 N, R 18 E, in the Village of East Troy, Walworth County, Wisconsin.

AUGUST 3, 1977

SURVEY NO. 140273-M

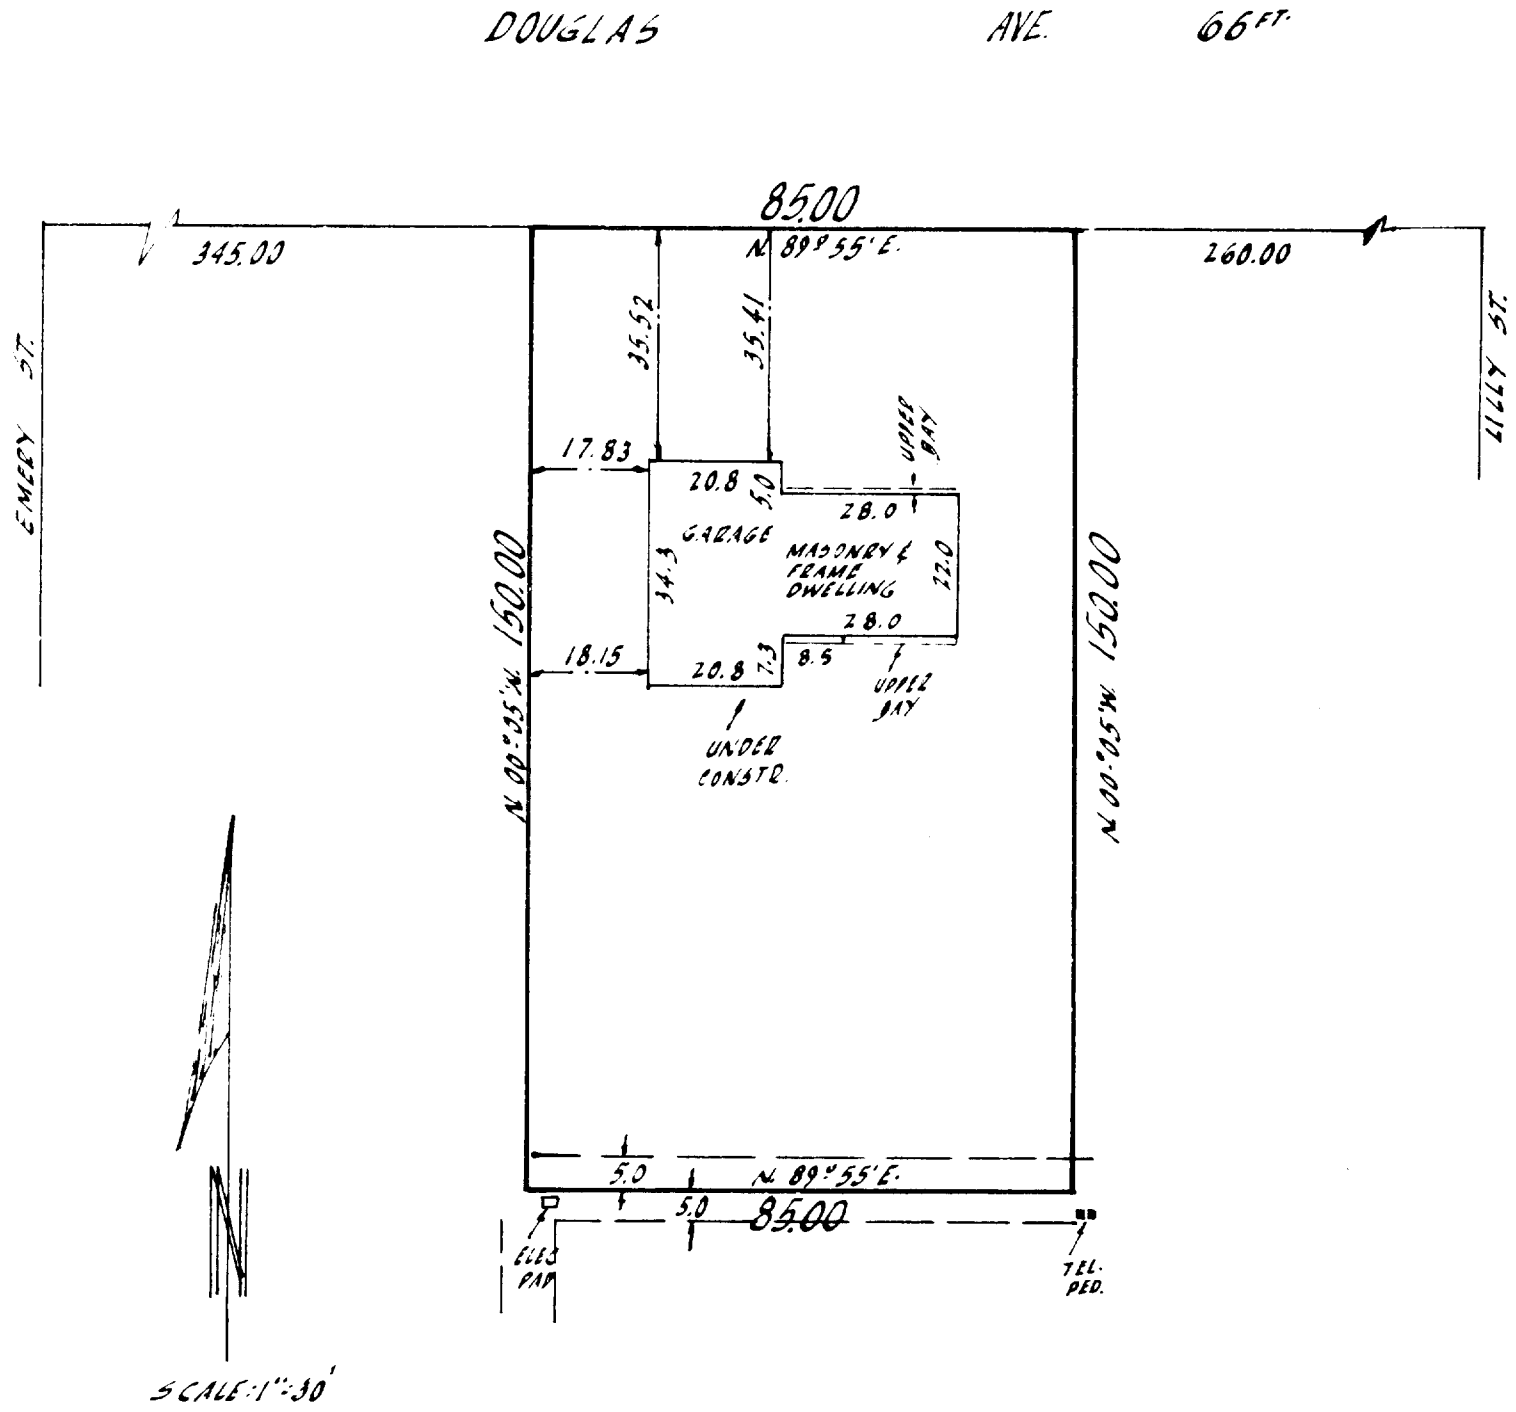

I Certify that I have surveyed the above described property (Property), and the above map is a true representation thereof and shows the size and location of the Property, its exterior boundaries, the location and dimensions of all visible structures thereon, boundary fences, apparent easements and roadways and visible encroachments, if any.

This survey is made for the exclusive use of the present owners of the Property, and also those who purchase, mortgage, or guarantee the title thereto, within one (1) year from date hereof.

Kenneth E Berke
SURVEYOR

WISCONSIN
KENNETH E. BERKE
S-107
BROOKFIELD WIS
LAND SURVEYOR

national survey & engineering
3470 north 127th street • p.o. box 444 • brookfield, wisconsin, 53005 • phone 414 / 781-1000

3-167