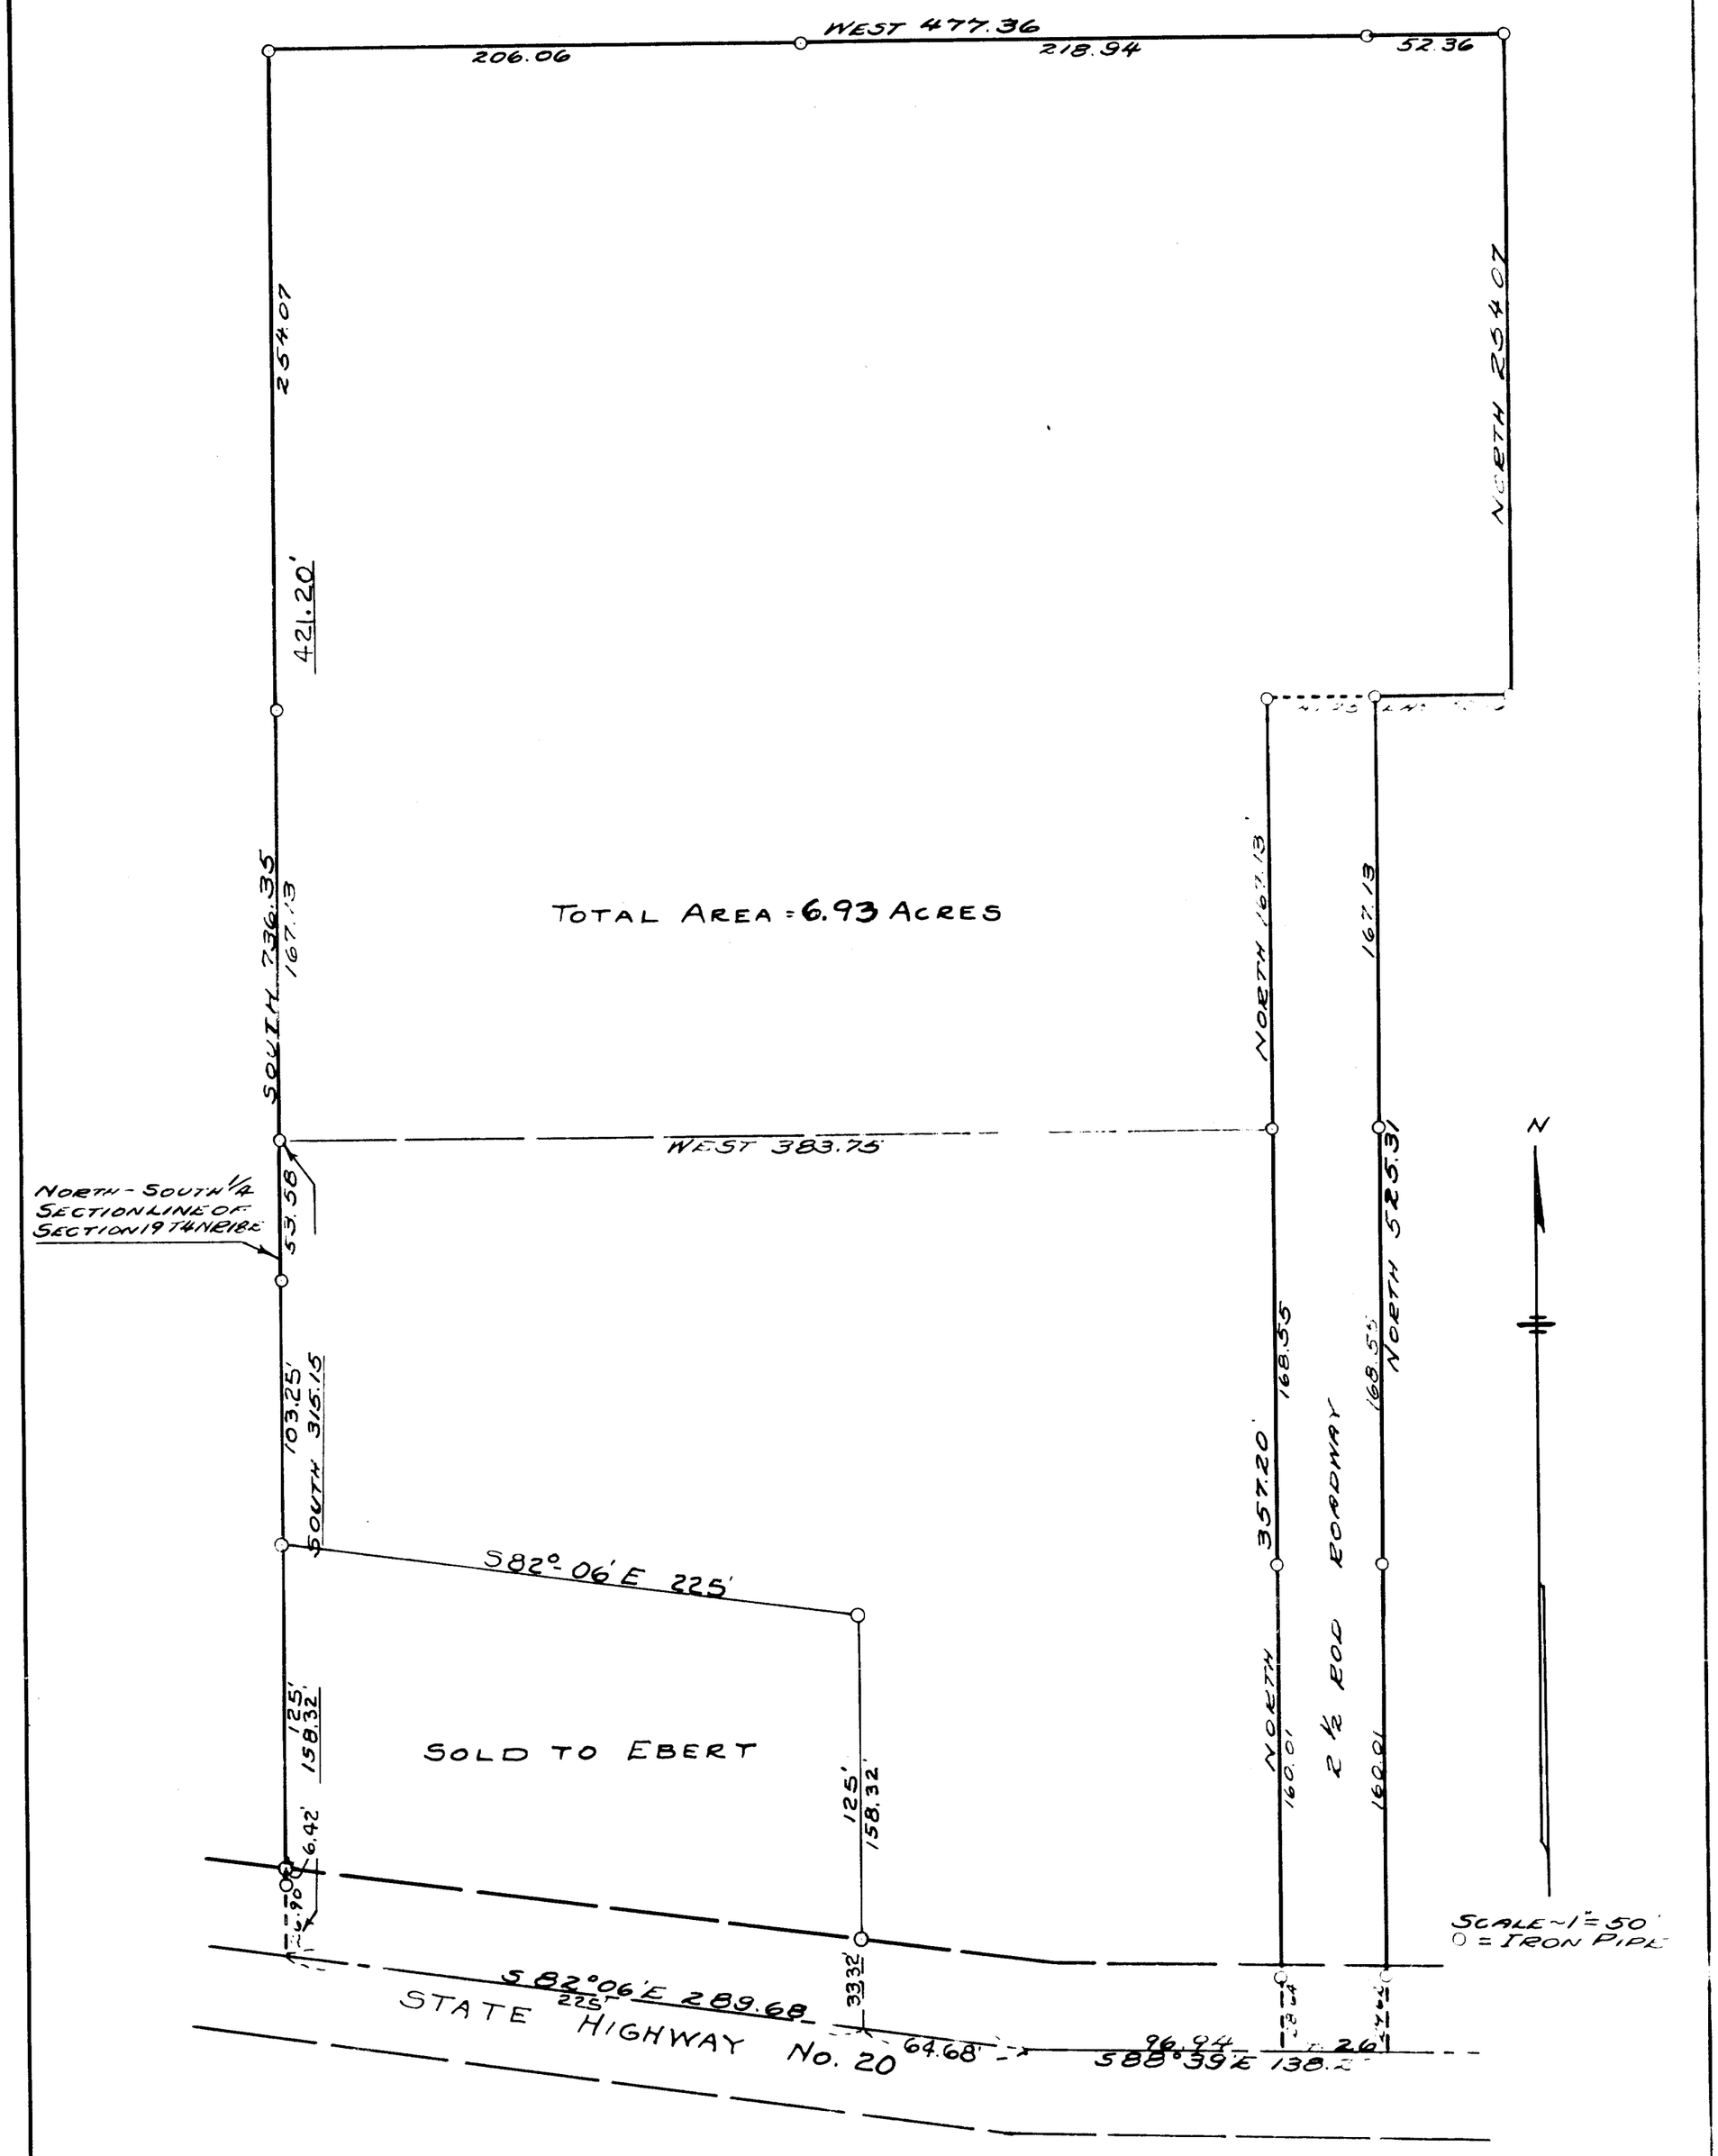


PLAT OF SURVEY OF LAND LOCATED IN THE EAST ONE HALF OF SECTION 19 T4N R18E IN THE VILLAGE OF DELAVAN, WALWORTH COUNTY, WISCONSIN.

FEBRUARY 12, 1941
REVISED JULY 31, 1951
Floyd L. Jensen
REVISED JUNE 4, 1969

Floyd L. Jensen
COUNTY SURVEYOR

3-17

P/UP-21